


50/1stoga
nr 28A

Samþykkt á fundi bygginga-
nefndar þ. 30 / 3 1989

BYGGINGAFULLTRÚINN
LÍHAFNARFIRDI

[Signature]

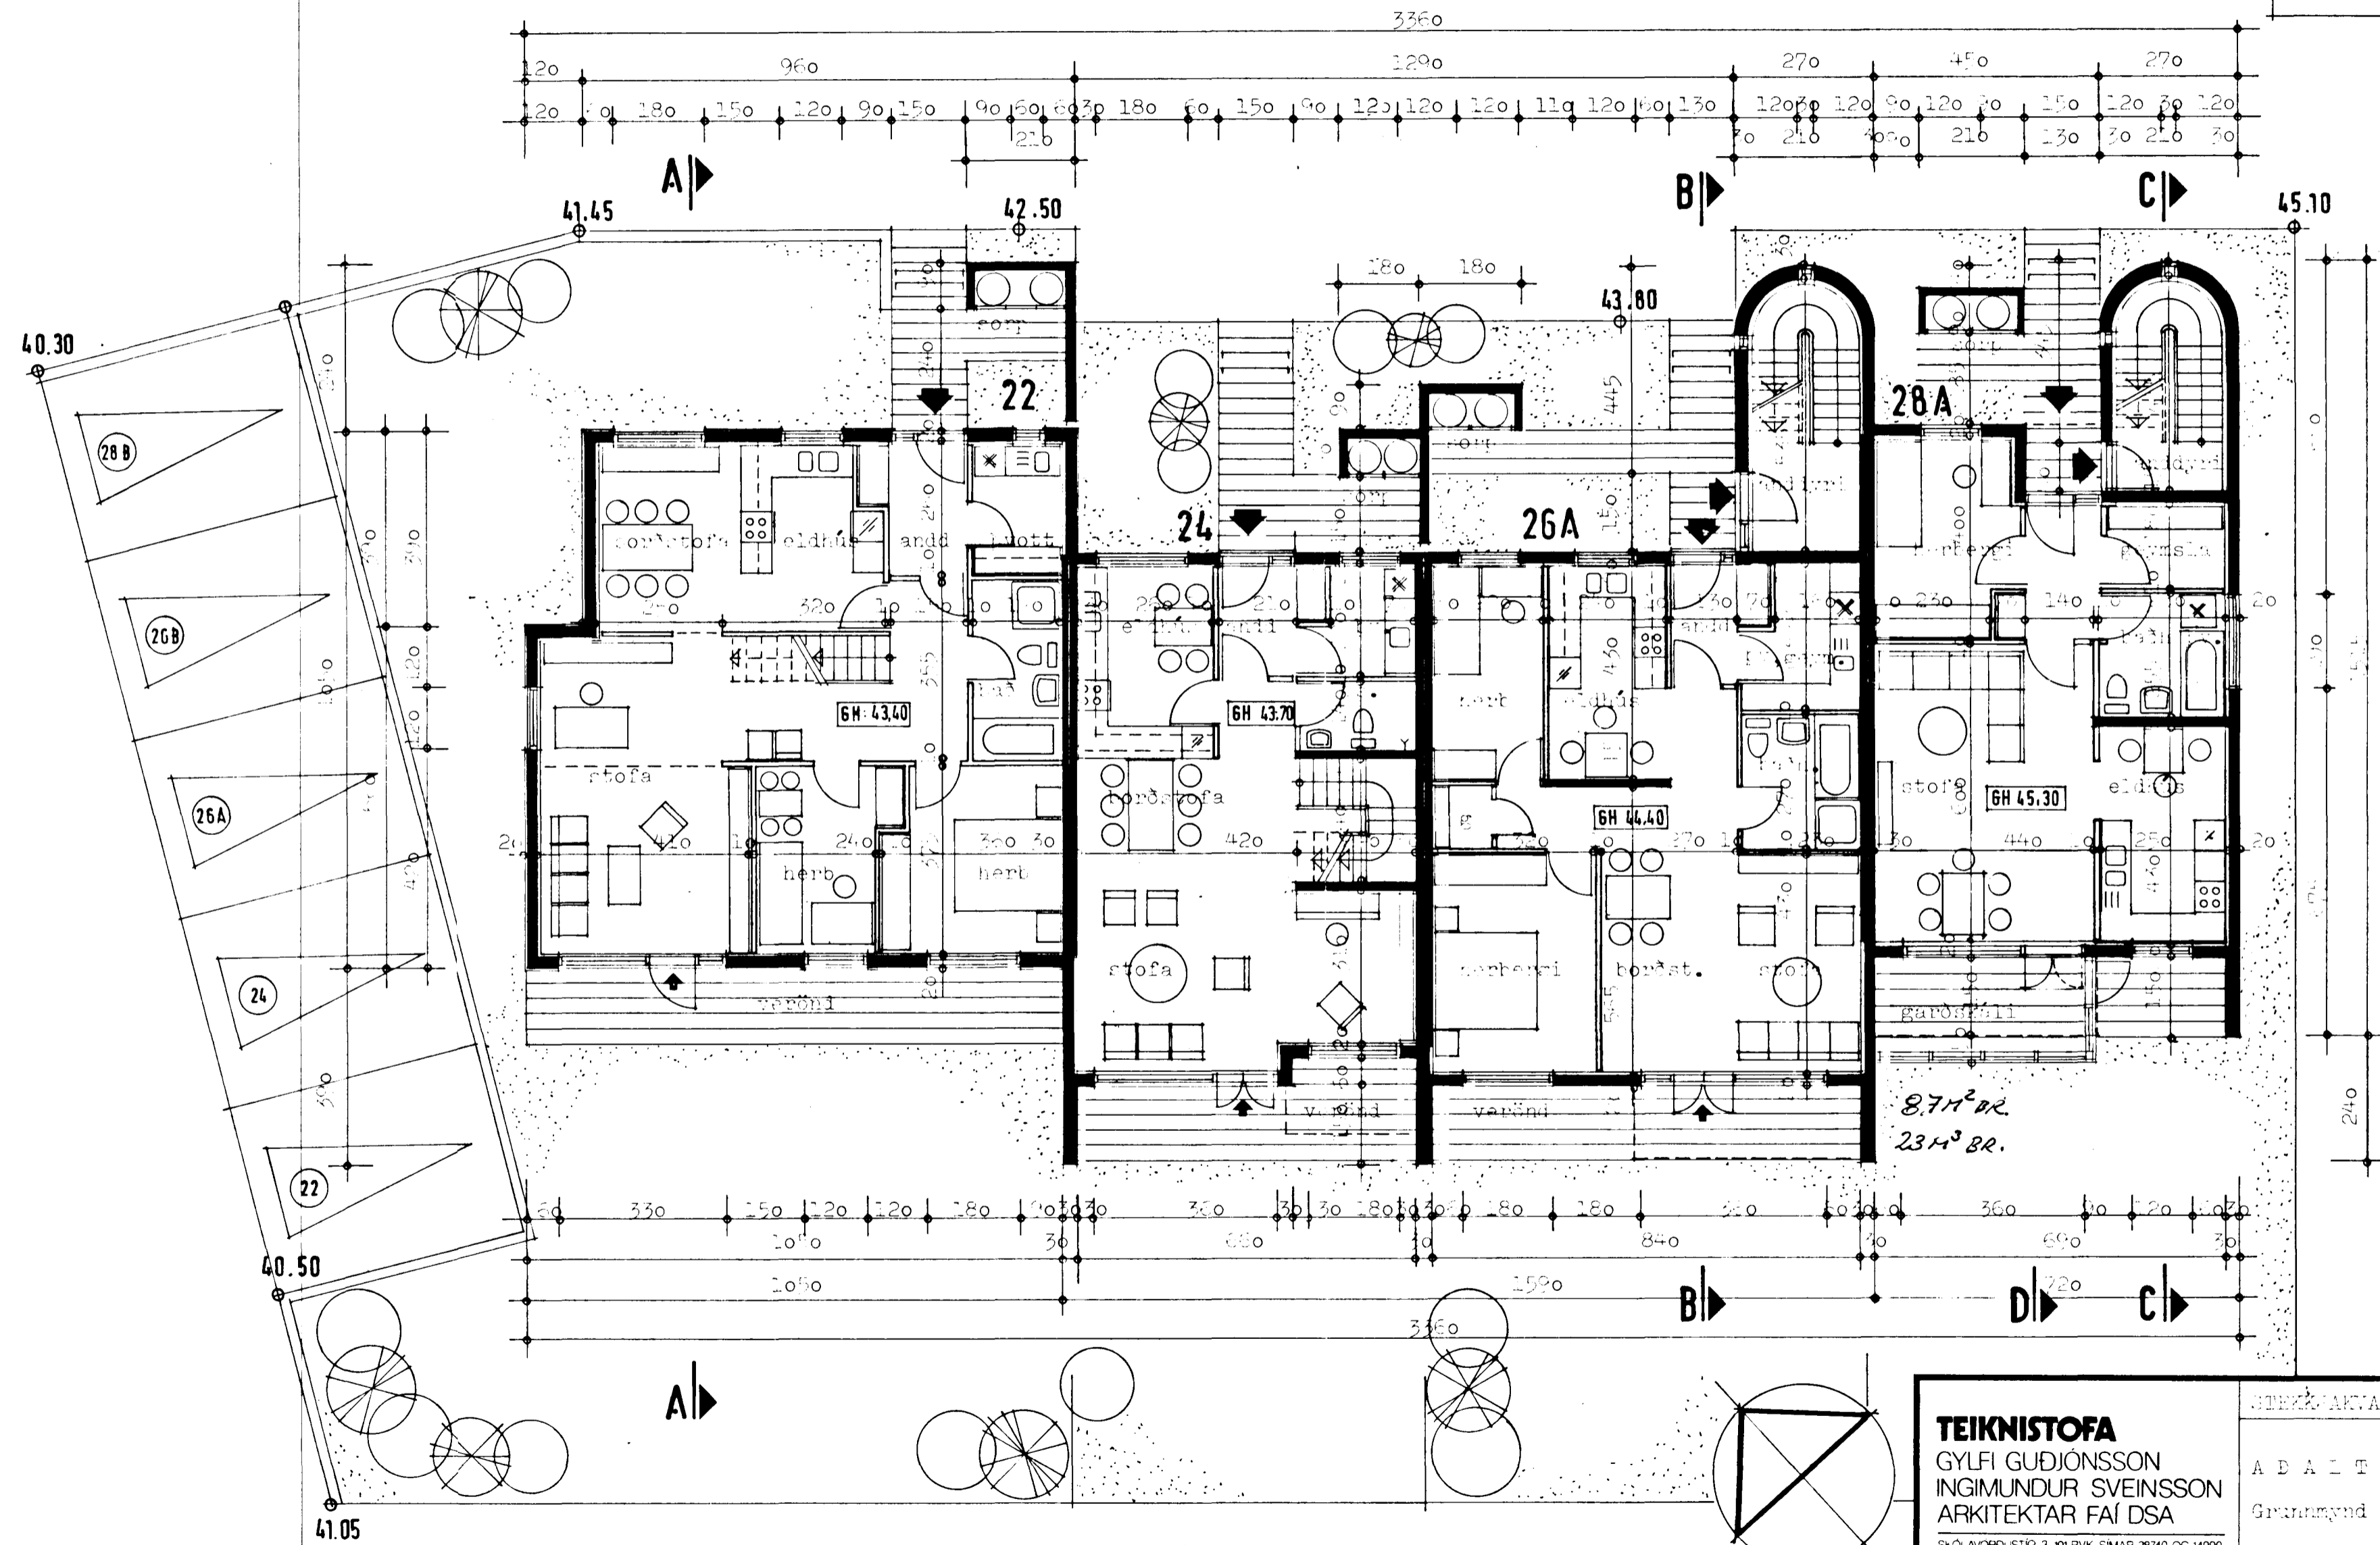

TEIKNISTOFA		STEEKJAKVANDUR 22-28, HAFNARFIRDI.	
GYLFI GUÐJÓNSSON		VERK 82-103	
INGIMUNDUR SVEINSSON		BLAD 101	
ARKITEKTAR FAI DSA		Grannmynd L. læfar	
SKO. AVCHD. STÍÐ 3, 101 RVK. SIMAR 28740 OG 14990		HANNAÐ: 19.10.87 TEIKNAD: 19.10.87 REYKJAVIK: 19.10.87 BREYTT: 28.02.89 28.02.89 HVB, garðskáli íb. 28 A E. J. Jónsson	