


KERFI ~ 1:50

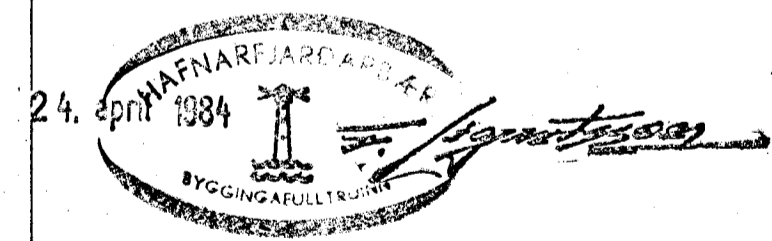

SKÝRINGAR SJA TEIKN. NR. 2.0

STEKKJARHVAMMUR 23. HFJ.	Mælikv. ~ 1:50	Verk 8105	Teikn. nr. 22
FRÆRENNISLISLOGN KERFI	Hannað: <input checked="" type="checkbox"/> Teiknað: <input checked="" type="checkbox"/>	Yfirfarið: <input checked="" type="checkbox"/> Samp: <input checked="" type="checkbox"/>	Dags. FEB '82
VERKFRÆÐIÞJÓNUSTA JÓHANNIS G. BERGDÓRSSONAR h/f.			
VERKFR. MVFI		HAFNARFIRÐI - Símar 53315 OG 50241	

BREYTT APRIL '84