


Skjal 102 & fundi bygginga-
ráðs nr. 23/2 1982
BYGGINGARULLINGAN
Í HAFNARFIRDI

S. Jónsson

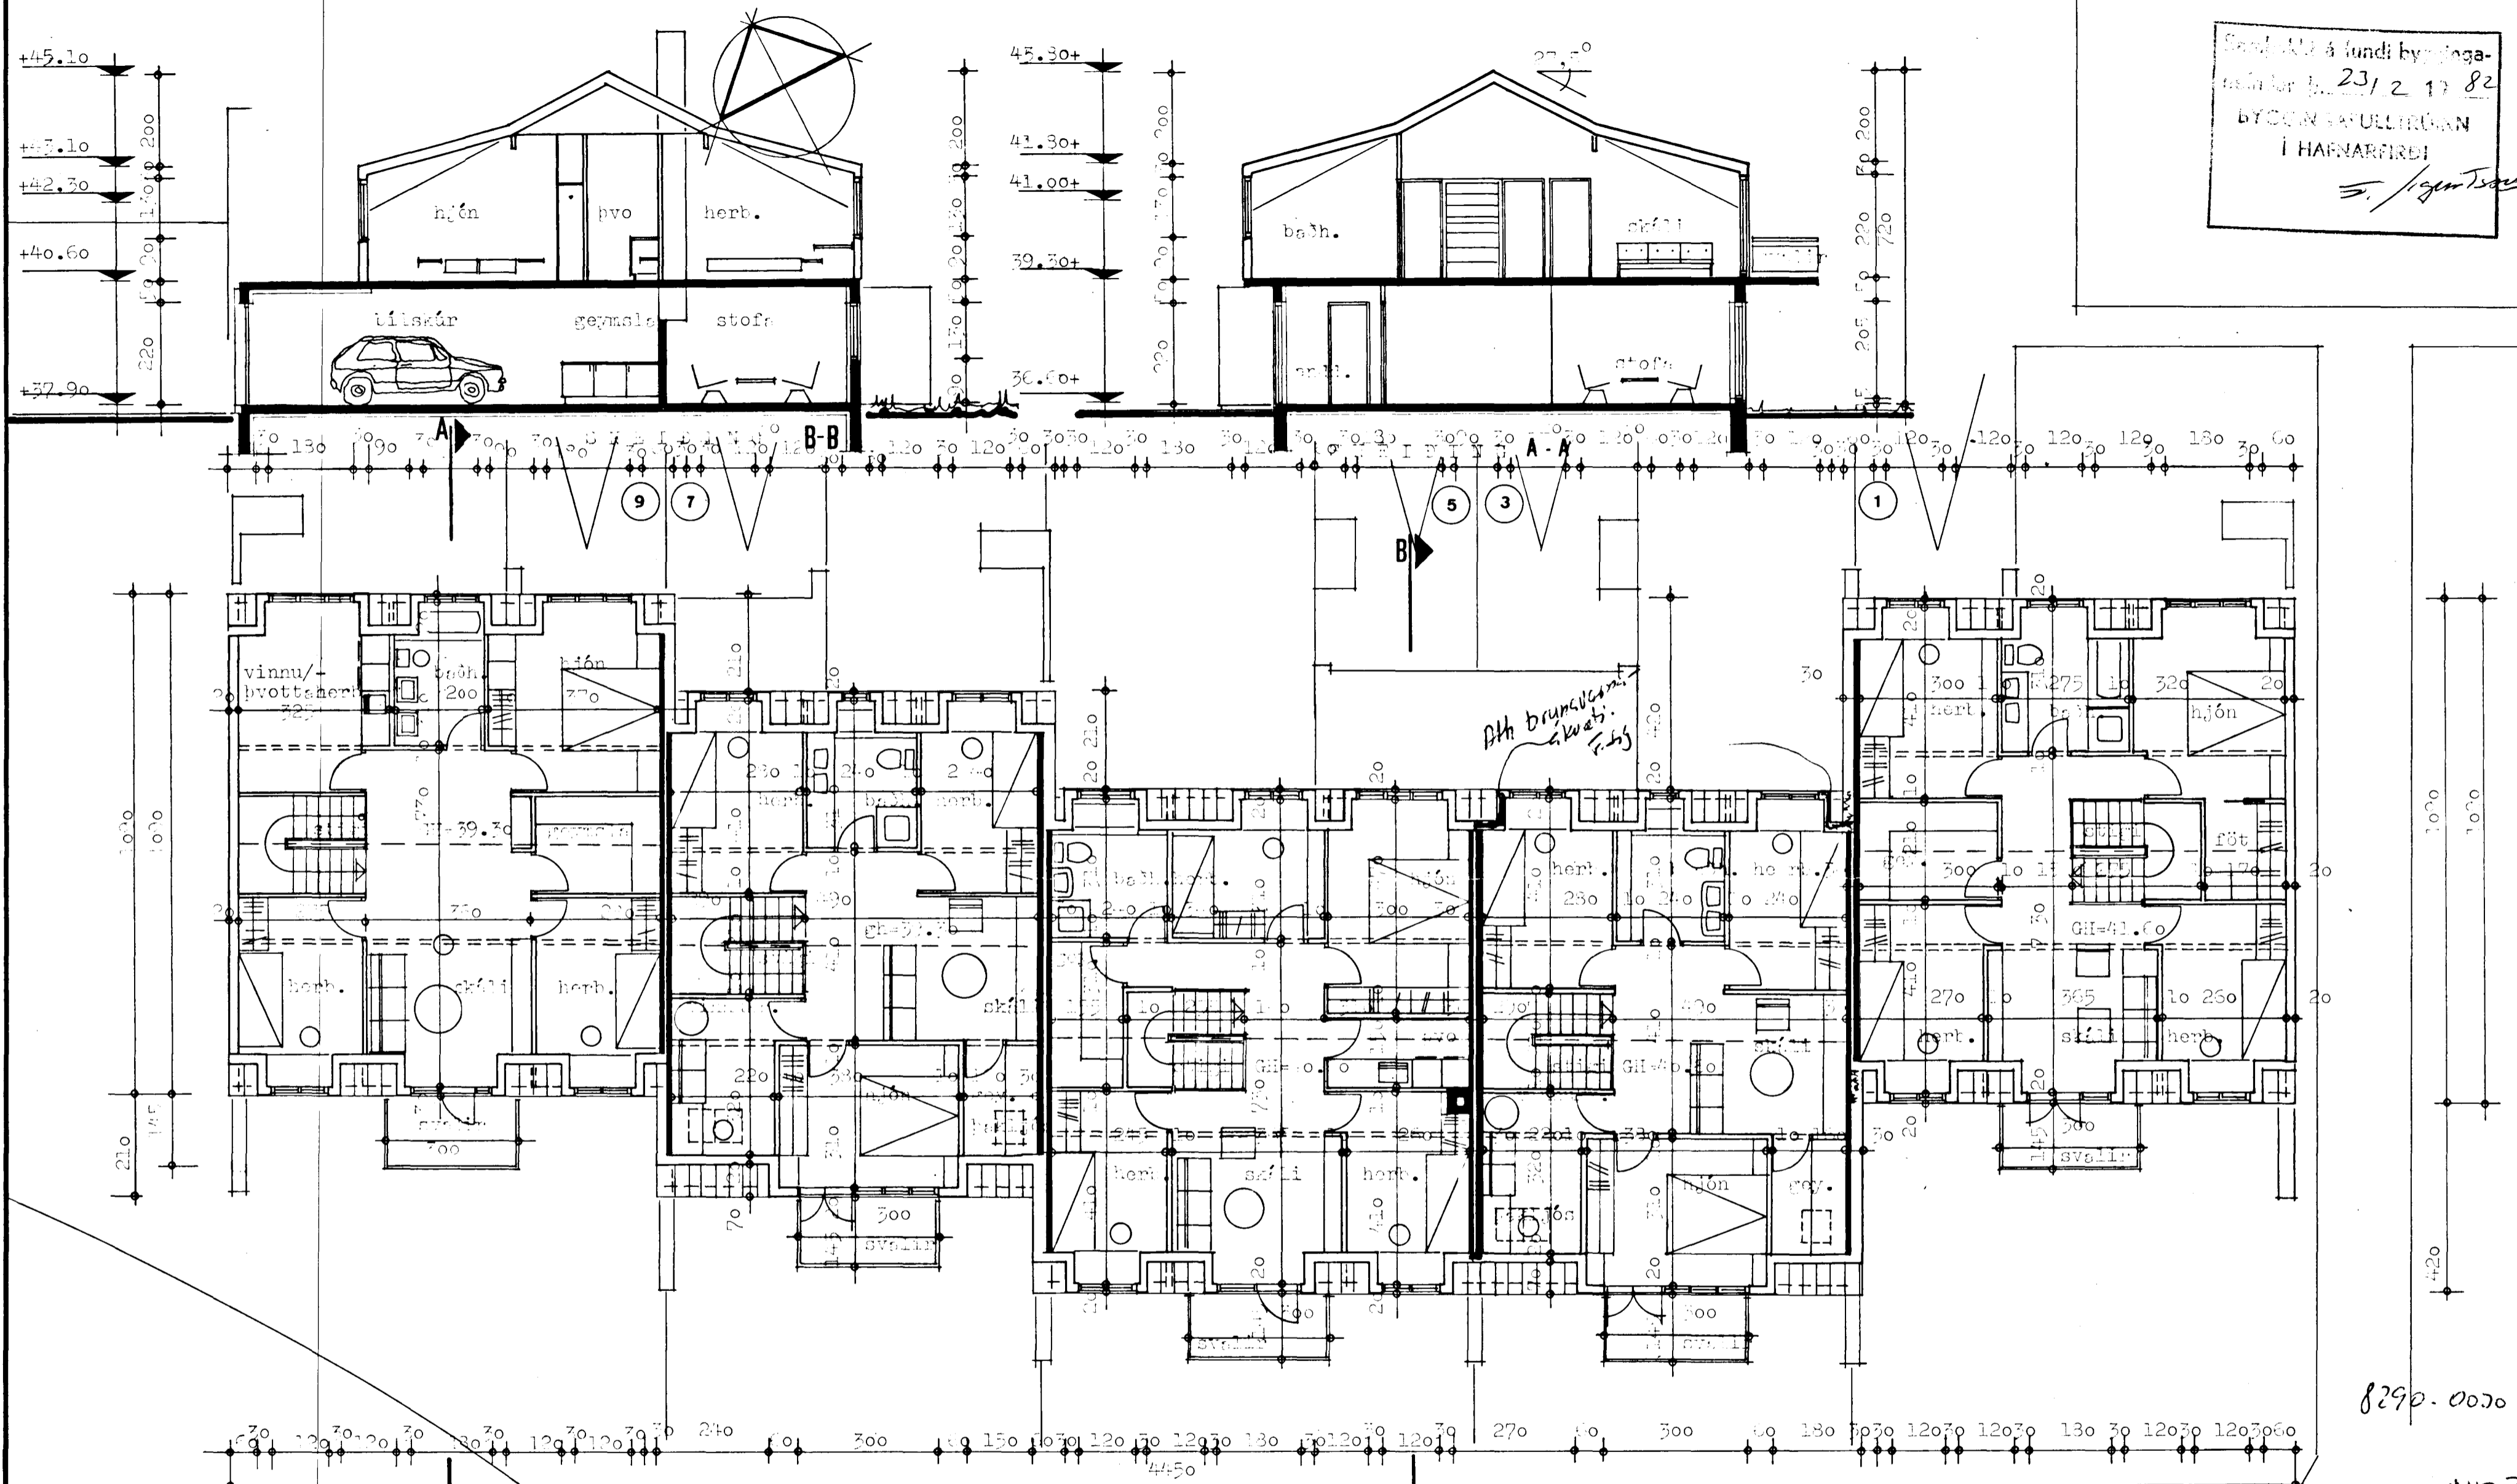

8290-0070 01

M23

TEIKNISTOFA		REYKJANINGARVIR 1-9, Hafnarfirði	
GYLFI GUÐJÓNSSON		A P A T E I N N I N G	
INGIMUNDUR SVEINSSON		grunnmynd ris	
ARKITEKTAR FAI DSA		smíðingar	
SKÓLAVORDUSTÍG 3, XI RVK SIMAR 28740 OG 14990		VERK 91-102	
HANNAÐ	TEIKNAD	REYKJAVIK	1981-10
BY. 1a	hb	BREYTT	1982-01 hb
KVARDI	1:100	