


KUMMYND 4.50

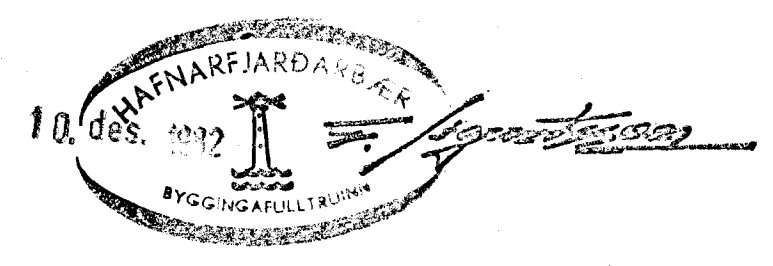

Breytt 3/12 192

STEKKJARHVAMMUR 7 HAFNARFIRÐI		DAGS	8207 19
KUMMYND HITALAGNA		REKNU	510
MALKV 1.5		TEIKU.	AY
SIGURÐUR ÞORLEIFSSON TEKNIFRÆÐINGUR F.T.F.I		VERK NR.	8205
STRANDGÖTU 11 HAFNARFIRÐI SIMI 54751		TEIKU NR.	10