


GRUNNMYND 1. SF

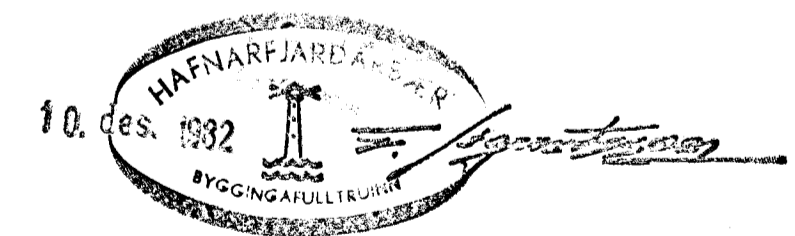

Breytt 3/12 '82 Lúðv

STEKKJARHVAMMUR 7 HAFNARF.	DAGS
HITA-VATNIS-OG FRÆMISLISLAGNIR	REIKN
EFRI HEB	TEKNI
MELKV 150	VERA VE 8205
SIGURÐUR ÞORLEIFSSON LAMFRÉÐINGUR	TEKNA NR
STRANDGÖTU 11 HAFNARFJÖRÐI SÍM. 5761	09