

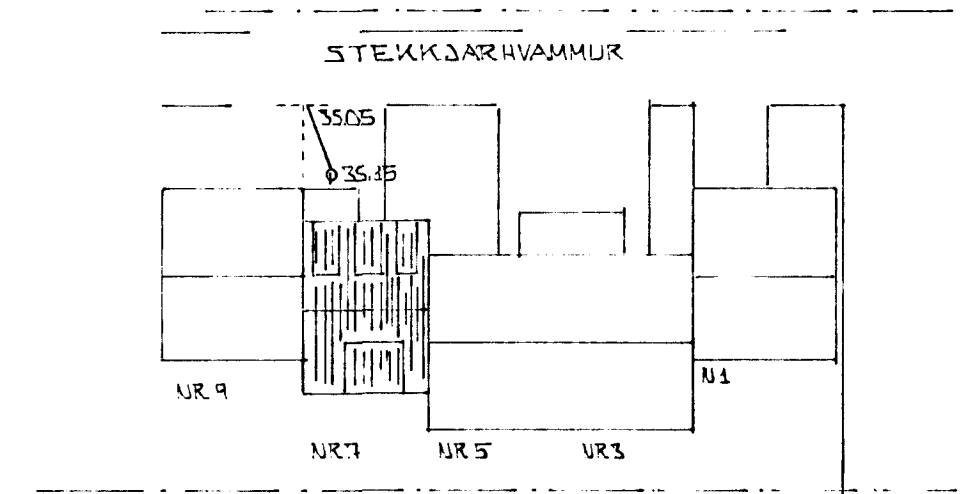


GRUNNMÝND 1:50

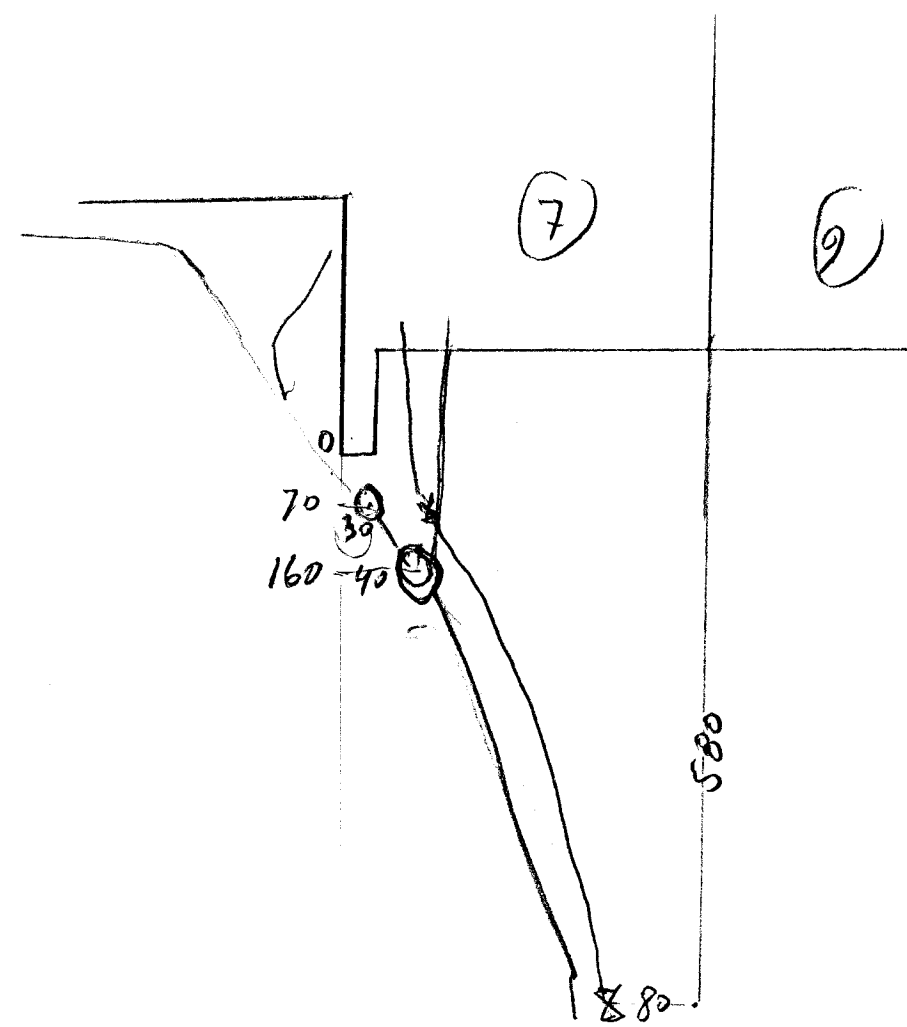

AFSTÖÐUMÝND 1:500

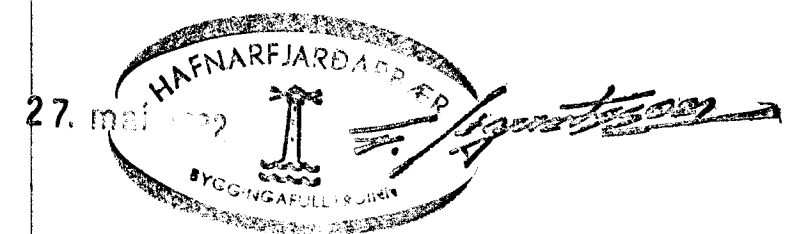

BR. 26 MAI 1982 5P

STEEKJARHVAMMUR 7, HAFNARFIRÐI.

FRARENNSLIS LAGNIR I GRUNNI

MÆLIKV. 1:50

SIGURÐUR ÞORLEIFSSON TEGNIFRÆÐ E.F.É.
STRANDGÖTU 11, HAFNARFIRÐI. Sími 54751

DAGS MARS 82

REIKN. *agur*

TEIKN. *es*

VERK NÚ. 8205

TEIKN. NÚ. 03