


SNEIÐING C-C

1:100

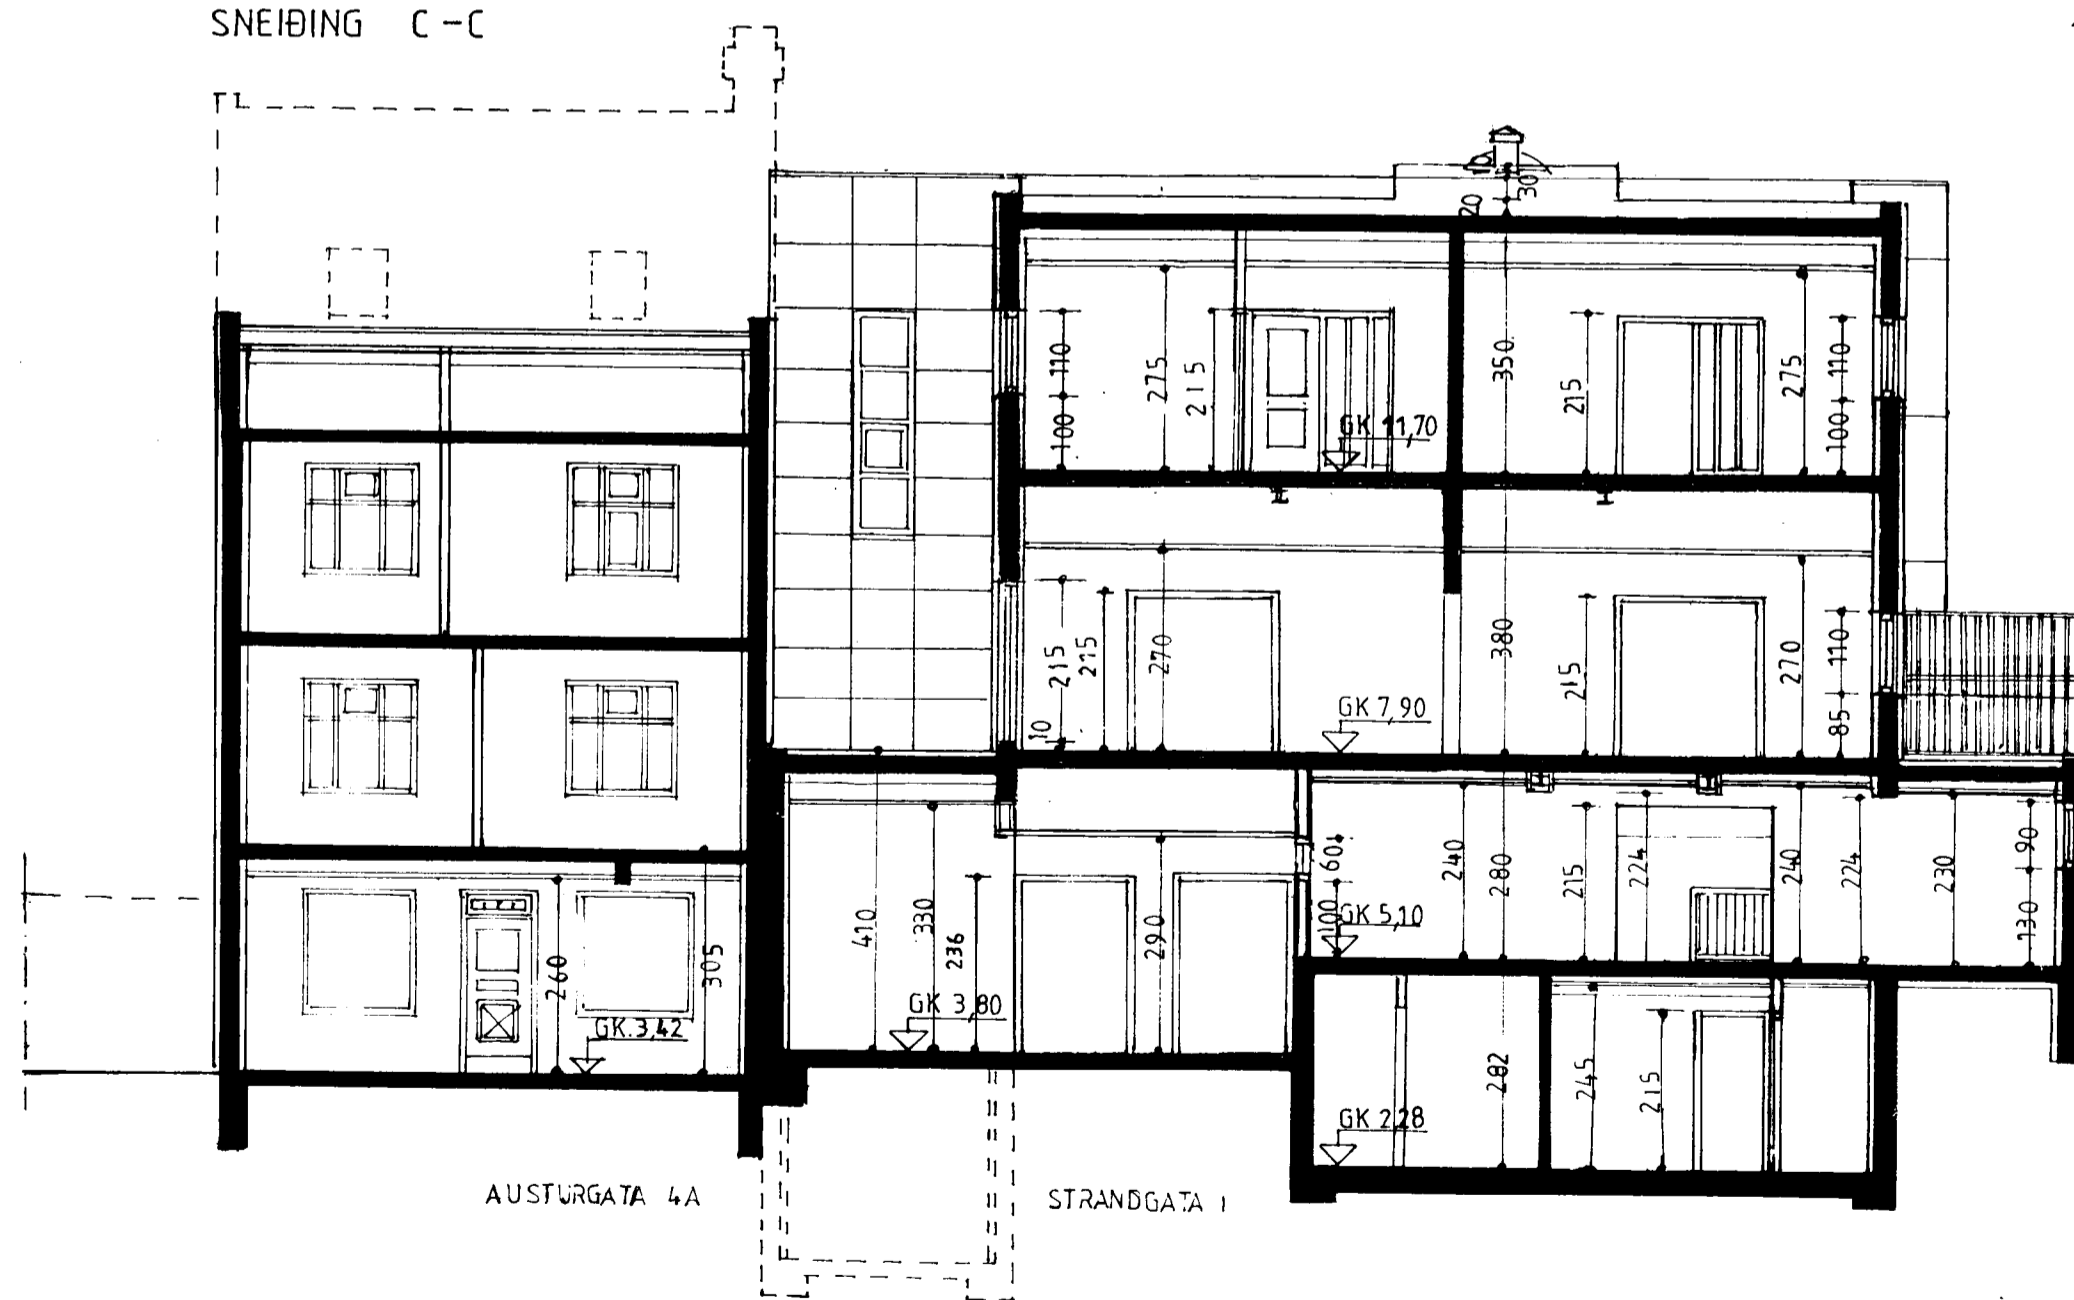

SNEIÐING D-D

1:100

BR. 29.4.2002 :

SKYGGMI Á ÚTVEGG 2 HÆÐAR MÓT
REYKJAVÍKURVEGI FJARLEGT.

BÓKASAFN HAFNARFJARÐAR, STRANDGÖTU 1
OG 1.HÆÐ AUSTURGÖTU 4 A

SNEIÐINGAR

TEIKN: PÖB/KJ

MKV: 1:100

DAGS: 21.08. 2000

BR. 29.04.2002
BR. 02.04.2002
BR. 21.03.2001
BR. 22.12.2000
BR. 20.11.2000
BR. 15.10.2000
BR. 07.10.2000
BR. 12.9.2000
BR. 6.9.2000

Pétur Örn Björnsson
PÉTUR ÖRN BJÖRNSSON ARKITEKT FAÍ
TEIKNISTOFA TÚNGÖTU 14, 101 REYKJAVÍK
KNÚTUR JEPPESEN ARKITEKT FAÍ

-S.5510160

06