
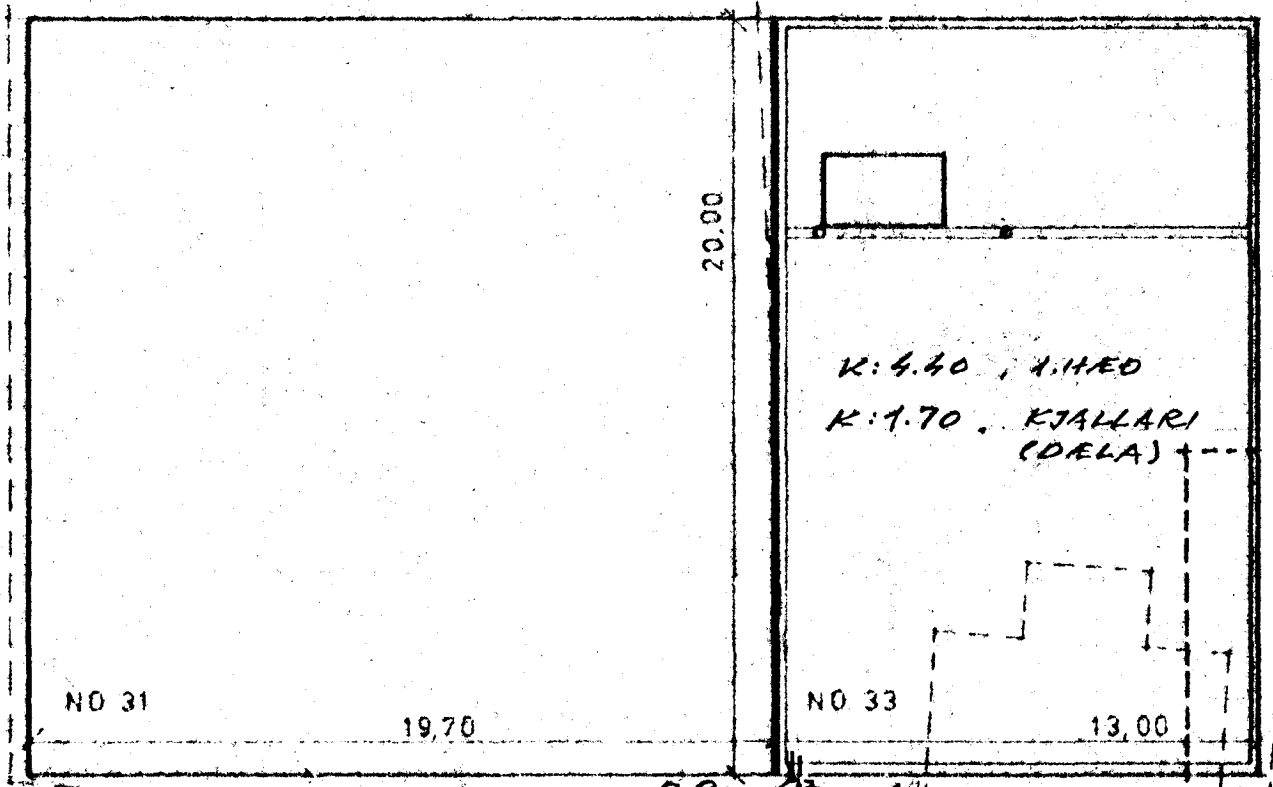


AUSTURGATA

BLAÐ 1 A

BÍLASTAÐI

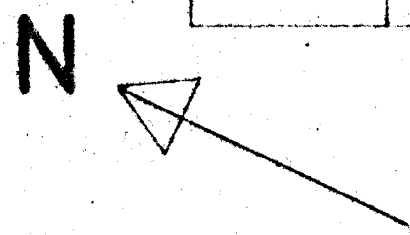

K: 4.40 - 1. HÆÐ  
K: 1.70 - KJALLARI (DELA)

NO 31

NO 33

13.00

20.00

19.70

2.80

LÓÐ NO 33

35

FRÆBENSLI  
150, 20'00


VATNSHEIMAD 40

○ STRANDGATA

2.60

KAUFFÉLAG

KVIKMYNDAHÚS

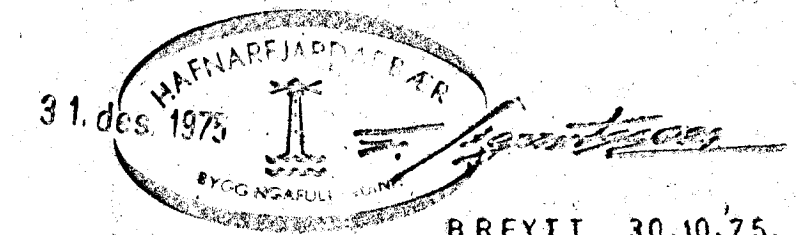

BREYTT 30.10.75.  
BREYTT 25.8.75.  
TEIKNAD UPP EFTIR SAMR. SKIPULAGSUPPDRÆTTI

SAMVINNUBANKINN  
STRANDGATA 33, HAFNARFIRÐI  
AFSTÖÐUMYND, VATN OG FRÆBENSLI

V 151601	V-018
M 1:200	17.11.1975
Teikn. M.F.	

Teiknistofa S.I.S.

