
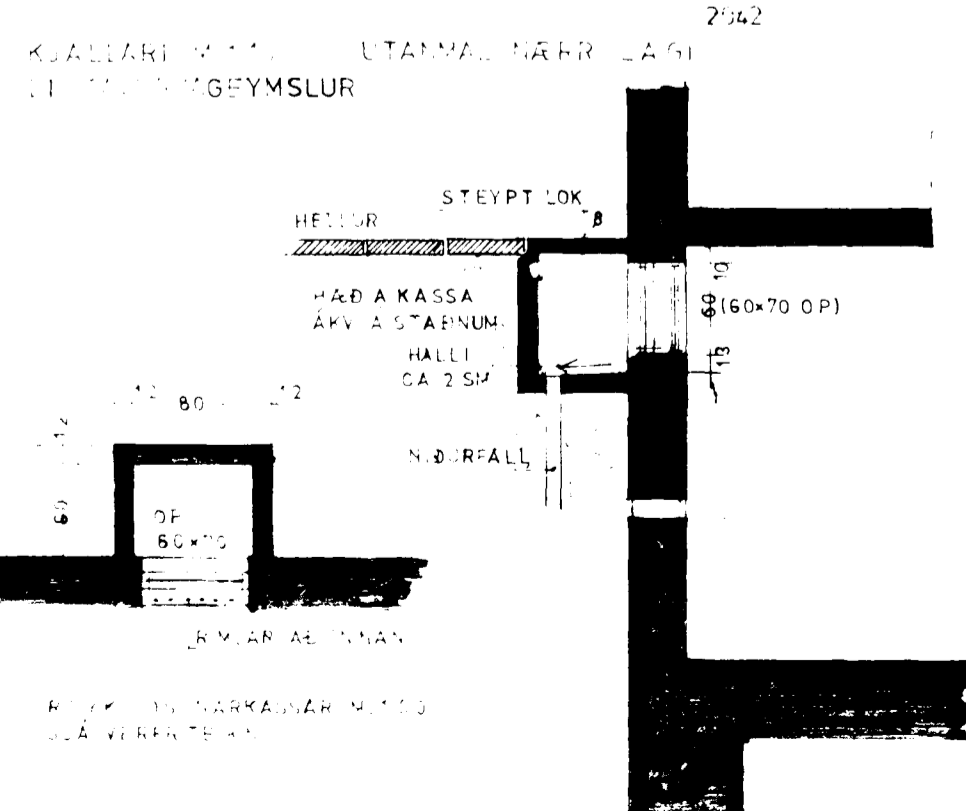
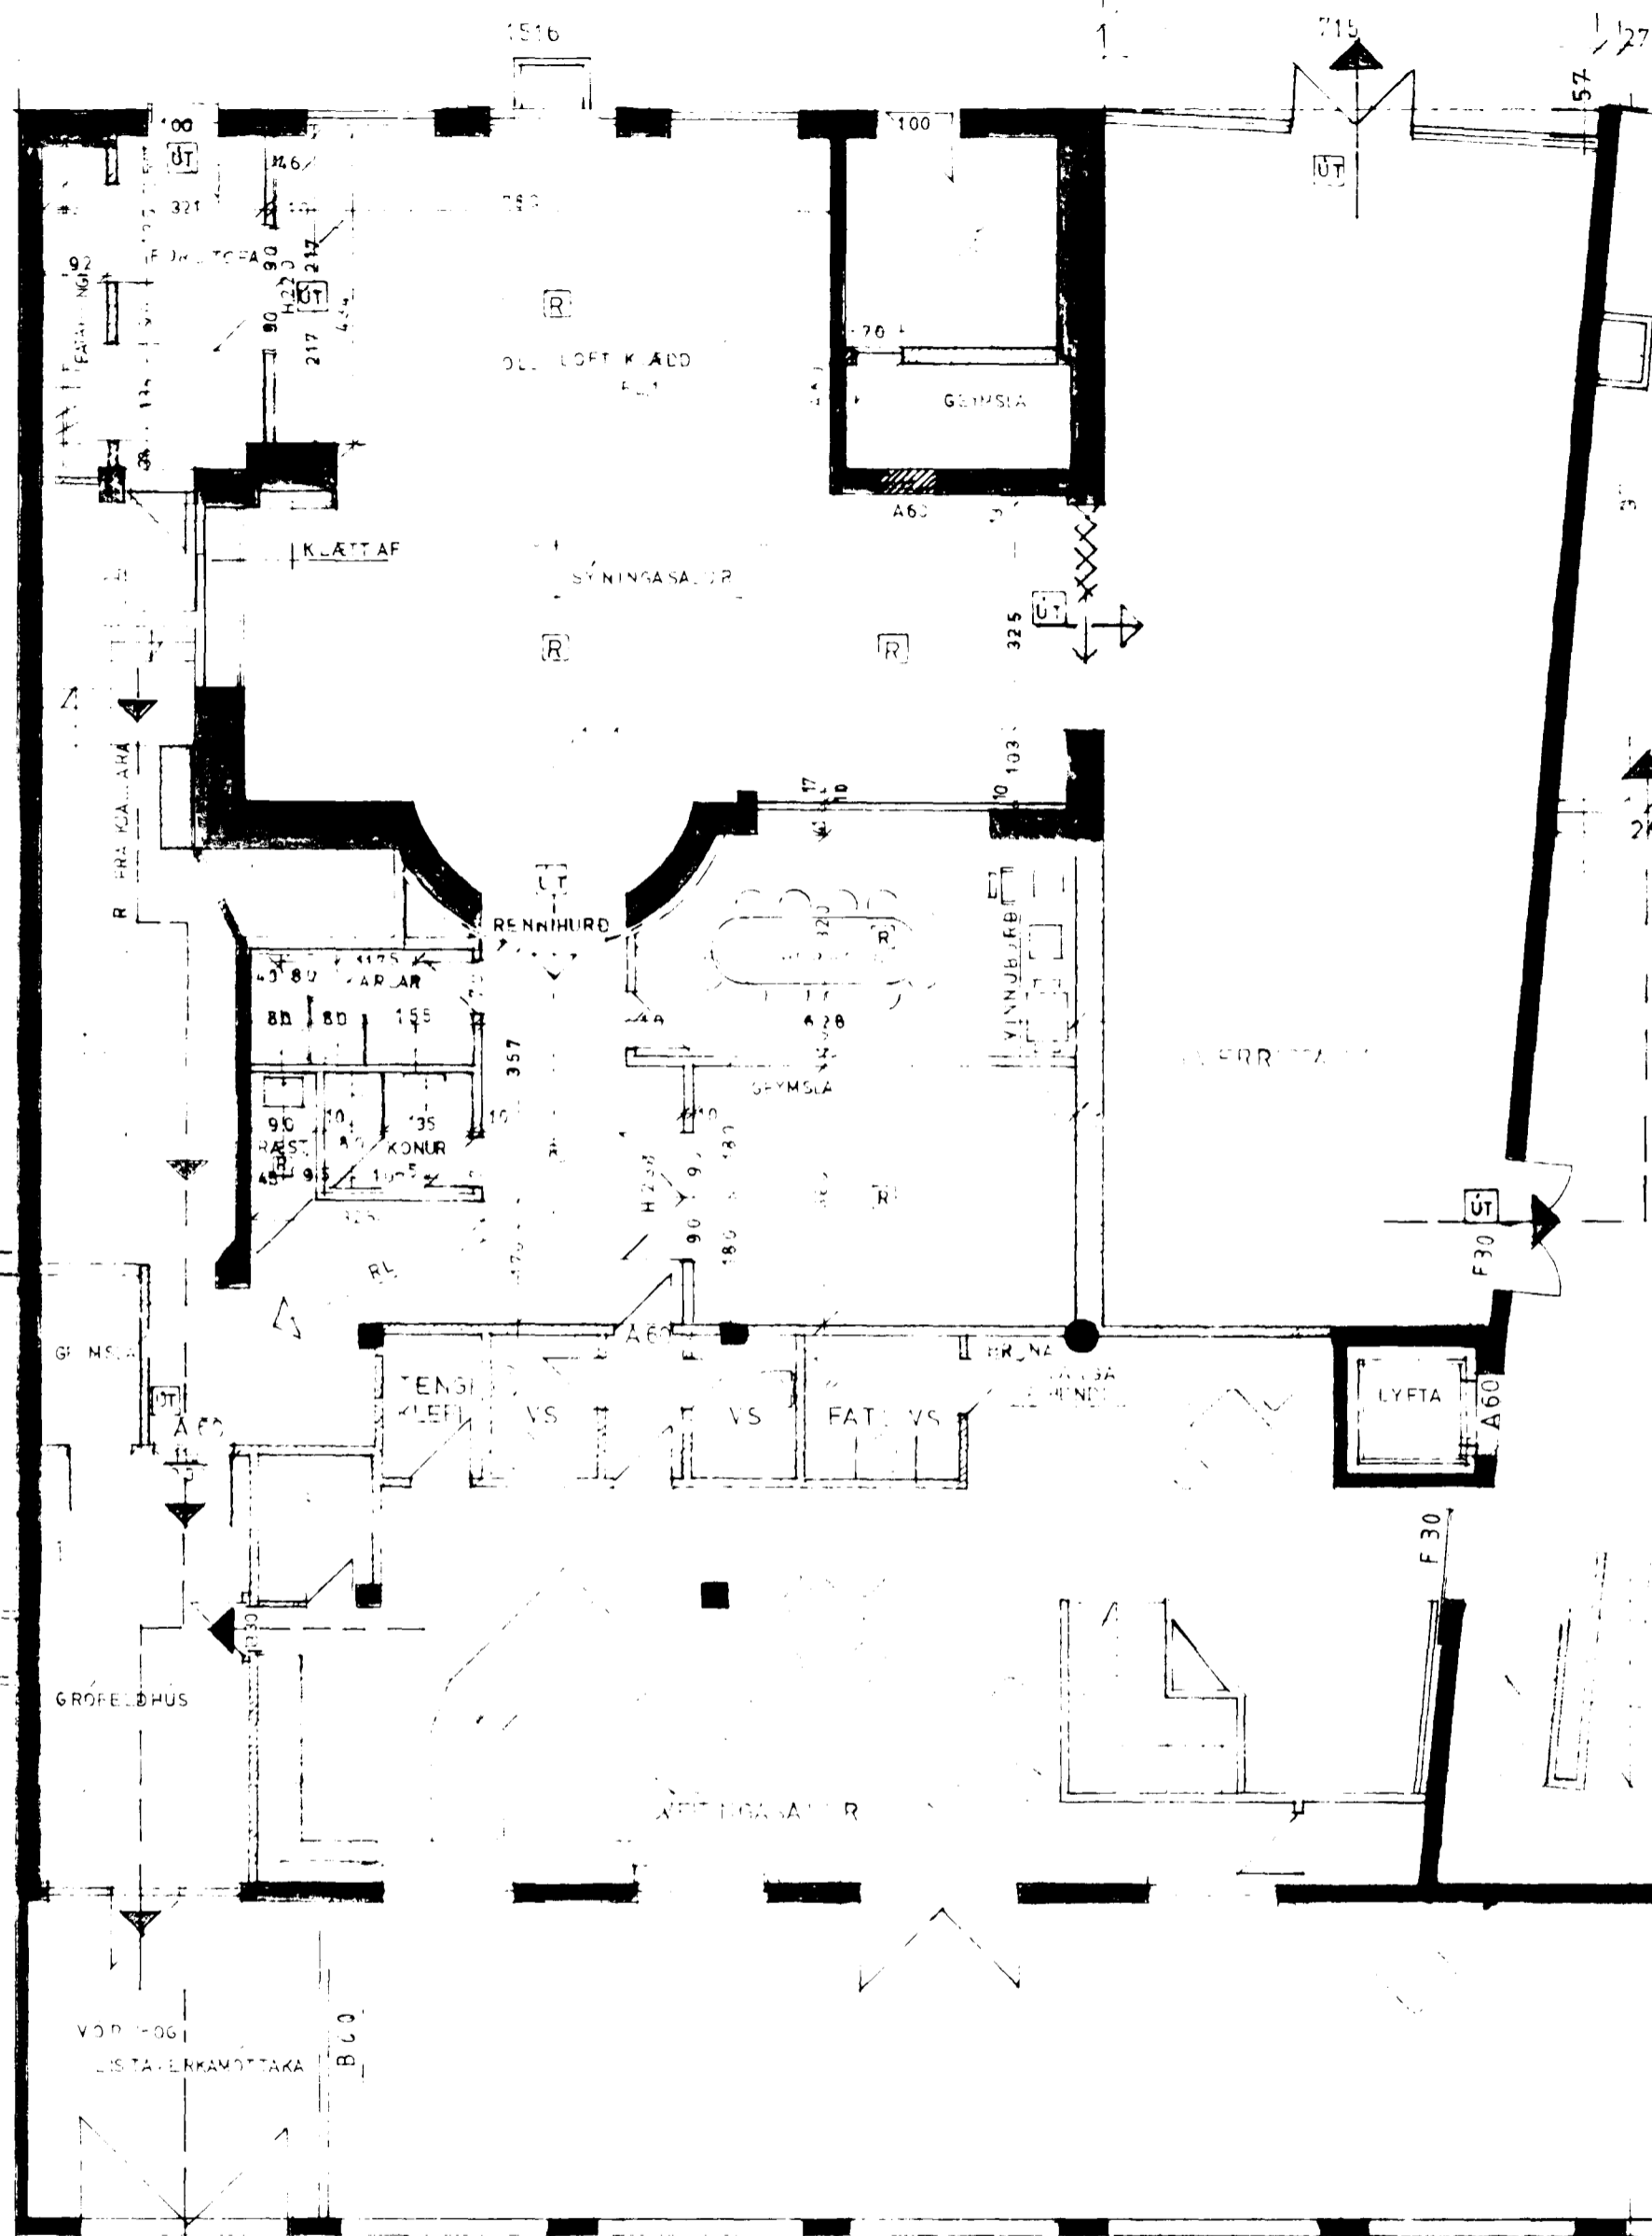


HAFNARBORG • STRANDGATA 34.
 VIÐBÓTARÝMI SAMTENGT BRUNAVARJAKERFI
 SJA SÉRTEIKNINGAR HÚSSINS
 BRUNAVIÐBÓTAR

FLÓTTALEIDIR
 LYSING
 VIBBOTA ELLRA LOFTI V
 BRUNAVARNA
 FYLLT M PÉTTULL
 LOFT E KLATT 19 MM
 GRIND
 LOFTTRASTI ÖKAR ÖFANVÍÐ

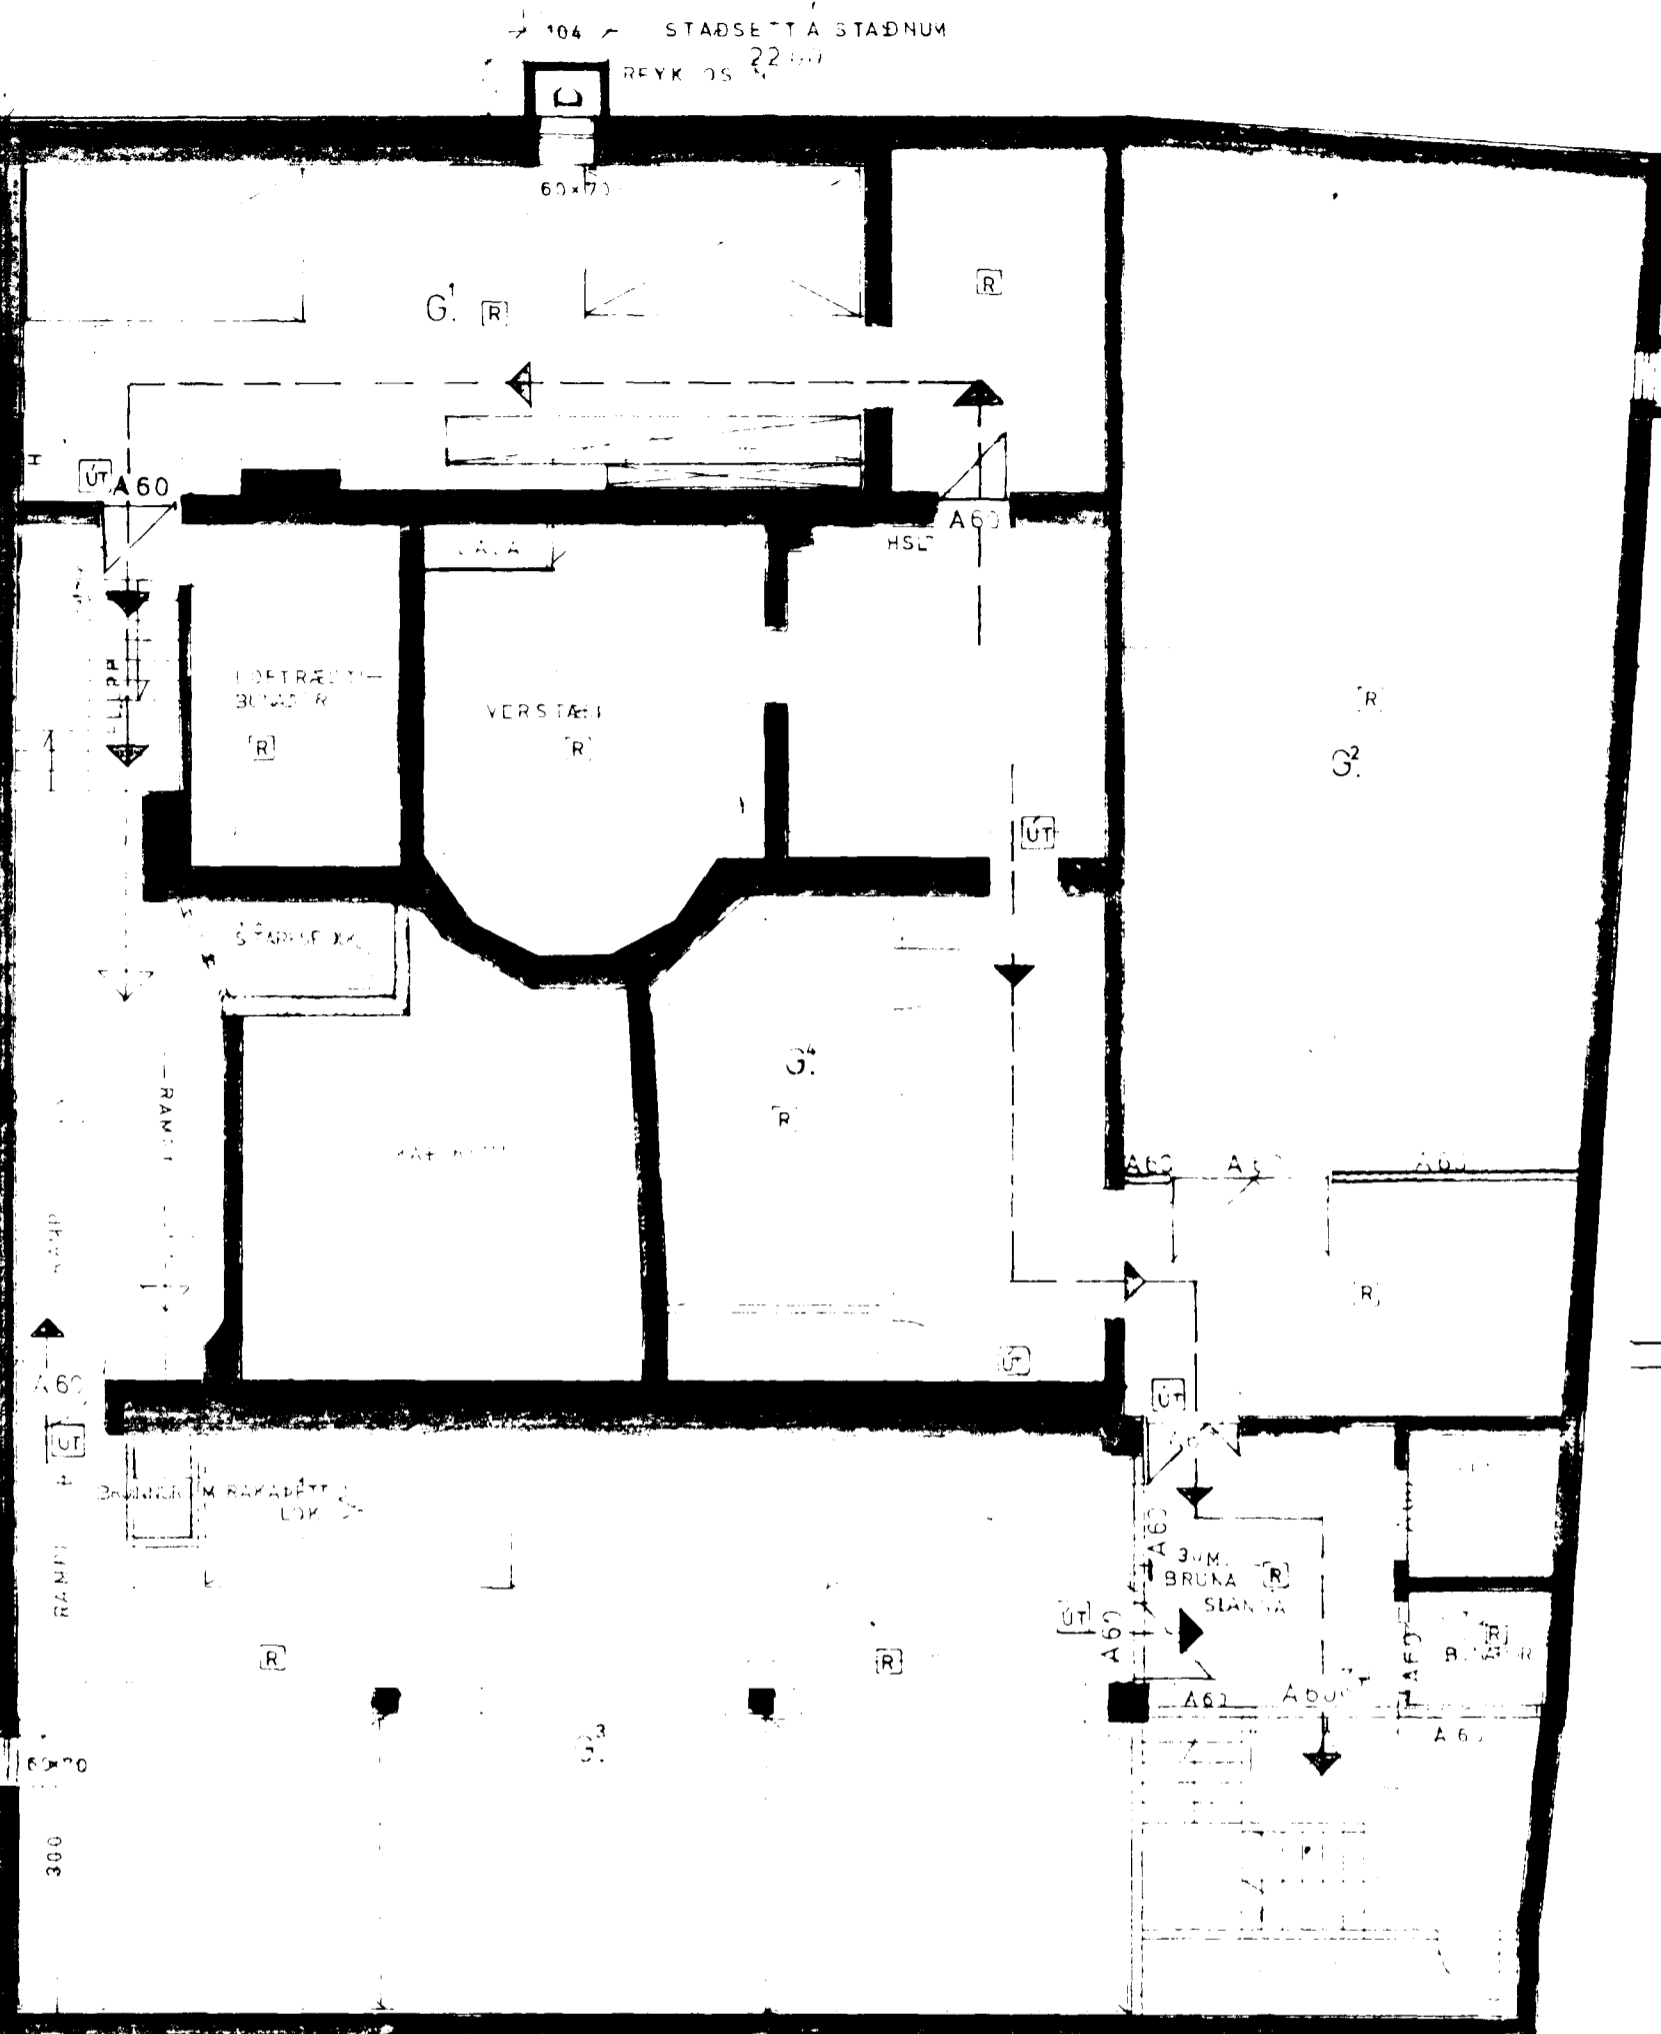

TEIKNINGAGRUNNUR VINDISTOFAN FLOTTA
 MÁTT UPPAÐ F. BRATTI
 BREYTT OG LEIÐRETT 23. MAJ 1998
 A. MAR 1998

LITLA
 TEIKNISTOFAN
 220 Hafnarfirði
 Ólafur Hjálmarsson

4 MAY 1998