




Samþykkt á fundi bygginga-  
nefndar þ. 14.11.1979  
BYGGINGAFULLTRÚINN  
Í HAFNARFIRÐI  
*[Signature]*

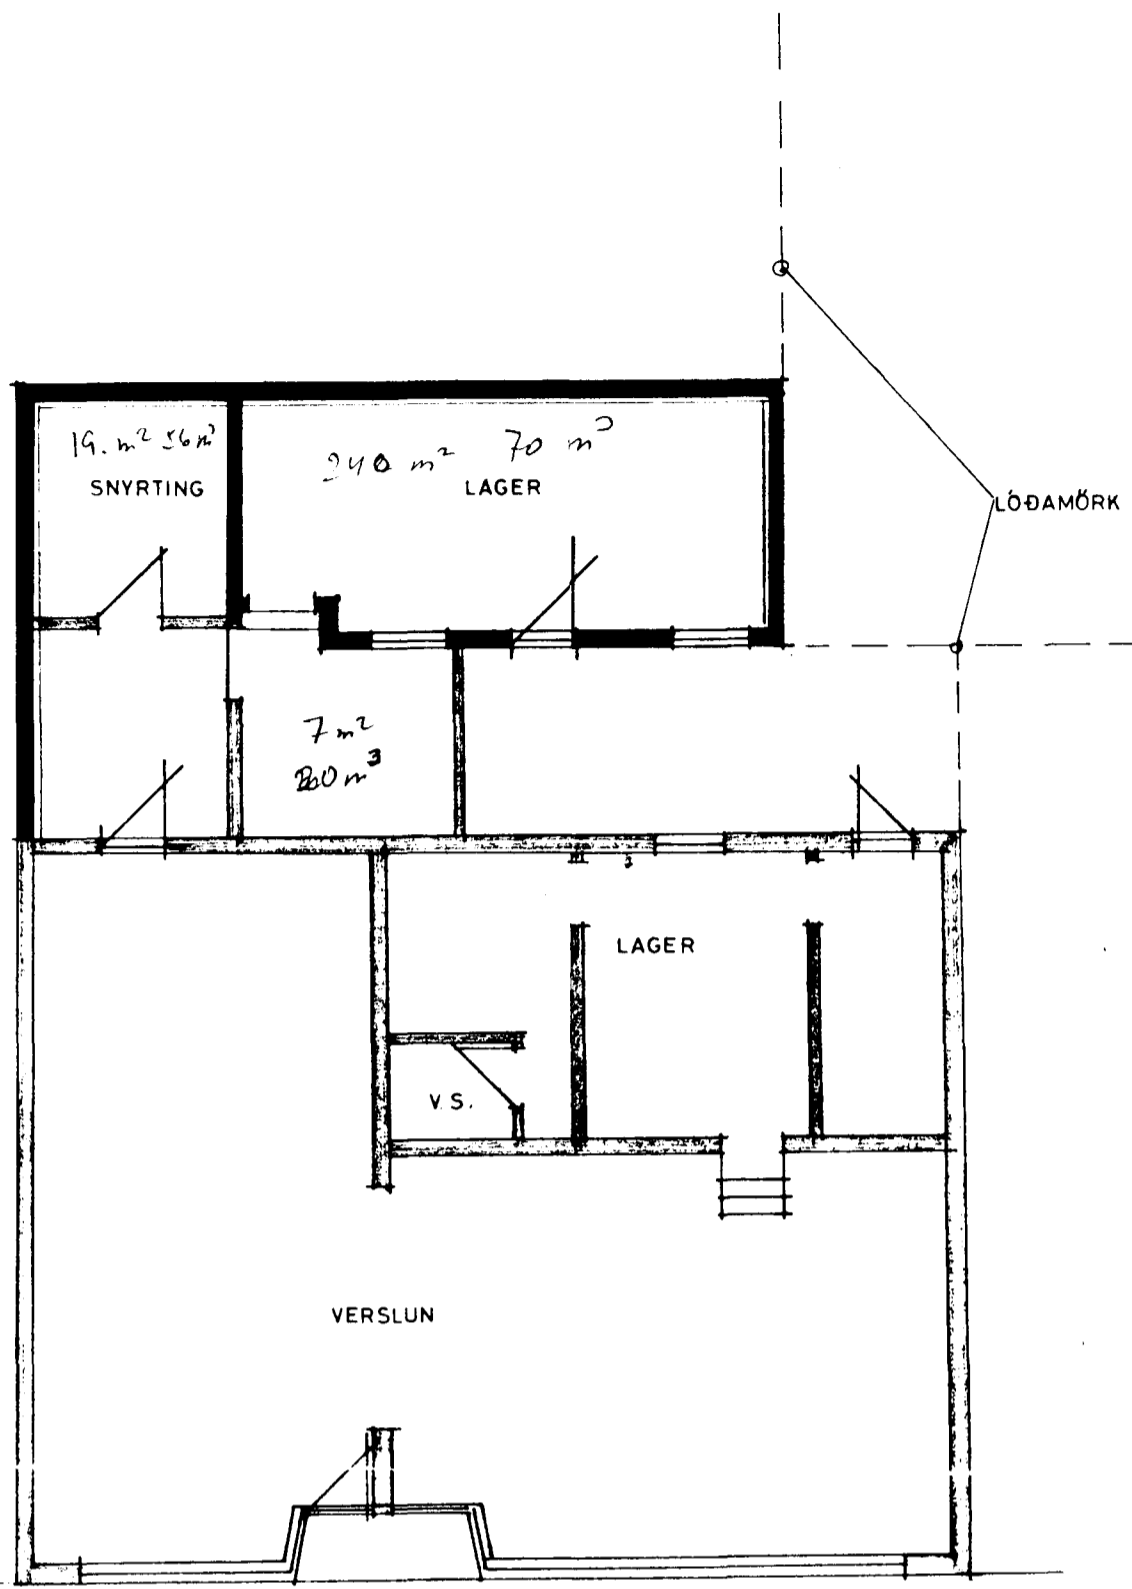

GRUNNMYND FYRIR BREYTINGU 1:100

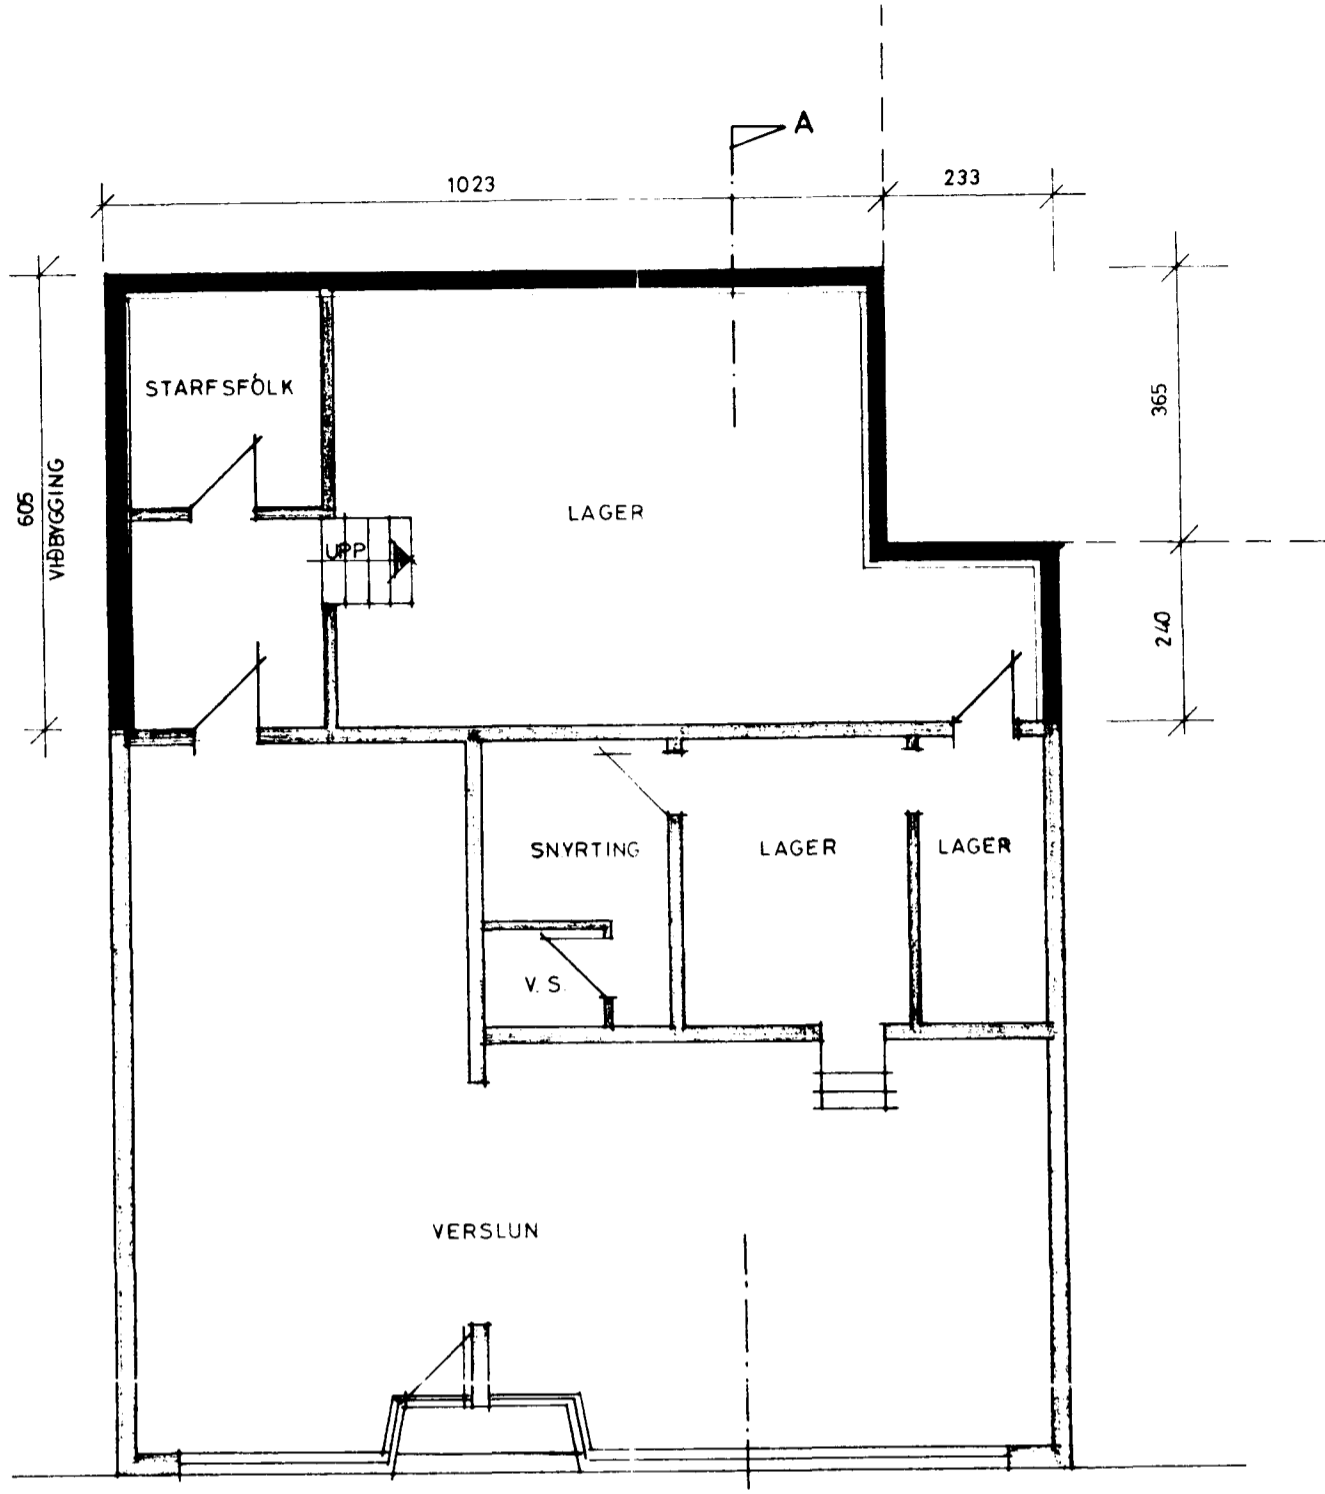


GRUNNMYND EFTIR BREYTINGU 1:100

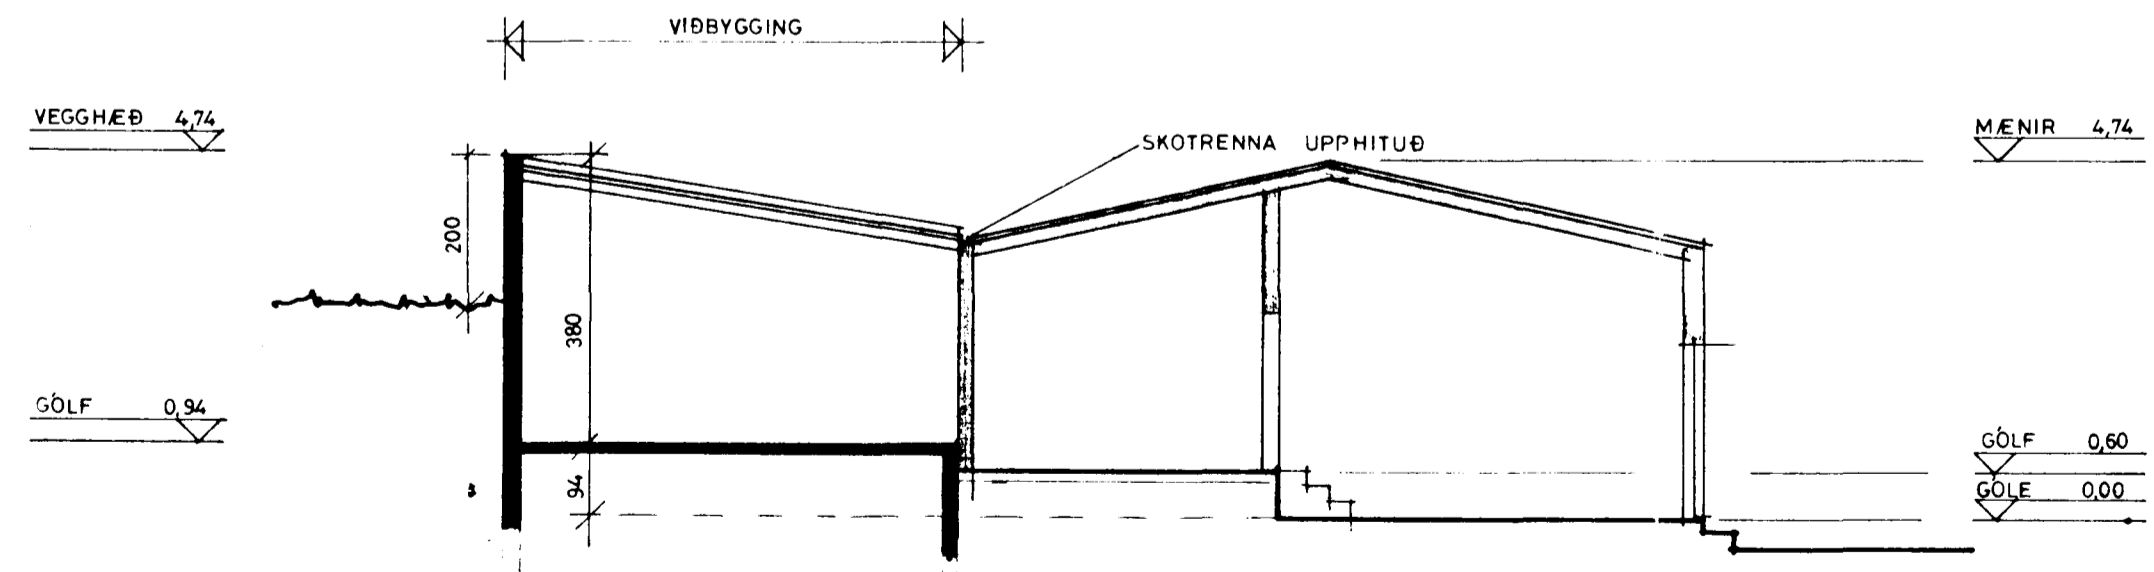

SNID A - A 1:100

Uev.  
19 m² 56 m²  
240 70 -  
7 20  
50 m² 146 m²

$10,20 \times 605 = 6189$   
 $233 \times 240 = 5592$   
 $675 m^2 \times 3,1 = 20925$   
 $27500 - 694 = 26806$   
 $225 - 146 = 79 m^2 @ 2272 = 179488$   
 $15,75$   
 $225,0 m^2$

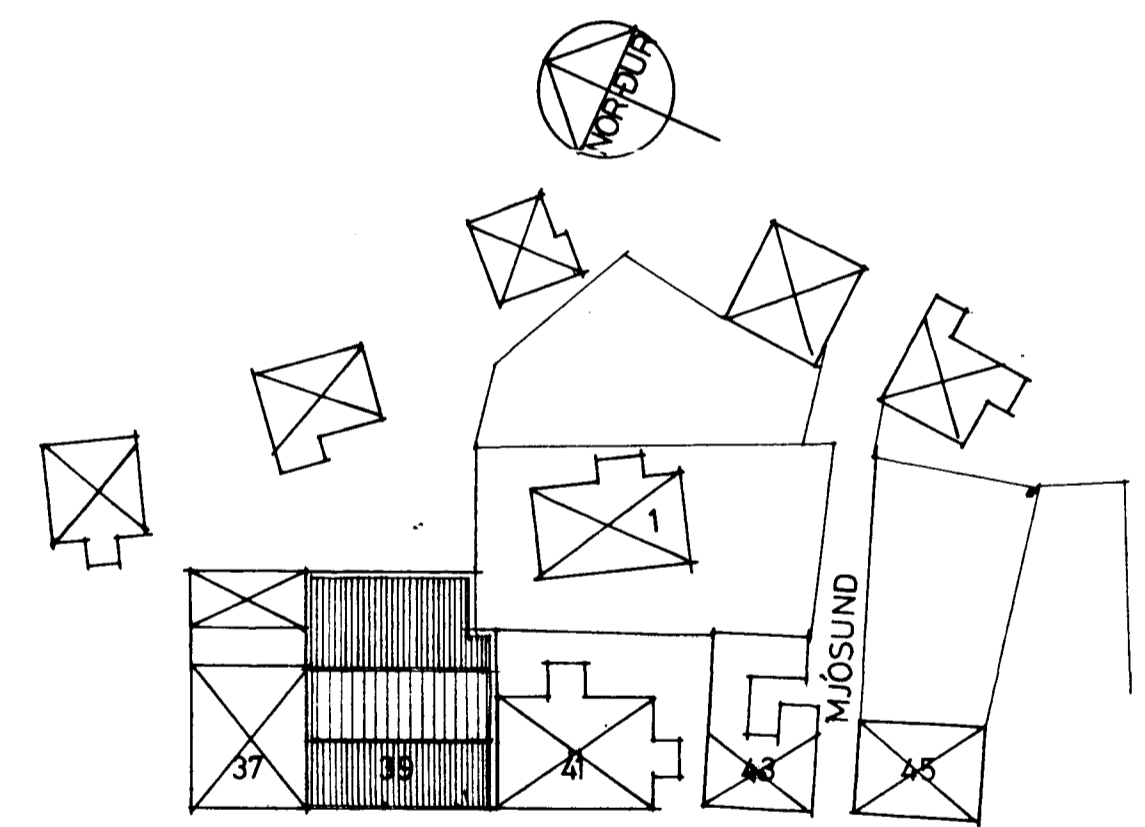

AFSTÖÐUMYND 1:500

8400-0390-02

PÁLL V. BJARNASON, ARKITEKT, FAÍ HOLTSGÖTU 4, HAFNARFIRÐI, SÍMI 5 20 47		
KVARÐI 1:100	OKT. 1979	TEIKN
STRANDGATA 39, HAFNARFIRÐI VERSLUN		
VIÐBYGGING FYRIR LAGER		
59.01		