
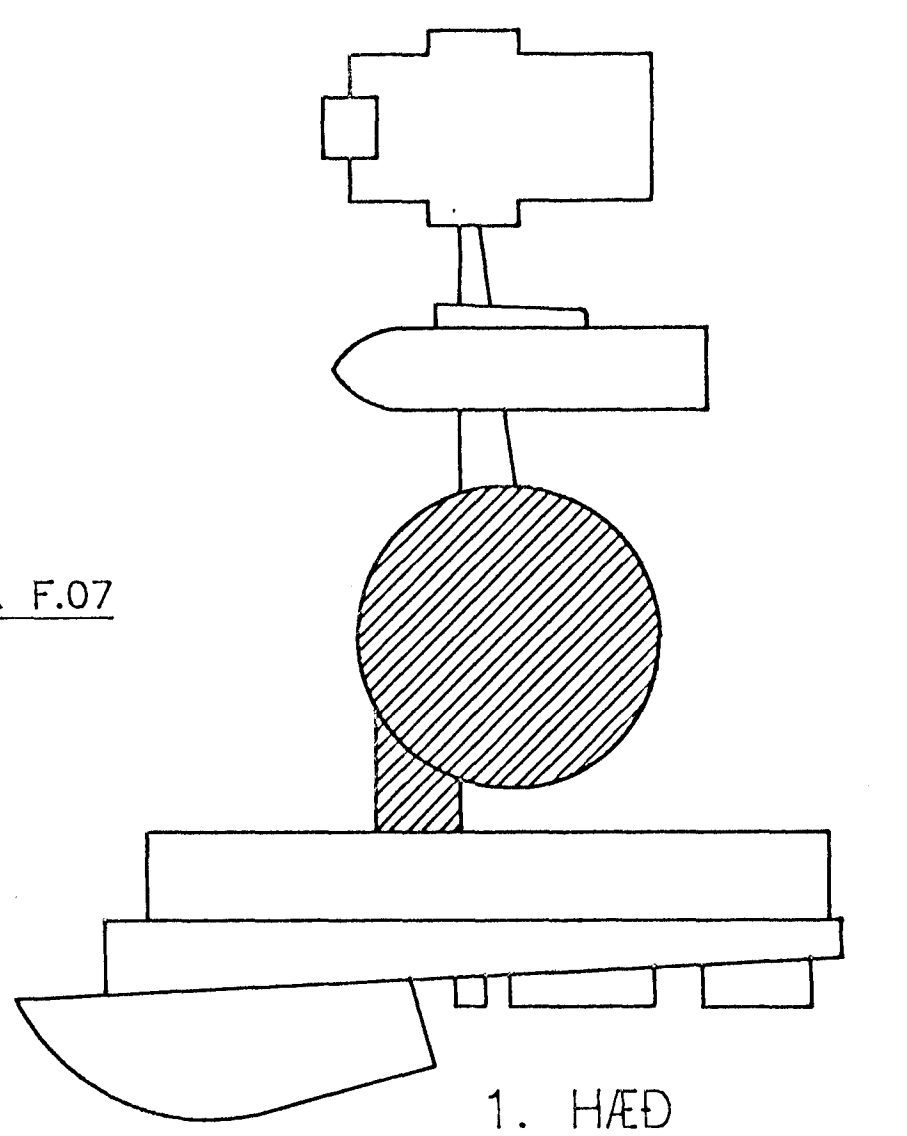


SJÁ SKÝRINGAR Á TEIKNINGU NR. F.04
SJÁ STOFNA (FALLPÍPUR) Á TEIKNINGU NR. F.07

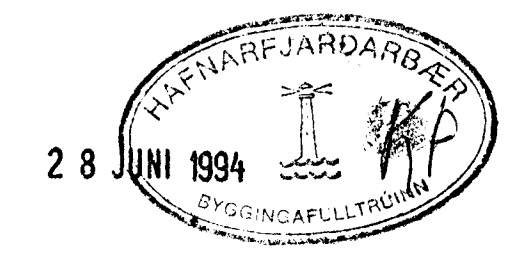

VINNUTEIKNING

A 02 94 Breytingar og viðbætur		LAGNATÆKNI HF. LAUGAVEGI 16B 105 REYKJAVÍK Sími: 91-621750		VERK NR: 099FG106
NR:	DAGS	BREYTING	AF	KVARDI 1:50
SAMP: Fróðrik E. Kristjánsson 300346-3409			REIKN: FSK/HBG	TEIKN: HBG/FSK
			DAGS: 02-1994	BLAD NR: F.06A