


Norðurlit

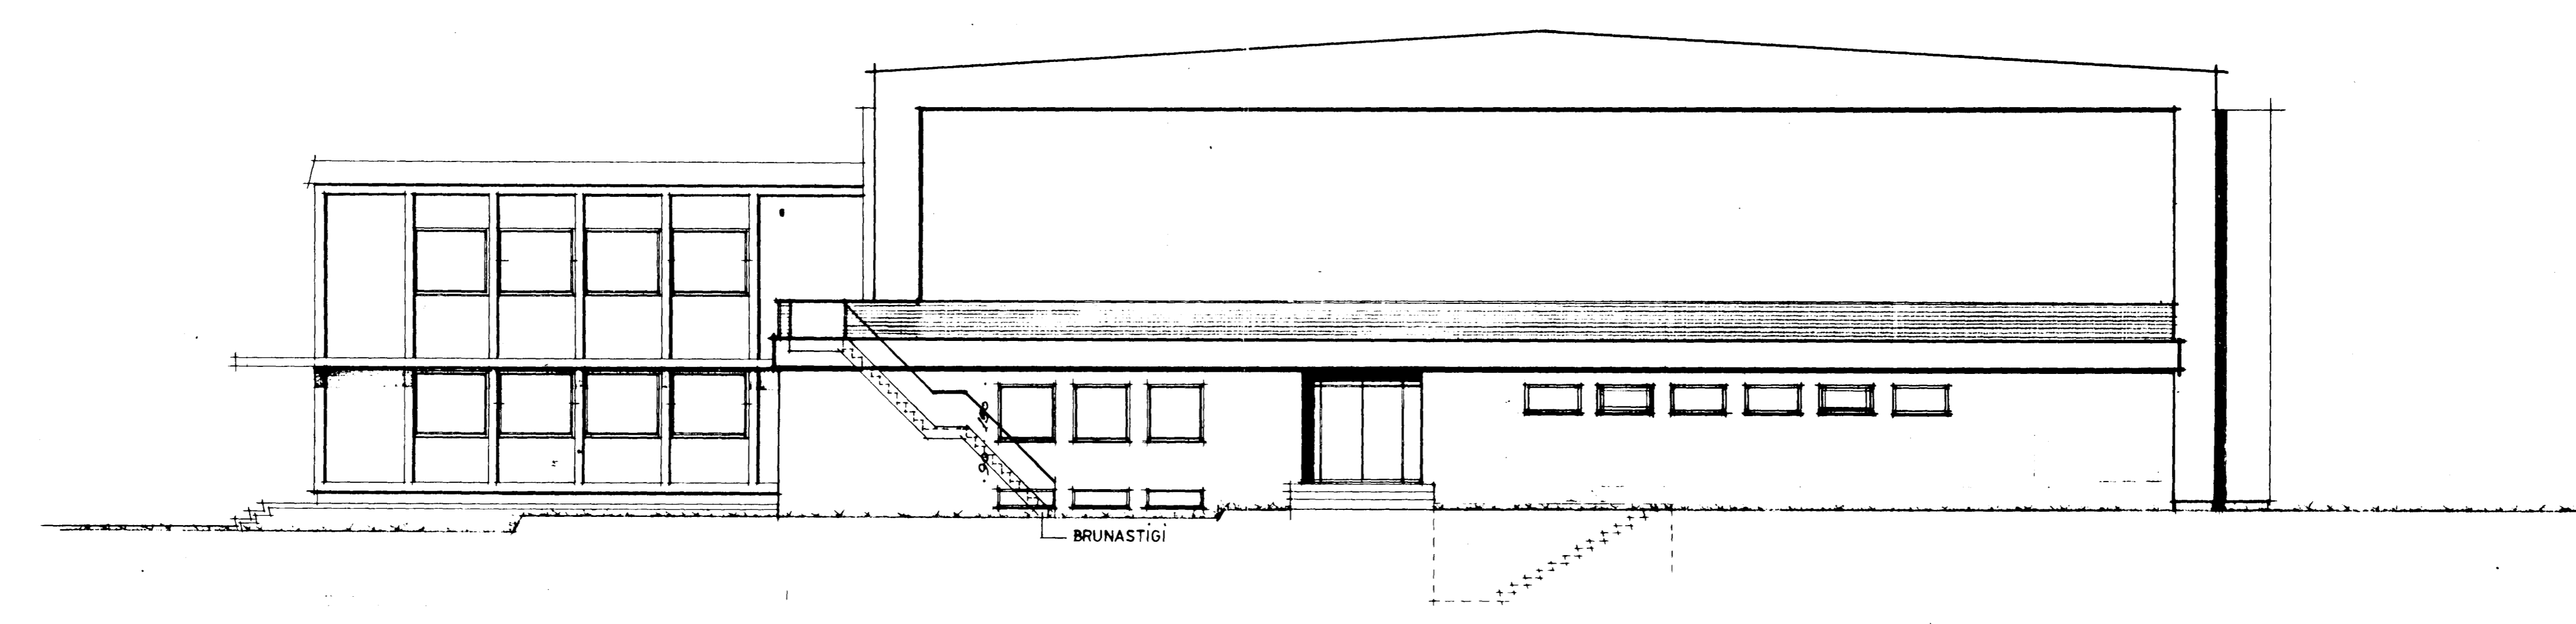

Suburlit

*Stökkvitið hefur borgarsæðisins b.s.
 8/4'00 Dikar Þorbjörn*

TEIKNISTOFAN HF
 A R M Ó L A O
 100 REYKJAVÍK • ÖRN 068 0700

Raunteikning og brunahönnun
 23-08-2000 LG

TEIKNISTOFAN TÓSSASARHAGA 31	
REYKJAVÍK	
GÍSLI HALLDÓRSSON arkitekt JOSEF REYNNIS arkitekt OLAFUR JÚLIUSSON byggingarfr.	
M: 1:100	Verkefni: <i>Iþróttahúsið í</i>
DAG: 23-8-00	<i>Fjalmanntíðni A-G</i>
Bl. 5	<i>Litillit</i>
Bl. 5	
Breytt	