




Samþykkt þann

14 MARS 1996

Byggingafulltrúinn í Hafnarfirði  
Erlendur Hjálmarsson

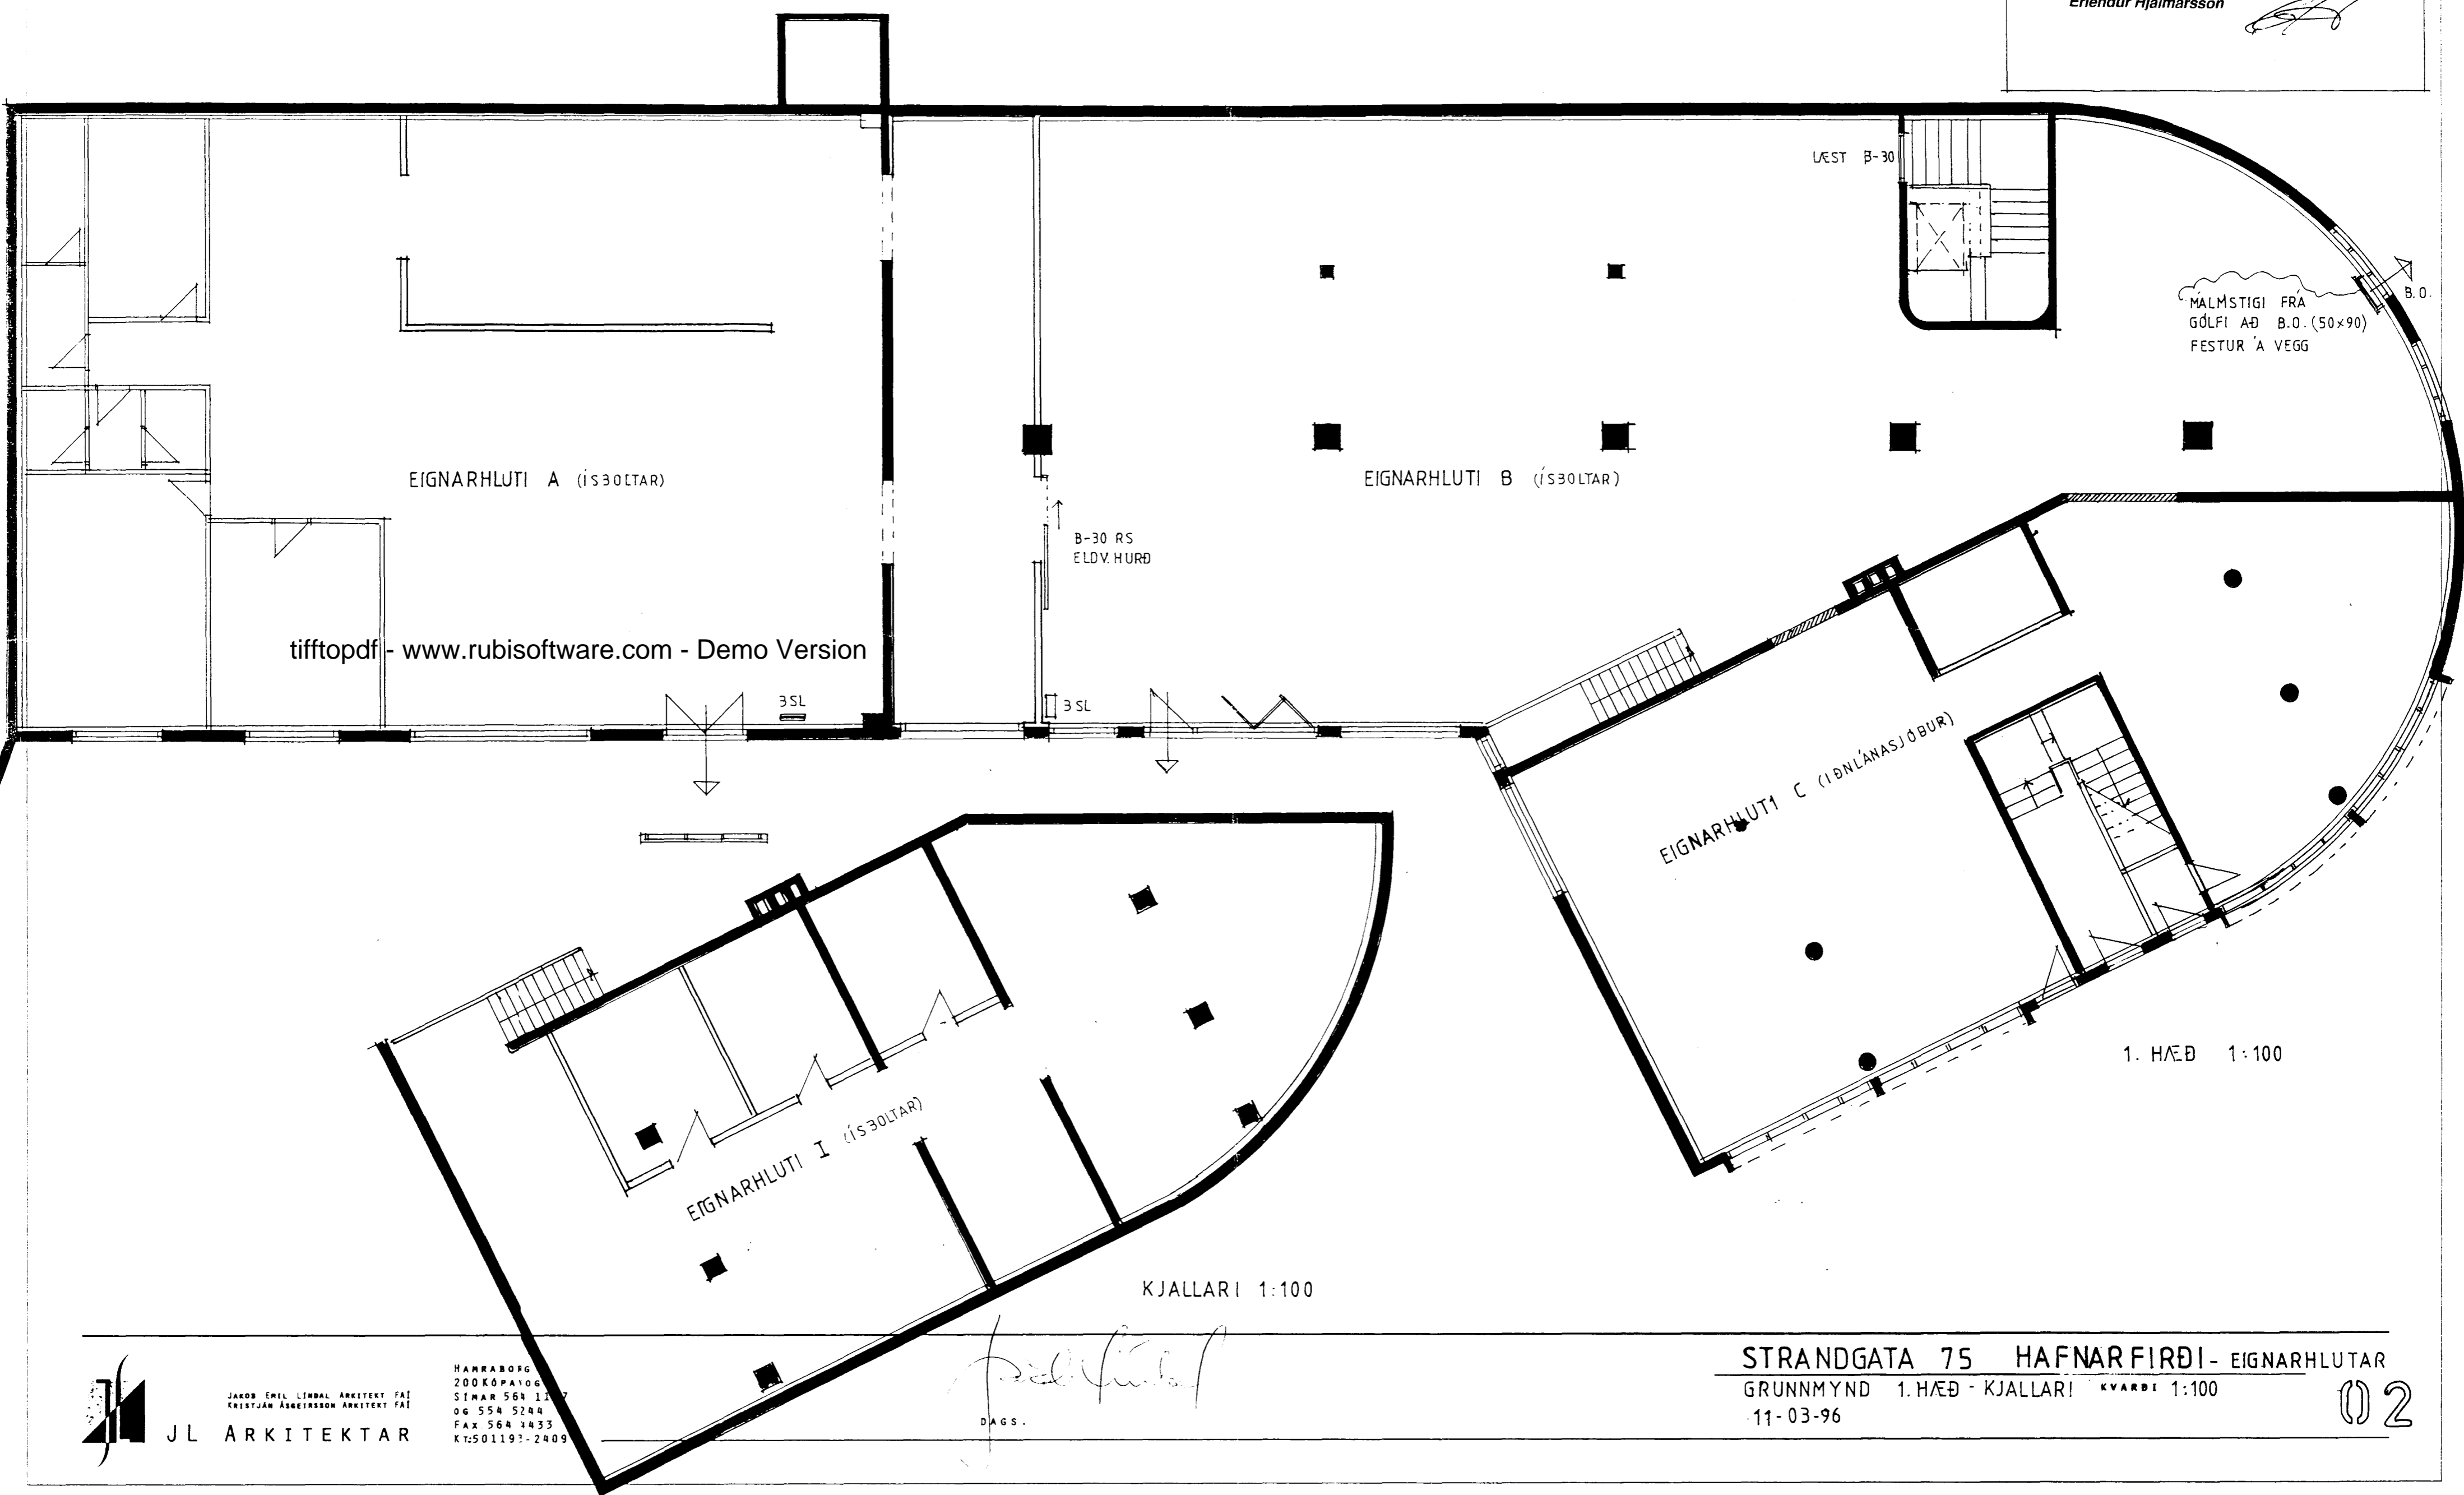

tifftopdf - www.rubisoftware.com - Demo Version

1. HÆÐ 1:100

KJALLARI 1:100

 JL ARKITEKTAR

HAFNARBORG  
200 KÓPÁYOGG  
SÍMAR 564 1177  
OG 554 5244  
FAX 564 4433  
KT: 501193-2409

DAGS.

STRANDGATA 75 HAFNARFIRÐI - EIGNARHLUTAR  
GRUNNMYND 1. HÆÐ - KJALLARI KVARDI 1:100  
11-03-96

02