
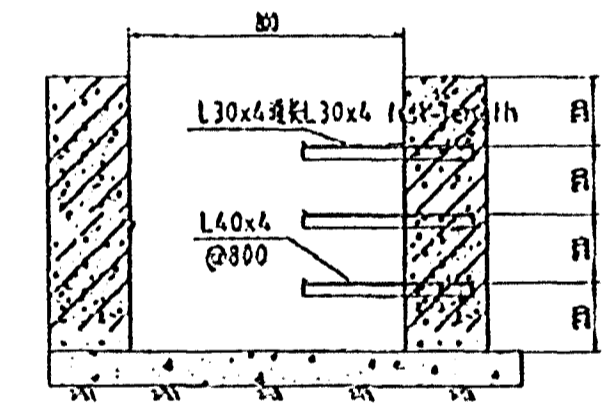


Nick Indrisson
Tel. 131144-3949
101

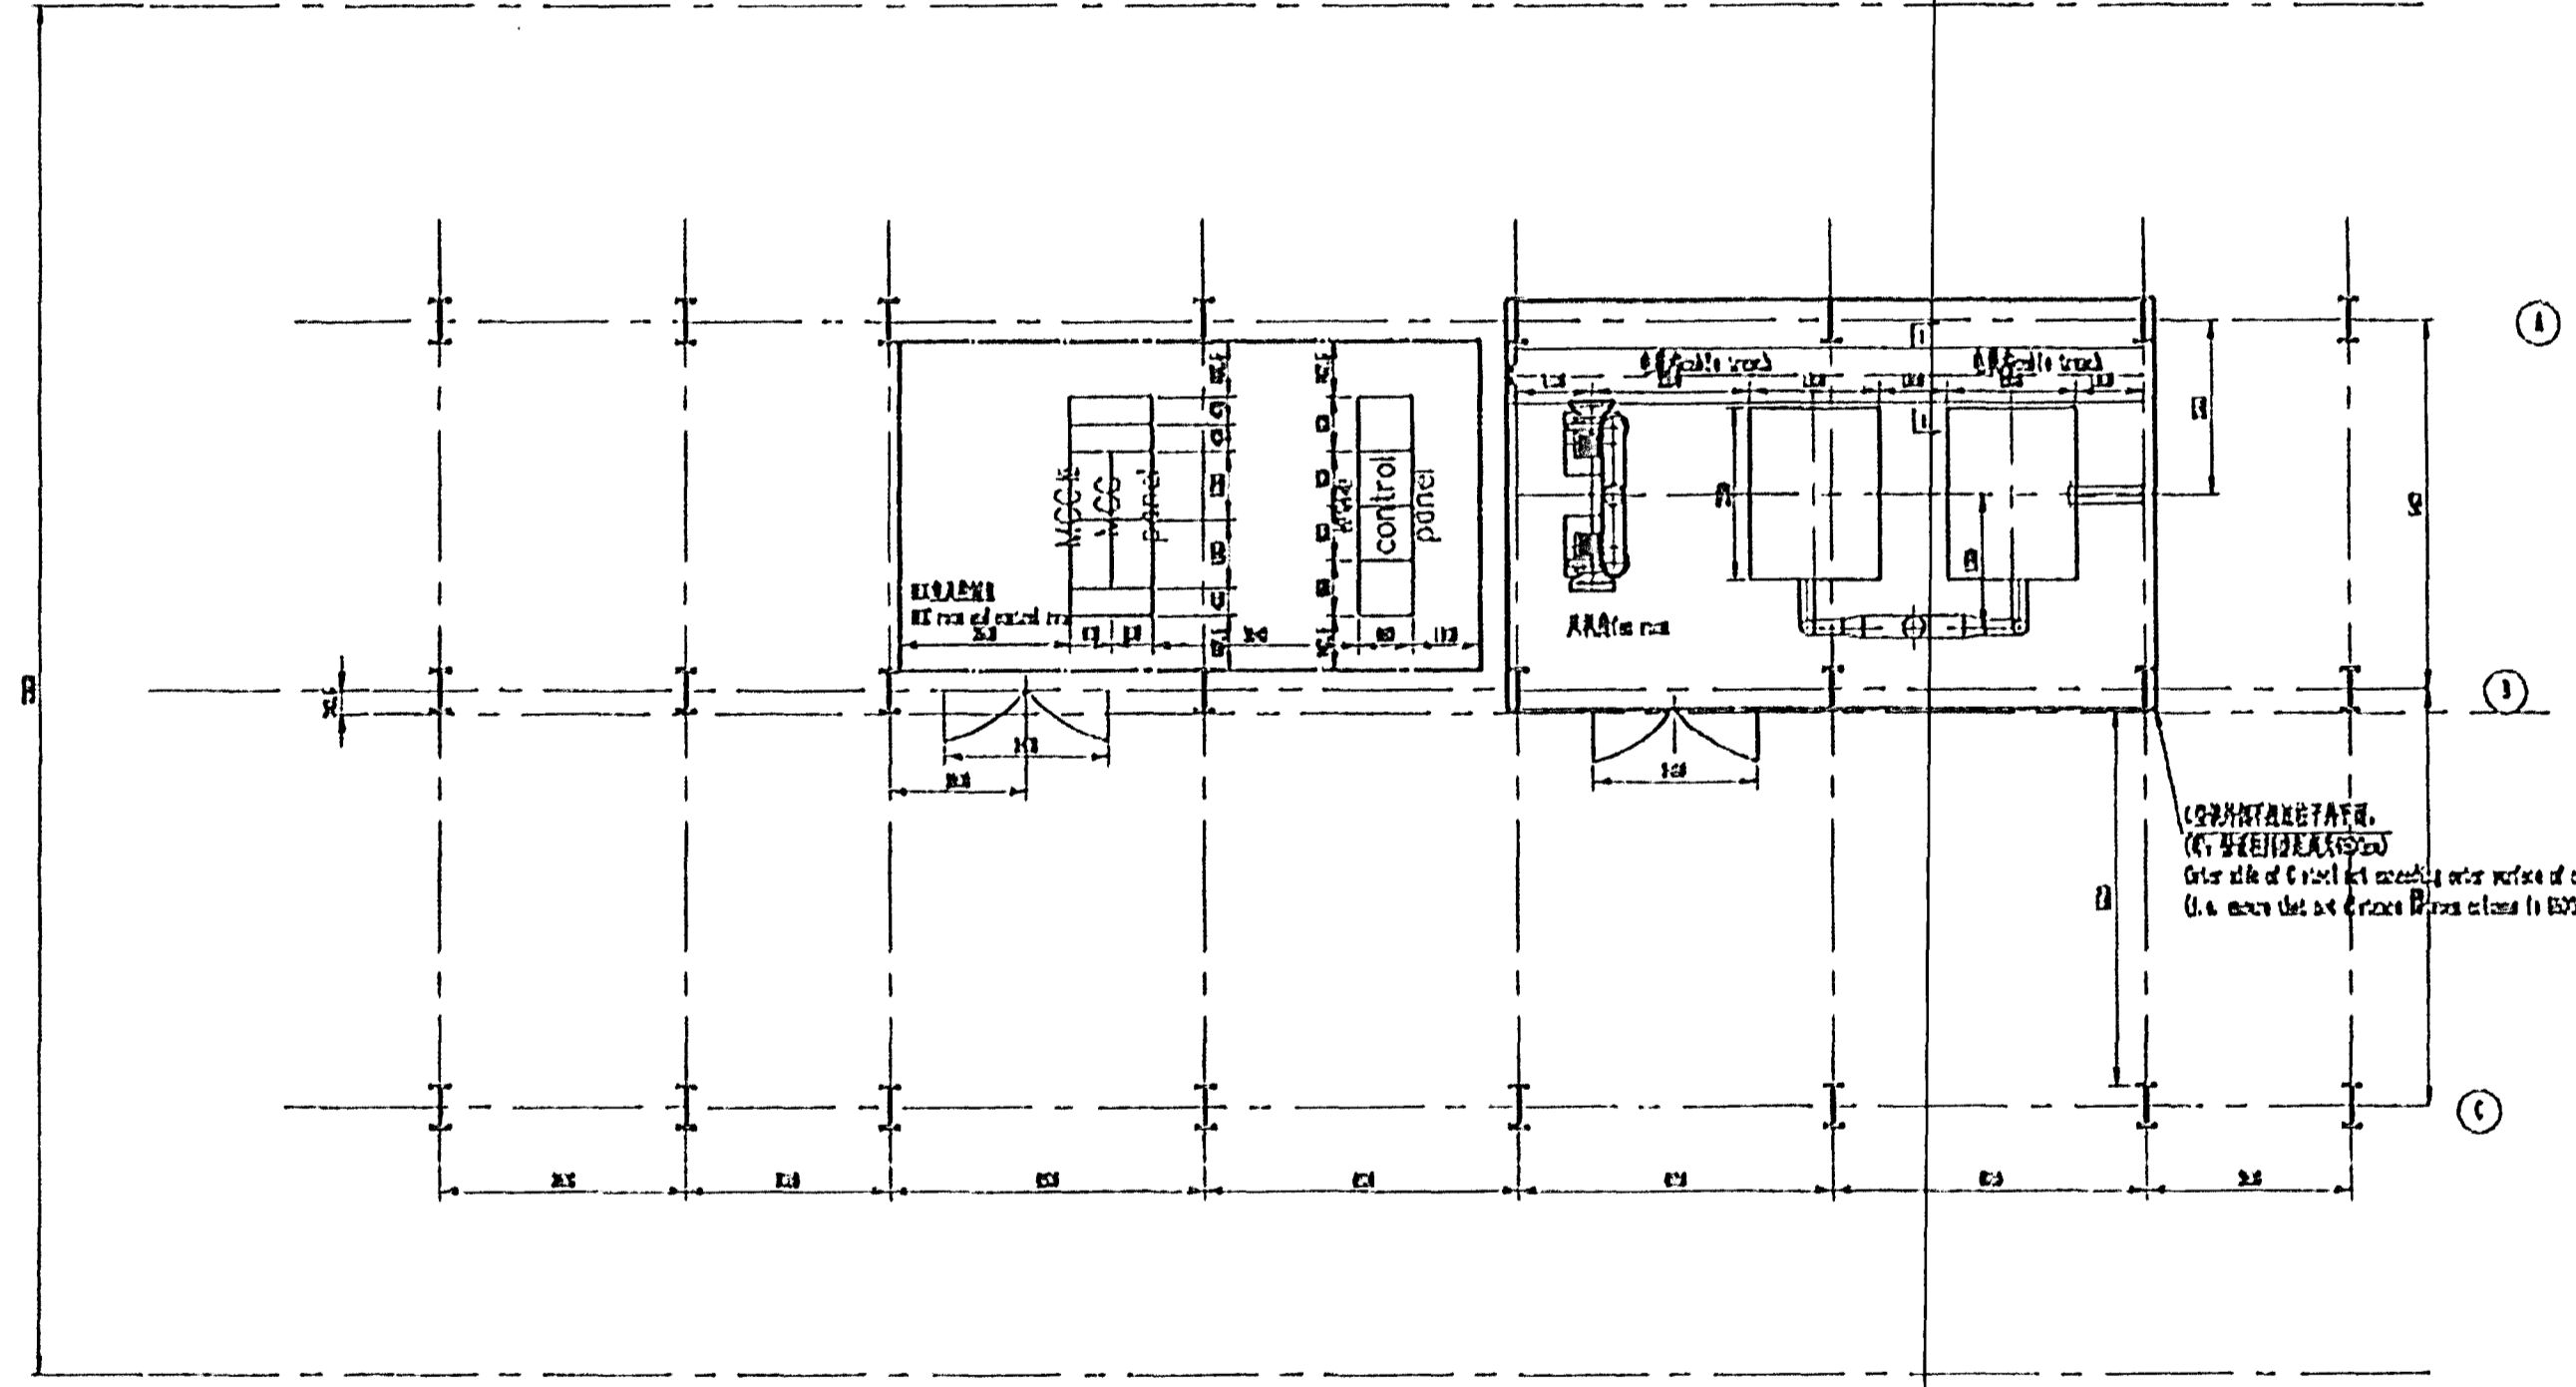

1-1 1:20

HRV ENGINEERING	HATCH Vendor Document Status
<input type="checkbox"/> Proceed to next submittal and status. <input type="checkbox"/> Proceed with exceptions as noted to next submittal and status. <input type="checkbox"/> Do not proceed. Revise as noted and resubmit next submission and status. <input checked="" type="checkbox"/> Complete, no further submittal required.	
By: S. Broek	Date: 13/8/11
Review and submittal to fabricator is only for general information. It is not a contract. The contractor is responsible for the accuracy and completeness of the drawings. The contractor is not responsible for the accuracy or completeness of any data entered into the drawings.	
IPU-432-011-ES-VD-0003-sub01	

Skýringar:
Legend:

△							
△							
△	20.05.2011	HGC	LOS				
△	17.05.2011	HGC	LOS				
△	19.04.2011	HGC	J.C.				
△	14.04.2011	HGC	J.C.				

 	Issued / Date 17.06.2011	IPU-430 Gas Treatment Centers GIC (a) MCC & Arrangement drawing of GIC (a) MCC room and fan room	Project no. / Rev. no. / Next issue / /
	Drawn / Checked LOS / LOS	Fabric / Drawn /	Approved / Date /
Checked / Supplier /	Fabricator / Supplier /	Approved / Date /	Author / Date of Issue / Date / Rev. / / /
IPU-432-011-204 HGC	TWT / Date /	Rio Tinto Alcan	Author / Date of Issue / Date / Rev. / / /