



Níels Indriðason  
Kt. 181144-3949 Ni

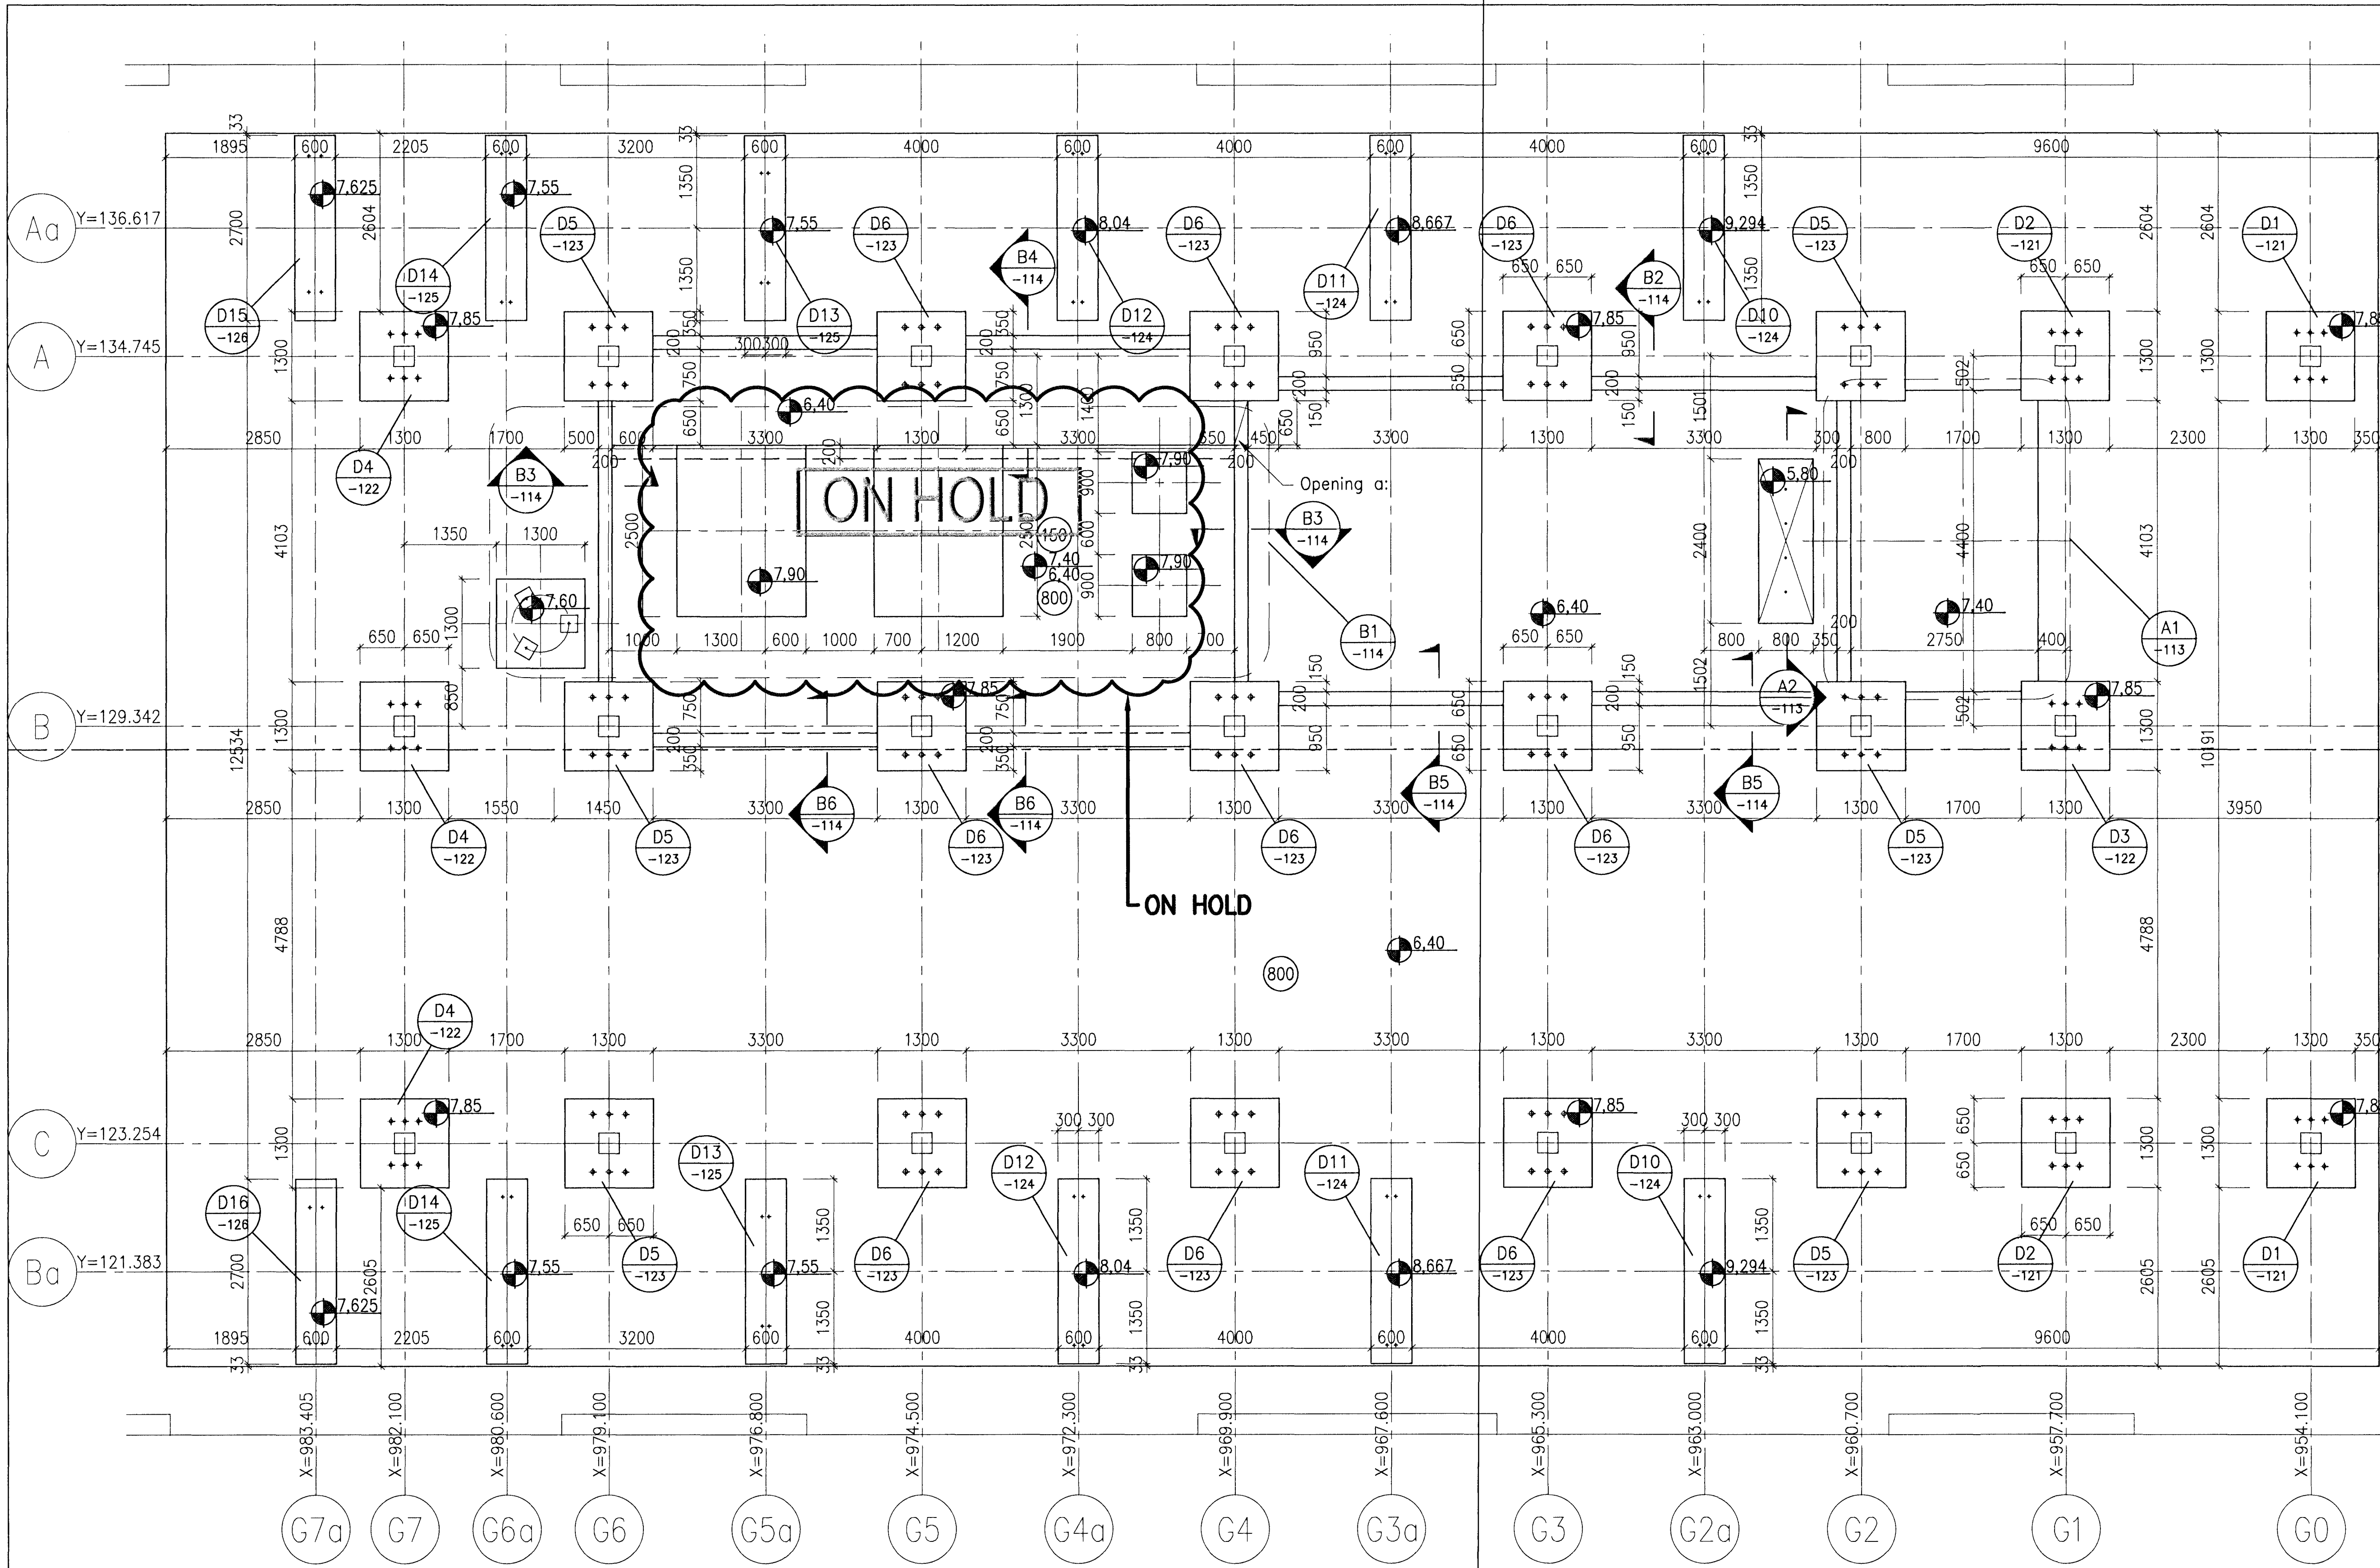

Embedded conduits not shown on this drawing.  
Embedded conduits, refer to electrical drawings IPU-431-FJ-017-101 and IPU-431-FB-017-101 to -103.

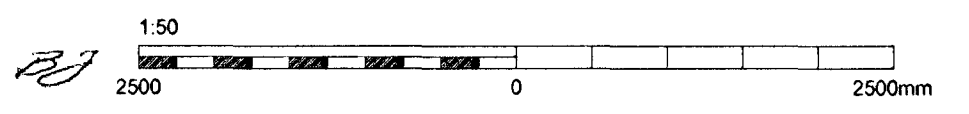

Skýringar: General notes refer to drawing IPU-431-CA-017-101.  
Legend: Concrete quality: C30/37; XF3-25  
Opening in foundation:  
a: 800x650, EL. 6.40

Fig. nr / Rev. no.	Þýðing / Description	Dagsetning / Date	Hver/Þin / Des./Dwg	Yfir / Dtd	Stjór. / Nám. / Nám. / Nám. / Nám. / Nám.
4	Issued for construction	2011.11.01	PEL	NI	PE

This drawing is the property of Rio Tinto Alcan Iceland Ltd. and handed out for personal use only. It may neither be copied nor made available to others without permission of Rio Tinto Alcan Iceland Ltd. The receiver is liable for any misuse.

Stærð: A1 Mkv.: 1:50  
Formát: A1 Mkv.: 1:50  
Stærðir án þolmála samkvæmt 50 2788-1 miðm.

**HRV ENGINEERING**

Dagsetning / Date: 2011.09.05  
Hannað / Designed: PEL  
Tékn / Drawn: PEL  
Verktaki / Supplier: HRV  
Tékn.nr./verktaki / Supplier drw.no.: IPU-431-CA-017-111  
Samþykkt / Approved: NI  
Hluti af: / Part of:

**Rio Tinto Alcan**

IPU-430 GAS TREATMENT  
GTC2A  
FILTER AREA, FOUNDATION PLATE  
Teg. teikningar / Dwg. type: FORMWORK

Flakur nr.: Blað nr.: Næsta bl. nr.:  
Kostn. nr. - Cono. / BSNr. - Eq.no.  
AKS

ISAL  
Tékn. nr. ISAL / Drw. no. of ISAL Breyt. / Rev.  
Alcan Iceland Ltd  
Straumsvík  
IS-222 Hafnarfordur  
Iceland

ISAL Yfirland og skráð, dags / ISAL Checked, date  
ISAL Samþykkt, dags / ISAL Approved, date