



Nick Indriðason  
 Kt. 181144-3949  
 NI


PLAN 1:50

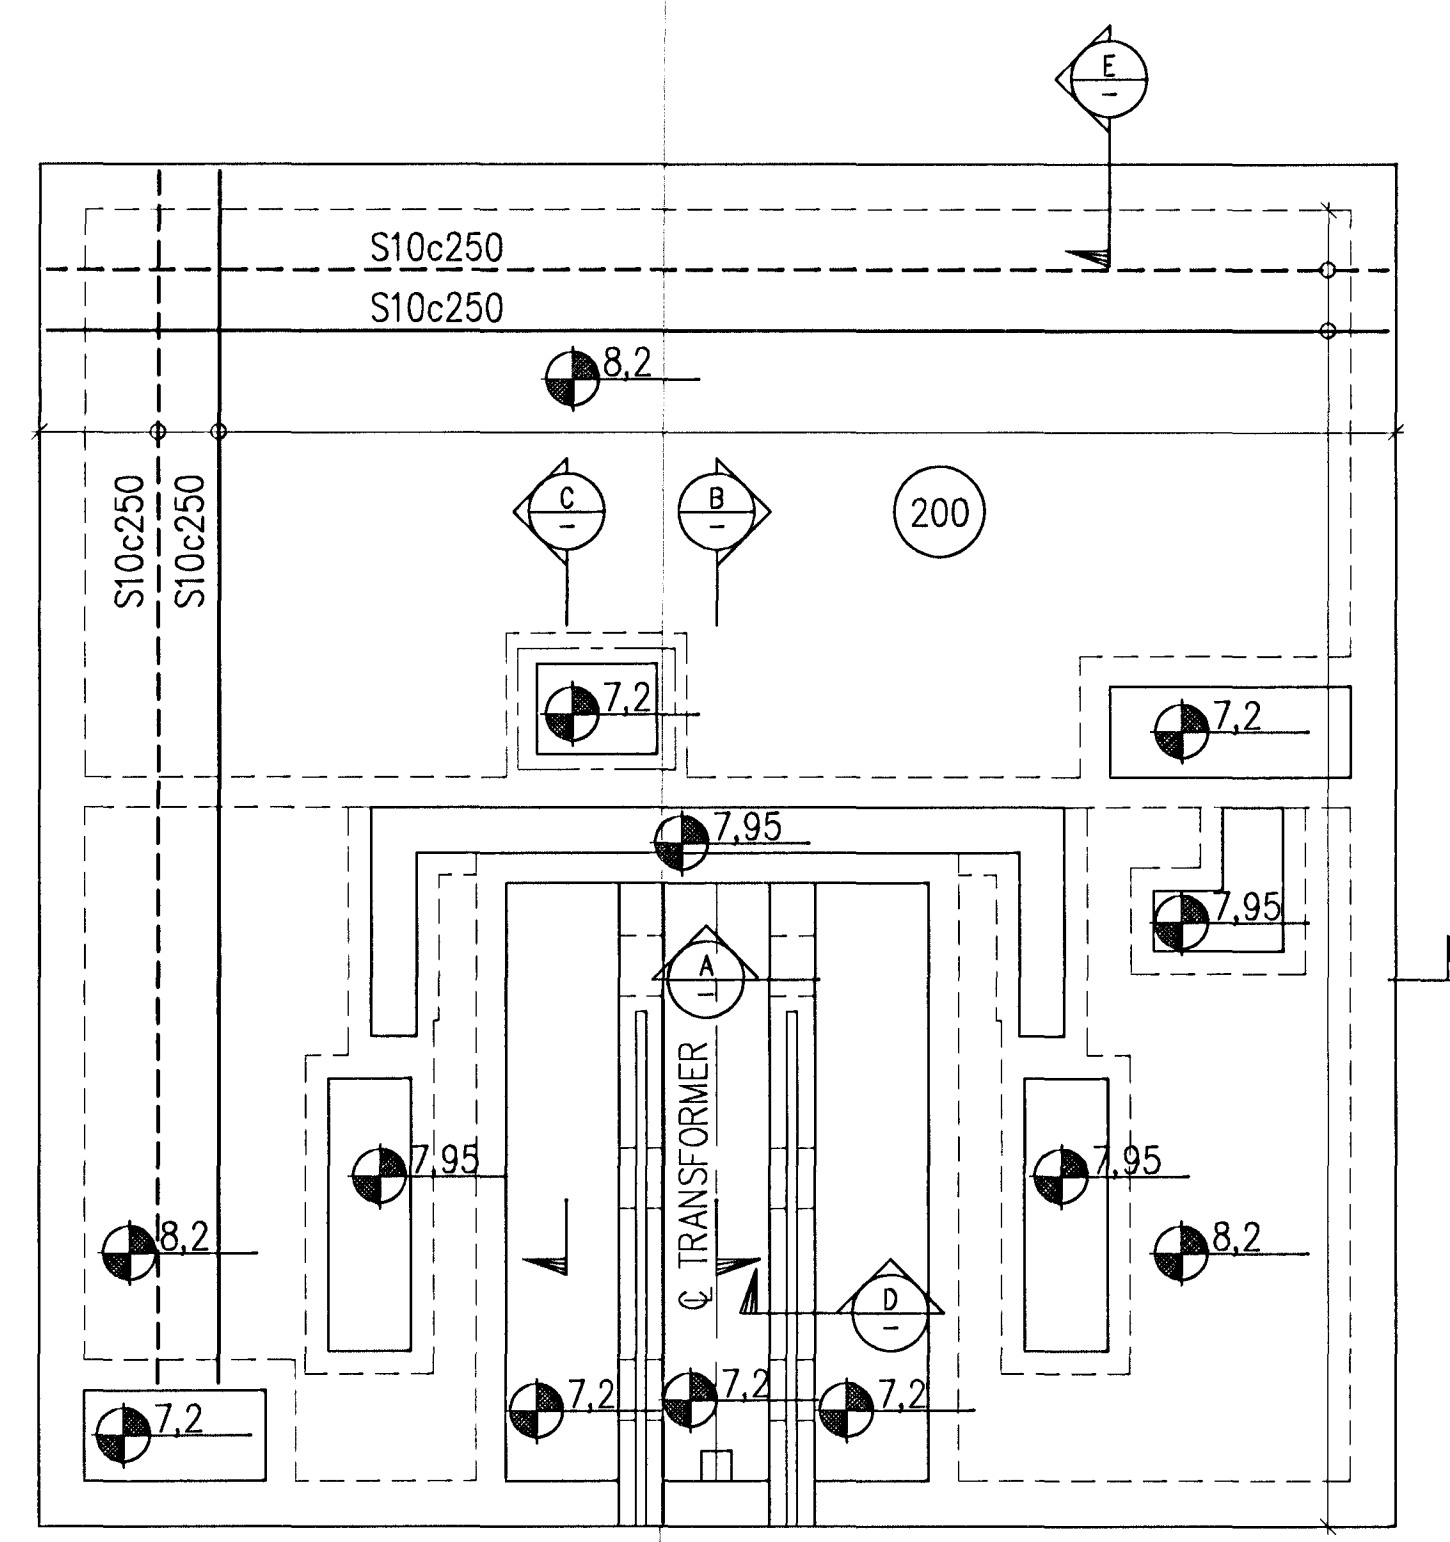


A SECTION 1:20

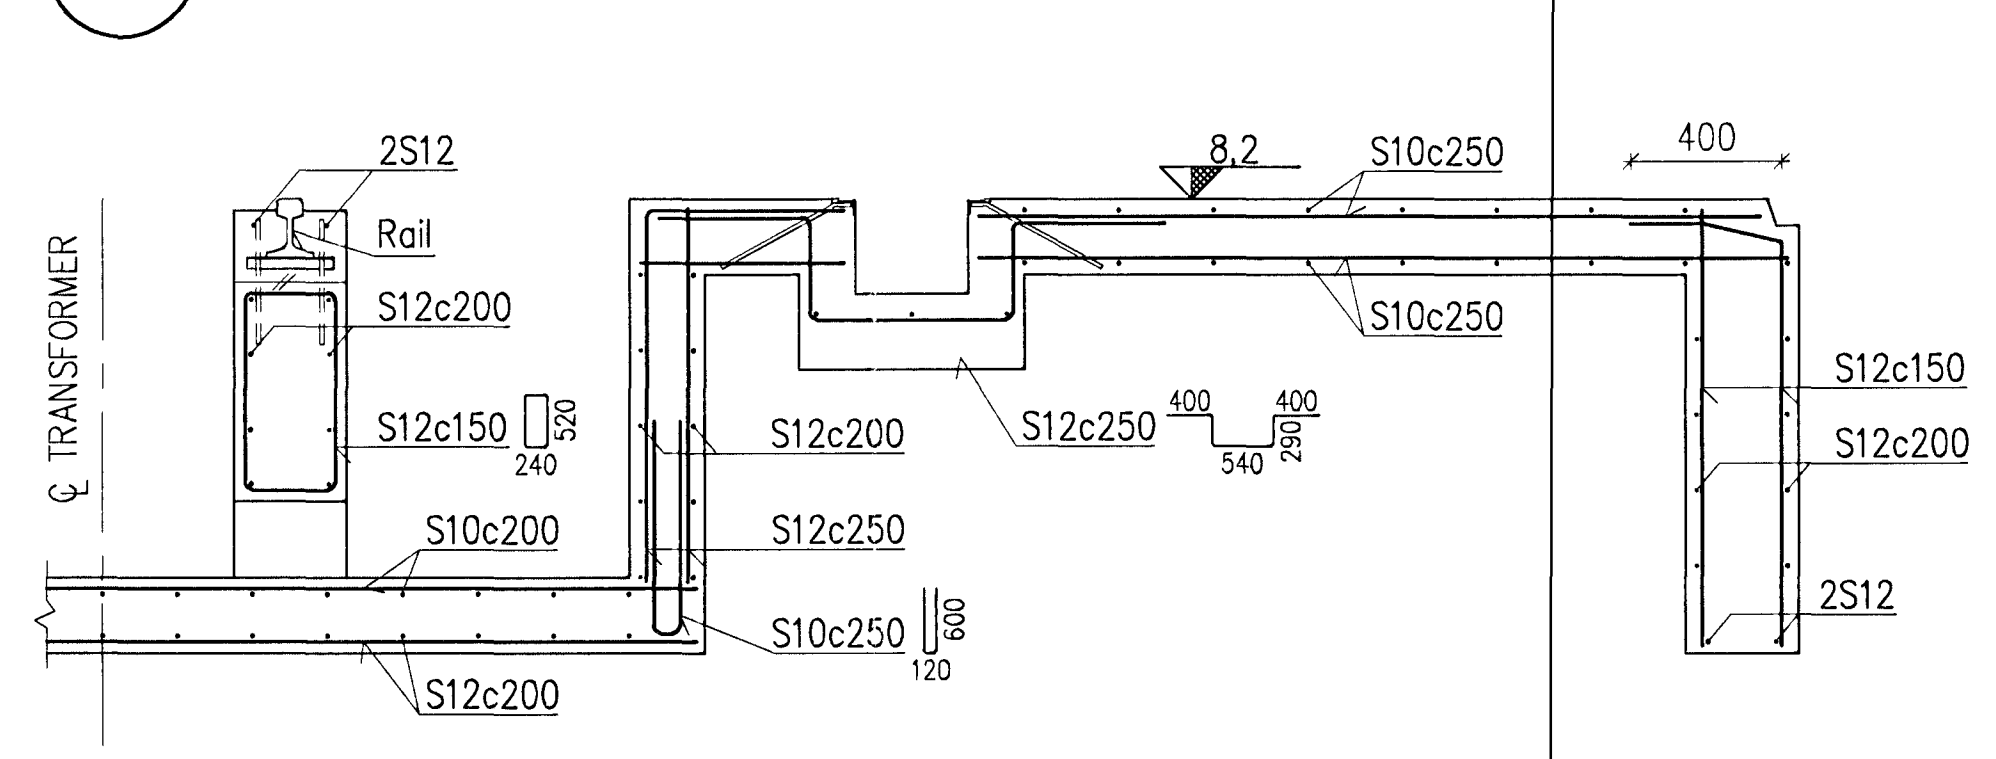


E SECTION 1:20

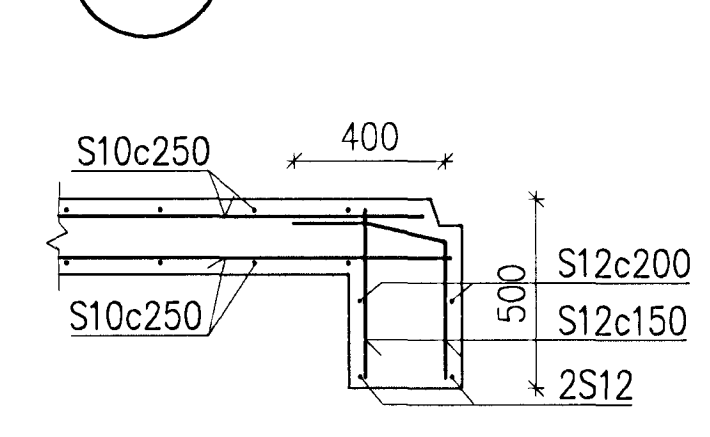


B SECTION 1:20

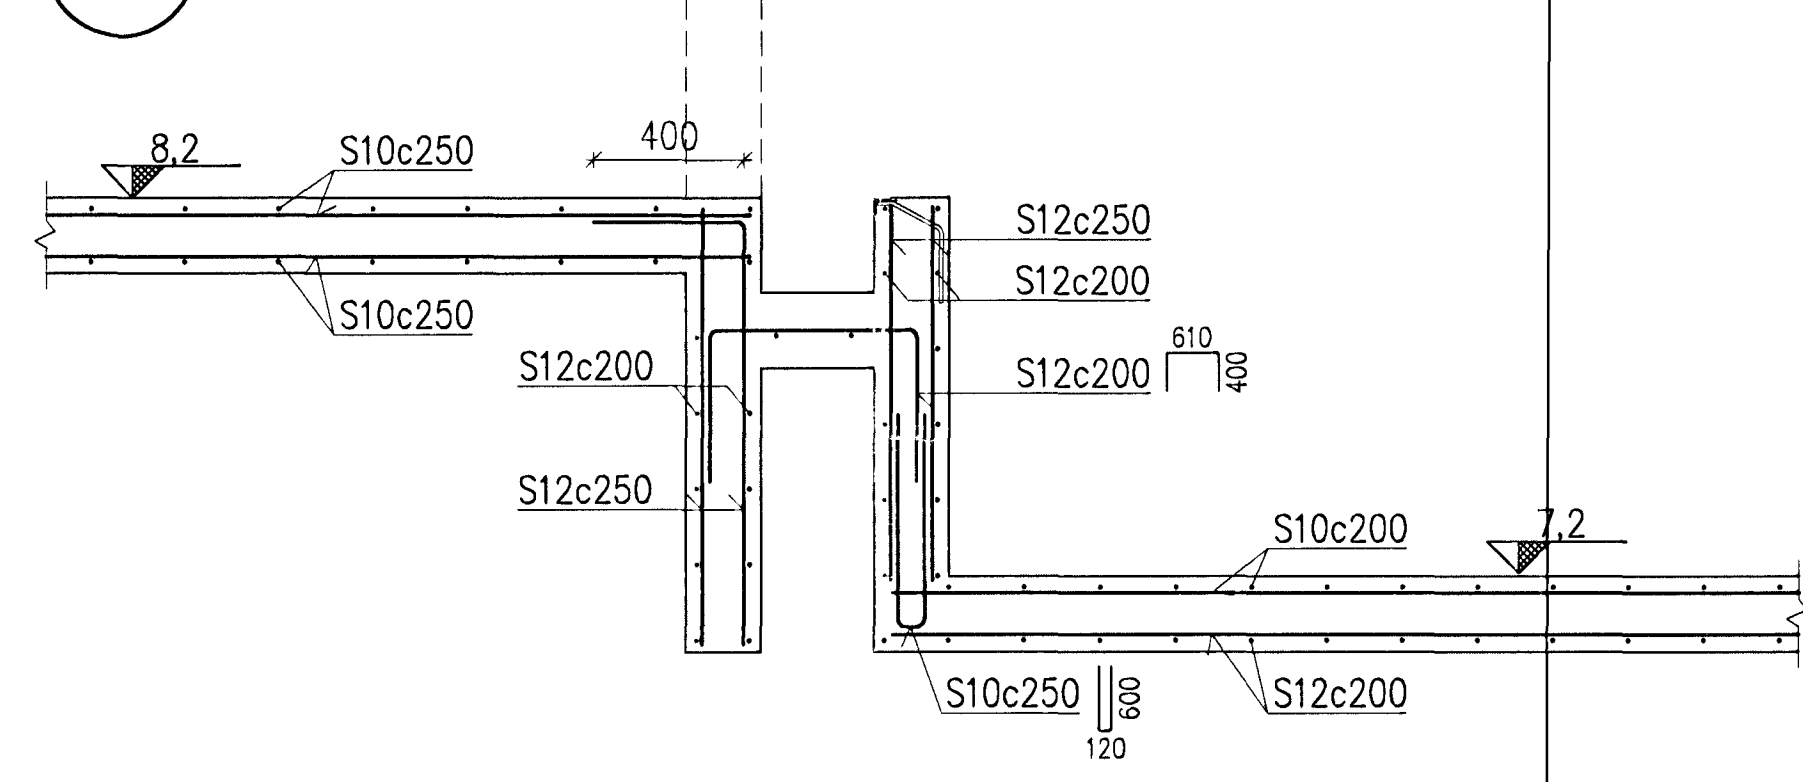



C SECTION 1:20

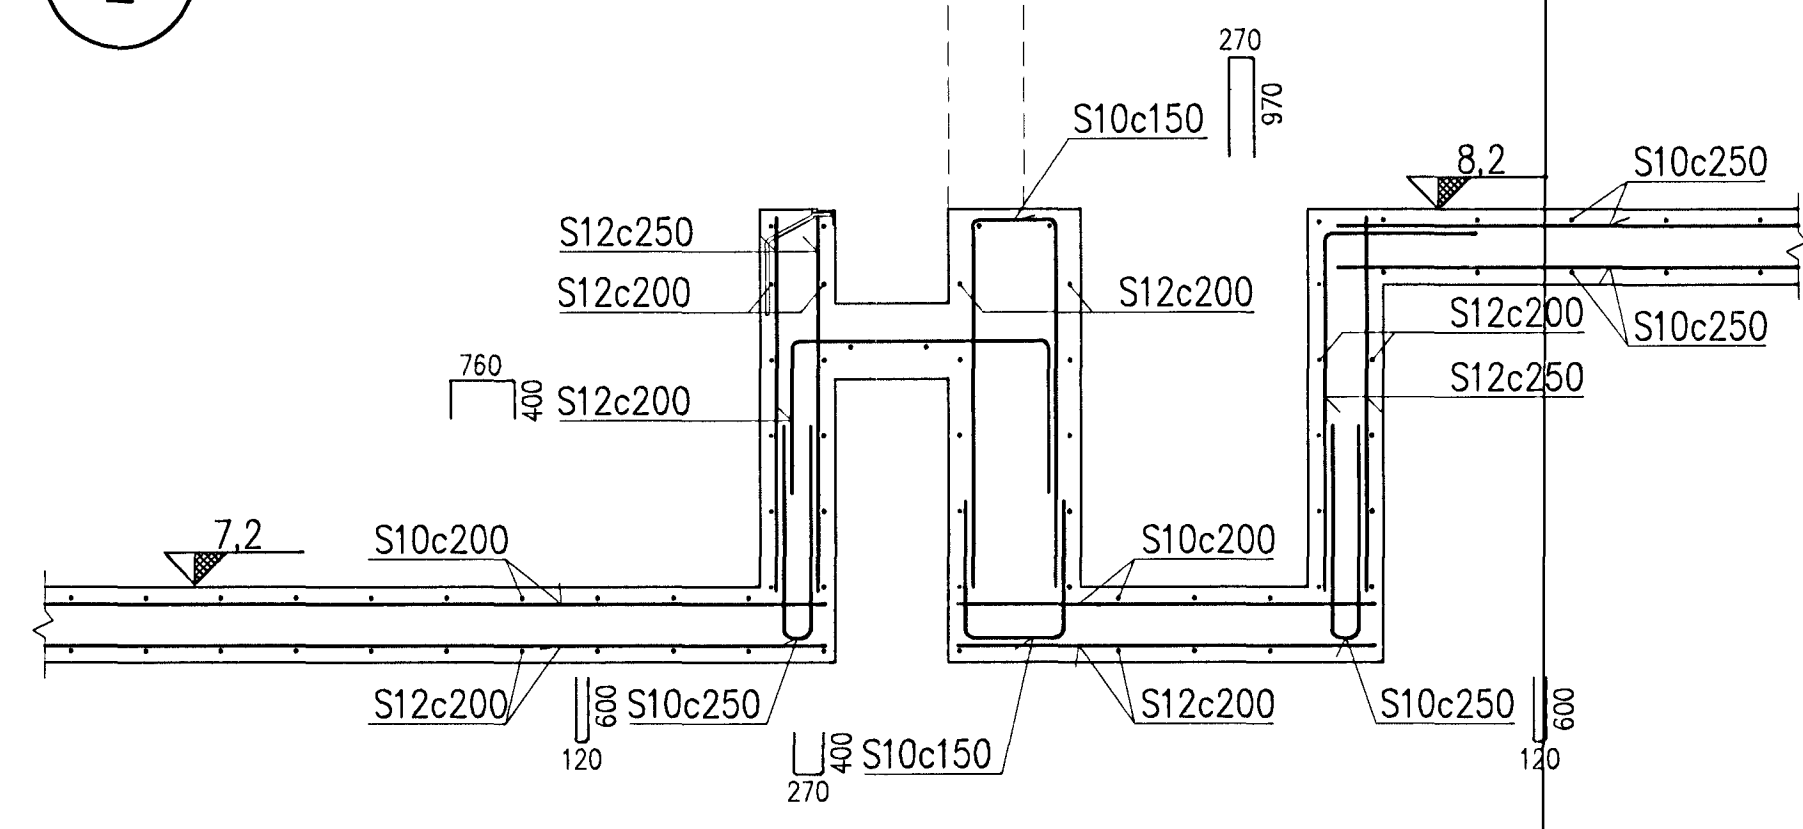

D SECTION 1:20

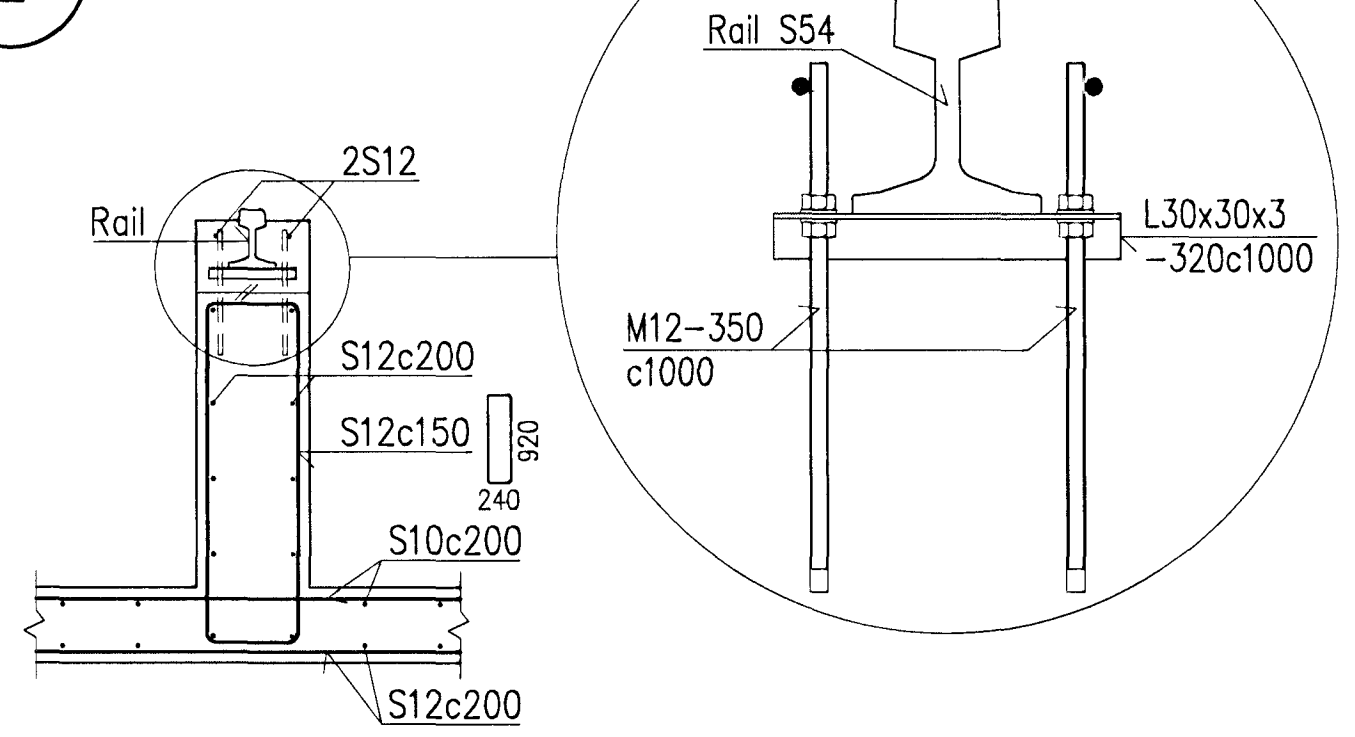

Electrical grounded see drawings  
 no IDP-410-FH-073-001 and  
 IDP-410-FH-073-002

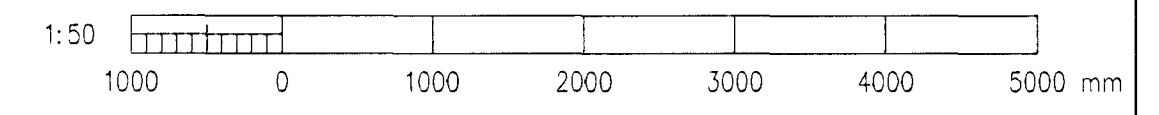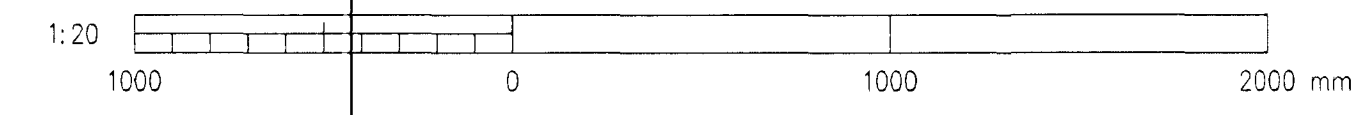

Skýringar:  
 Legend:

Concrete: C30/37: XF3	Also see IDP-410-CA-000-030 for concrete
Formed surfaces: F2	and IDP-410-ZA-000-060 for steel.
Reinforcement steel: B500C	
Structural steel: S235JR	
Insulation: Rockwool	

15	As Built	2012.02.27	CMG	NI	AKJ	AKJ			
		Date	Des/Drw	Old	Suppl	Rel	ISAL	Rel	

Dagsetning / Date		2009.01.08	
Hannað / Designed	Tekn / Drawn	HFB	ÁFV
Verktaki / Supplier	HRV		
Tekn.nr.verktaka / Supplier drw.no.	IDP-410-C0-073-287		
Samþykkt / Approved	Yfir / Chkd	NI	NI
Húti af: / Part of:			

IPU 410 - SUBSTATION PL3 - BOOSTER BUILDING FOUNDATIONS & FLOOR SLAB		Flokkur nr.: Blað nr.:	Næsta blinn.:
		Kostn.nr.-Ccon. / Bún.nr.-Eq.no	4011 16784
		AKS	UB136
RioTinto Alcan		ISAL Tekn.nr. ISAL / Drw.no. of ISAL	251314
		Breyt./Rev.	A
ISAL Yfirráð og skráð. dags. / ISAL Checked, date			
ISAL Sampykkt. dags. / ISAL Approval, date			