Samþykkt þann
02 OCT 2012
Byggingafulltrúinn í Hafnarfirði
F.h. Sigurður Steinar Jónsson

Nick Indriðason
Kt. 181144-3949 NI

PLAN 1:50

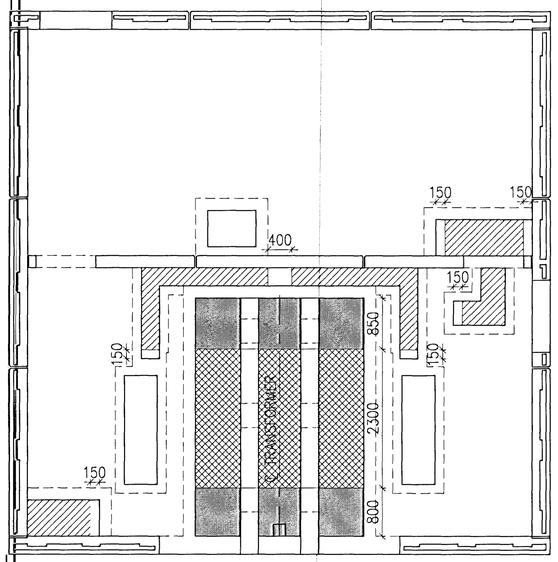

J / 284 SECTION 1:20

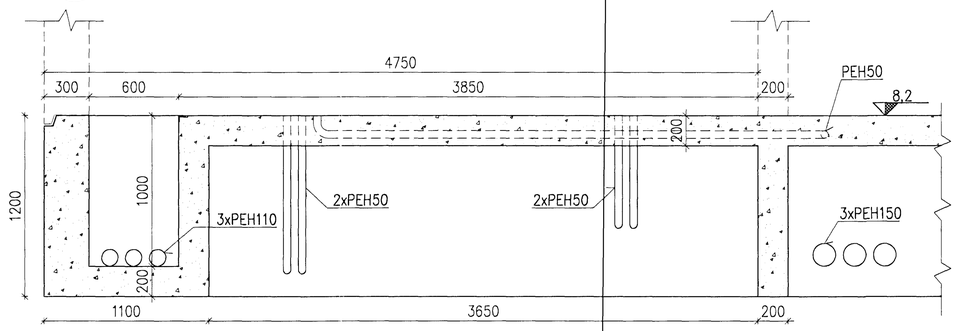

1 / 284 DETAIL 1:10
Type I

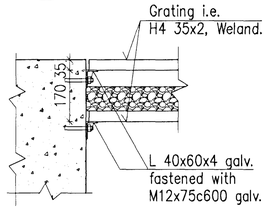

2 / 284 DETAIL 1:5
Used where wall is

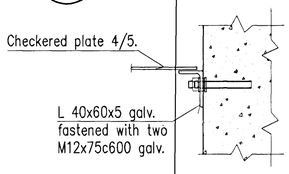

3 / 284 DETAIL 1:5

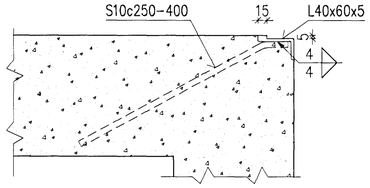

4 / 284 DETAIL 1:10
Type II

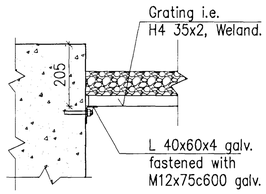

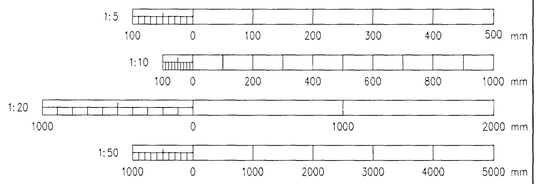

Skýringar
Legend:

- Grating type I
- Checkered plate 4/5
- Grating type II

C:\IDP\01 IDP\400 - Reduction\410 Substation\Drawings\Civil\IDP-410-C0-073-286.dwg

Útg nr / Rev no	Lýsing / Description	Dagsetning / Date	Han/Tkn / Des/Drw	Yfirf / Ckd	Notk heim / Suppl Rel	Notk heim / ISAL Rel
14	As Built	2012.02.27	GMG	NI	[illegible]	[illegible]

This drawing is the property of Rio Tinto Alcan Iceland Ltd. and handed out for personal use only. It may neither be copied nor made available to others without permission of Rio Tinto Alcan Iceland Ltd. The receiver is liable for any misuse.

Stærð: / Format: A1 Mkv.: / Scale: 1:5,10,20,50
Dimensions without tolerances according to ISO 2768-1 medium.

HRV & HATCH JOINT VENTURE
ISAL PRODUCTION UPGRADE

Dagsetning / Date: 2009.01.08
Hannað / Designed: HFB
Teikn / Drawn: ÁFV
Verktaki / Supplier: HRV
Teikn.nr.verktaka / Supplier drw.no.: IDP-410-C0-073-286
Samþykkt / Approved: NI
Yfirf / Chkd: NI
Hluti af: / Part of:

IPU 410 - SUBSTATION
PL3 - BOOSTER BUILDING
PLAN, SECTION & DETAILS

Teg.teikningar / Dwg. type: FOUNDATIONS & FLOOR SLAB

Rio Tinto Alcan
ISAL Alcan Iceland Ltd Straumsvik IS-222 Hafnarfjordur Iceland

Flokkur nr.: | Blað nr.: | Nesta bl.nr.:
Kostn.nr.-Cono. / Bún.nr.-Eq.no: 4011 16784
AKS: UB136
Teikn.nr. ISAL /Drw.no. of ISAL: 251313
Breyt./Rev.: A

ISAL Yfirfarið og skráð, dags / ISAL Checked, date
ISAL Samþykkt, dags / ISAL Approval, date