1205 334

FLOOR PLAN

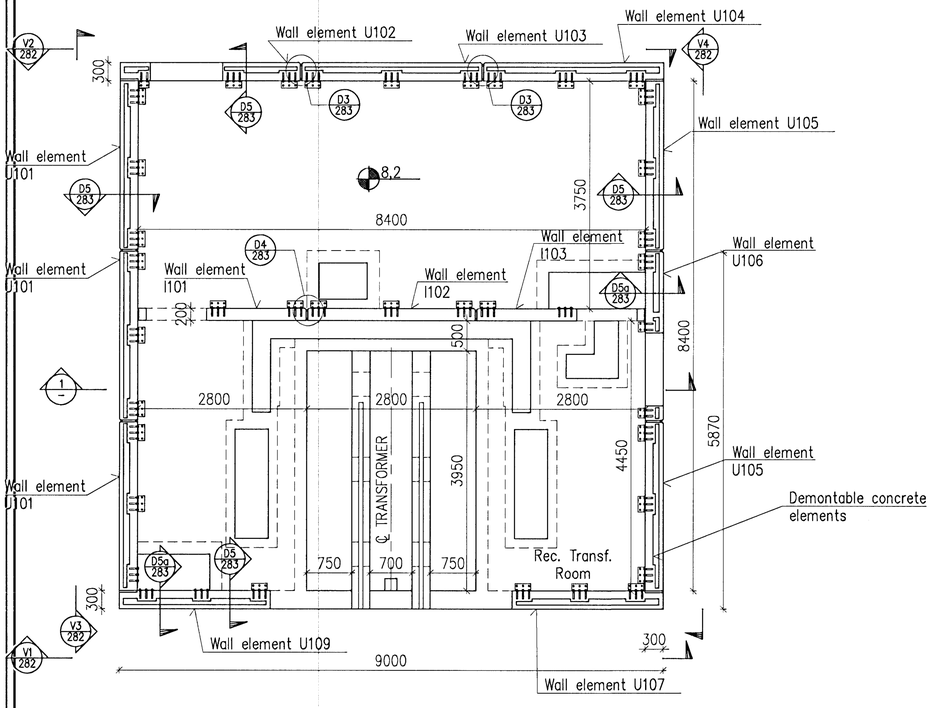

ROOF PLAN

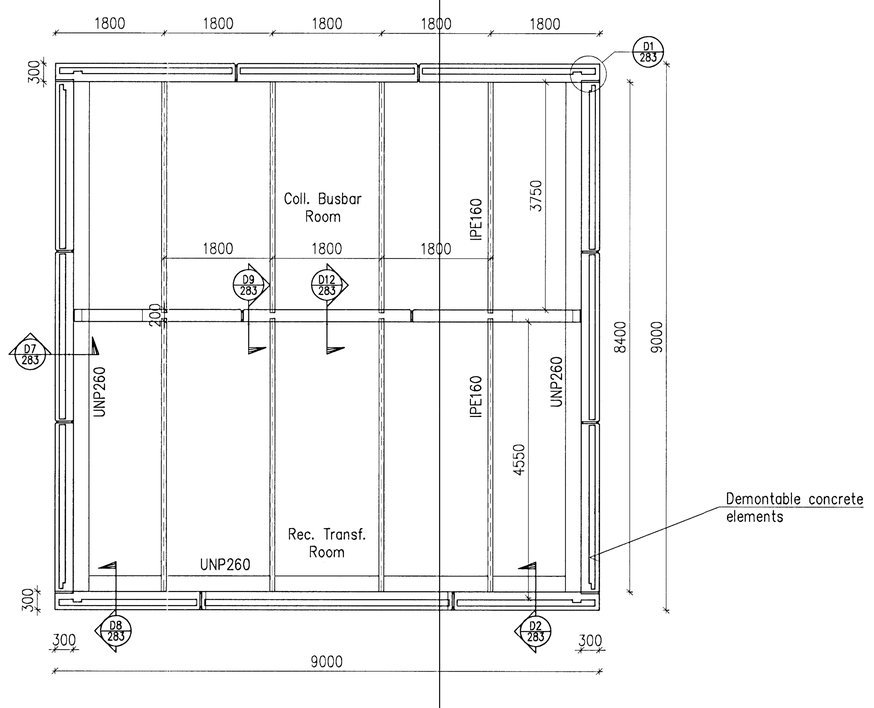

1/– SECTION

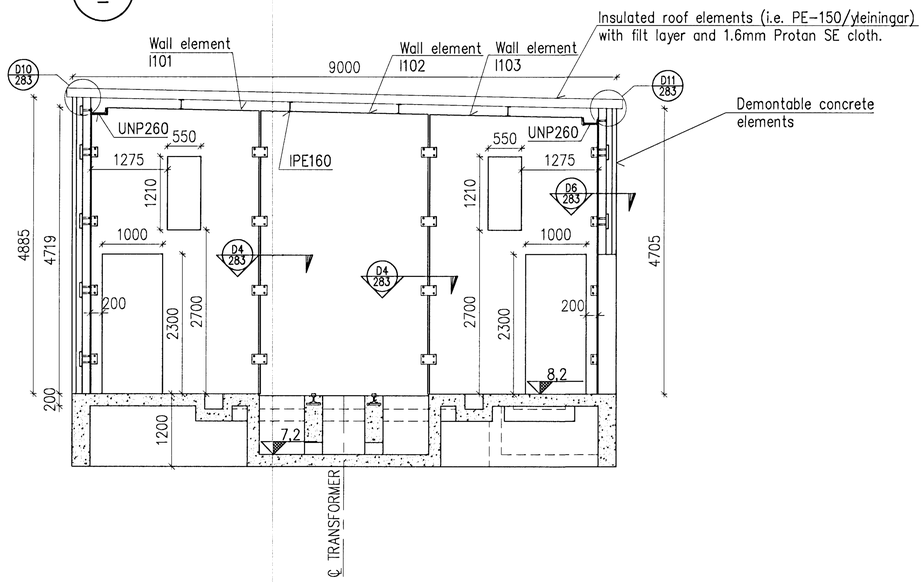

Samþykkt þann
02 OCT 2012
Byggingafulltrúinn í Hafnarfirði
F.h. Sigurður Steinar Jónsson

Niels Indriðason
Kt. 181144-3949 NI

1:50
1000 0 1000 2000 3000 4000 5000 mm

Skýringar:
Legend: All detailing for walls and roofelements not shown on the drawing shall be according to manufactorers instructions and approwed by the engineer.

C:\IDP\01 IDP\400 - Reduction\410 Substation\Drawings\Civil\IDP-410-C0-073-281.dwg

Stg. nr Rev no	Lýsing Description	Dagsetning Date	Han/Tkn Des/Drw	Yfirf Ckd	Nótk heim Suppl Ref	Nótk heim ISAL Ref
16	As Built	2012.02.27	GMG	NI	BG.	

This drawing is the property of Rio Tinto Alcan Iceland Ltd. and handed out for personal use only. It may neither be copied nor made available to others without permission of Rio Tinto Alcan Iceland Ltd. The receiver is liable for any misuse.

Stærð: Format: A1 Mkv.: Scale: 1:50
Dimensions without tolerances according to ISO 2768-1 medium.

HRV & HATCH JOINT VENTURE ISAL PRODUCTION UPGRADE

Dagsetning / Date: 2009.01.08
Hannað / Designed: HFB | Teikn / Drawn: ÁFV
Verktaki / Supplier: HRV
Teikn.nr.verktaka / Supplier drw.no.: IDP-410-C0-073-281
Samþykkt / Approved: NI | Yfirf / Chkd: NI
Hluti of: / Part of:

IPU 410 – SUBSTATION
PL3 – BOOSTER BUILDING
FLOOR & ROOF PLANS & SECTION
Tegj.teikningar / Dwg. type: PRECAST STRUCTURE

Flokkur nr.: | Blað nr.: | Næsta bl.nr.:
Kostn.nr.-Cono. / BGN.nr.-Eq.no: 4011 16784
AKS: UB136
Teikn.nr. ISAL /Drw.no. of ISAL: 251308 | Breyt./Rev.: A

Rio Tinto Alcan
ISAL Alcan Iceland Ltd Straumsvík IS-222 Hafnarfjordur Iceland

ISAL Yfirfarið og skoðað, dags / ISAL Checked, date
ISAL Samþykkt, dags / ISAL Approval, date