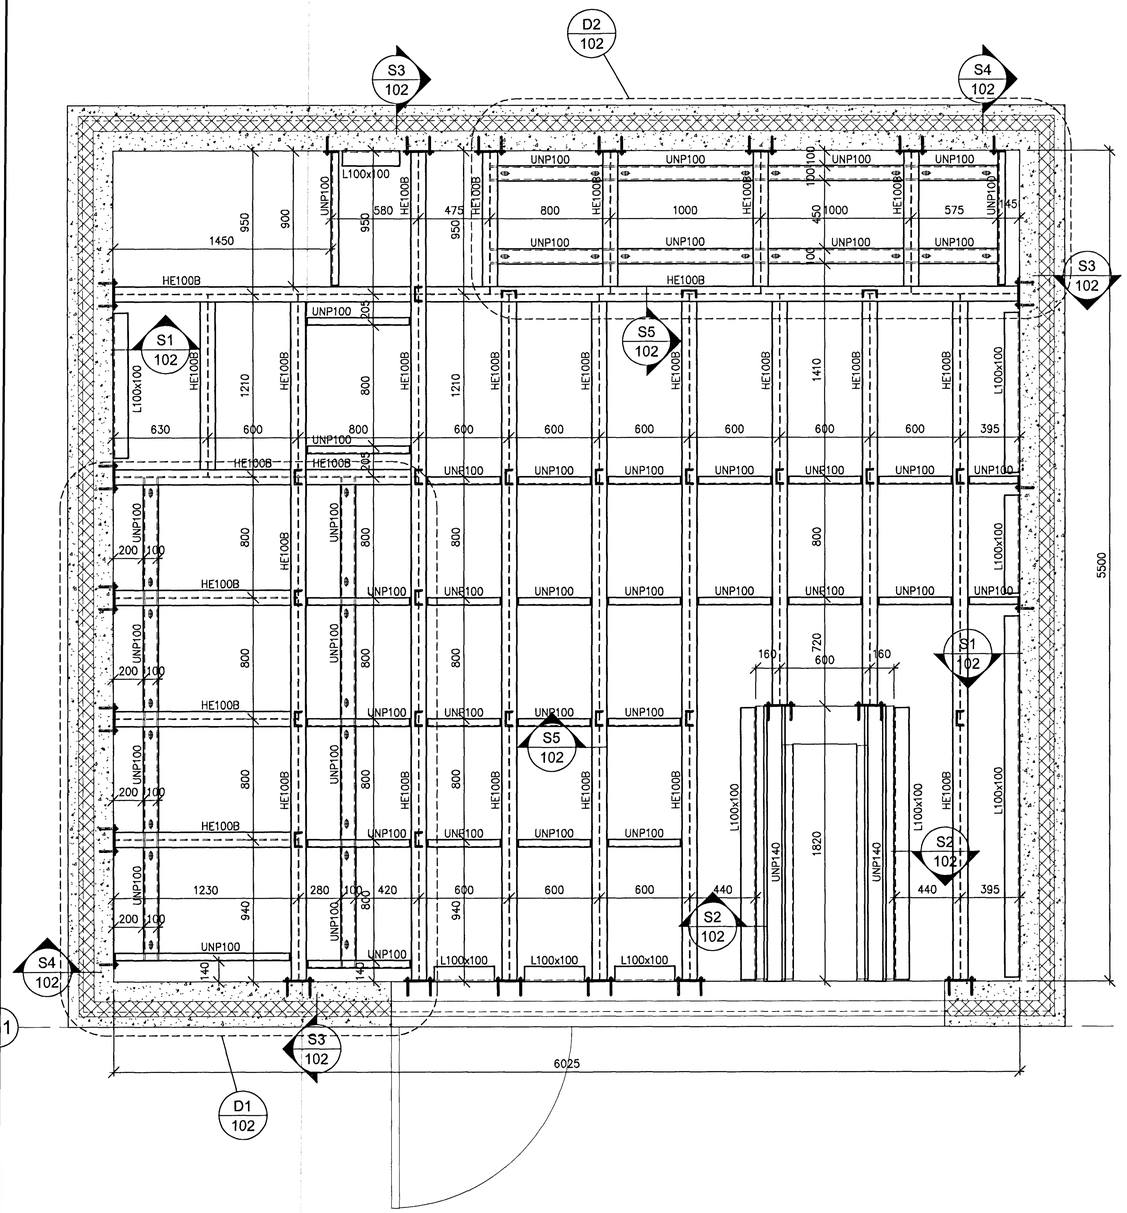

- / - PLAN LEVEL (EL 5,80)
1:20

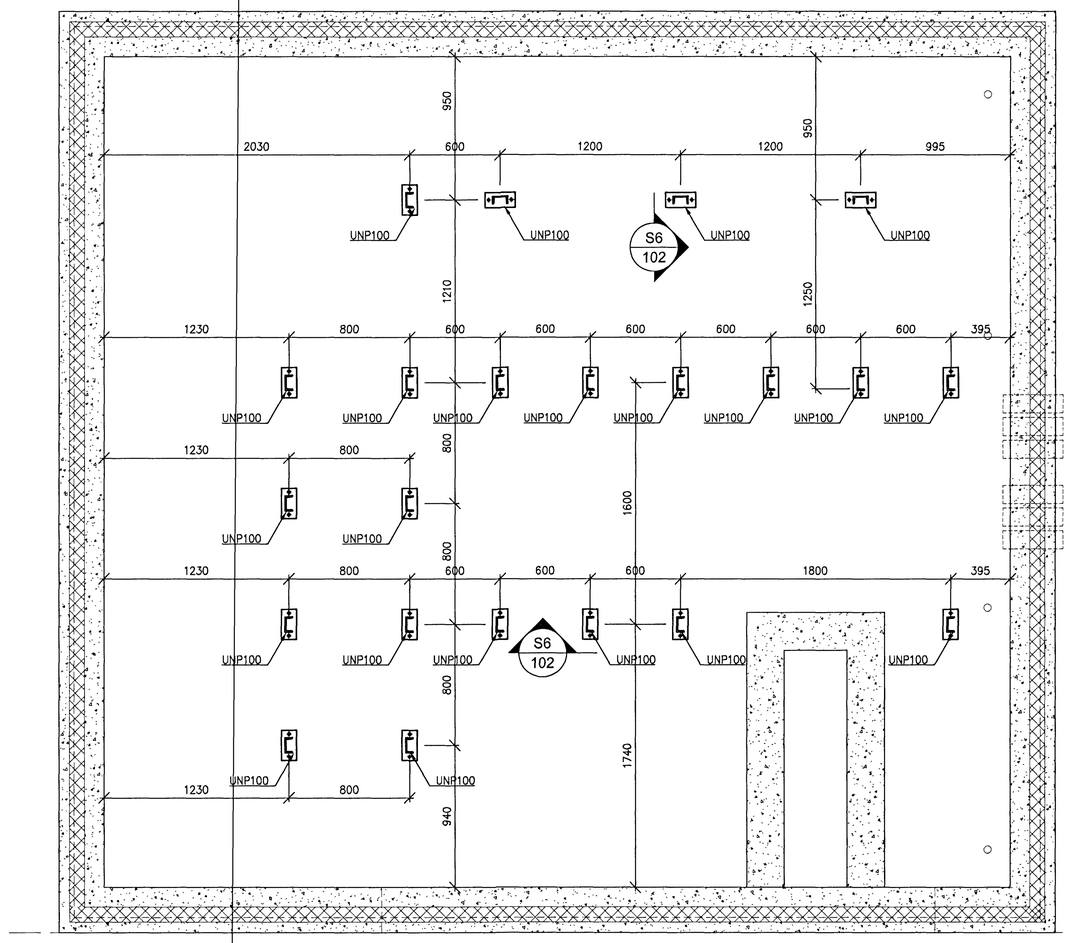

- / - PLAN LEVEL (EL 4,60)
1:20

Samþykkt þann
02 OCT 2012
Byggingafulltrúinn í Hafnarfirði
F.h. Sigurður Steinar Jónsson

Nicki Indriðason
Kt. 181144-3949

1:20
1000 0 1000mm

Skýringar:
Legend:

PERMISSIBLE TOLERANCE UNLESS OTHERWISE SPECIFIED

Tolerance for laying the floor frame are:
Evenness tolerance: 1 mm within a measuring of 1 m.
Straightness tolerance: ±1 mm per 1 m, but not more than 3 mm over entire length of 3 m.

WELDING QUALITY UNLESS OTHERWISE SPECIFIED

Welding quality: Level C according to IST EN ISO 5817
Steel: According to IST EN ISO 5817

FOR FILLET WELDS a=0,7x tmin gmin=4 mm

FOR BUTT WELDS COMPLETE PENETRATION WELDS 60°

Rev no	Lýsing / Description	Dagsetning / Date	Han/Tkn / Des./Drn.	Yfirf / Chkd	Notk heim / Suppl. Ref	Notk heim / ISAL Ref.
4	As Built	2012.02.16	GMG	NI	FH	GÁS

This drawing is the property of Rio Tinto Alcan Iceland Ltd. and handed out for personal use only it may neither be copied nor made available to others without permission of Rio Tinto Alcan Iceland Ltd. The receiver is liable for any misuse.

Stærð / Format: A1 Mkv. / Scale: 1:20

Dimensions without tolerances according to ISO 2768-1 medium.

HRV & HATCH JOINT VENTURE ISAL PRODUCTION UPGRADE

Dagsetning / Date	2010.05.28
Hannað / Designed	HFB
Teikn / Drawn	HFB/AFV
Verktaki / Supplier	HRV
Teikn.nr.verktaka / Supplier drw.no.	ICC-212-CA-517-101
Samþykkt / Approved	NI
Yfirf / Chkd	HJH
Hluti af: / Part of:	

IPU 212
SUBSTATION 61
FLOOR, PLANS
Teg.teikningar / Dwg. type: STRUCTURAL STEEL

Rio Tinto Alcan
ISAL
Alcan Iceland Ltd
Straumsvík
IS-222 Hafnarfjörður
Iceland

ISAL Yfirfarið og skráð, dags / ISAL Checked, date
ISAL Samþykkt, dags / ISAL Approval, date

Flokkur nr.:	Bið nr.:	Nesta bl.nr.:
Kostn.nr.-Ccno. /	Bún.nr.-Eq.no	
4011	16940	
AKS		
UB61		
Teikn.nr. ISAL /Drw.no. of ISAL		Breyt./Rev.
260556		A

C:\IDP\03 ICC\200 Utilities\Drawings\Civil\ICC-212-CA-517-101.dwg