5 / 620 SECTION 1:100

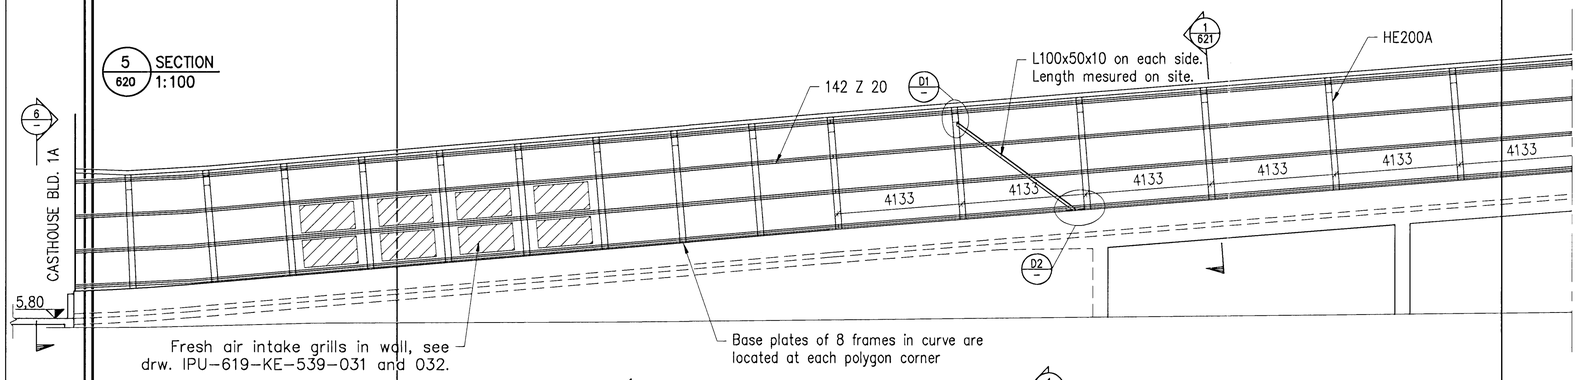

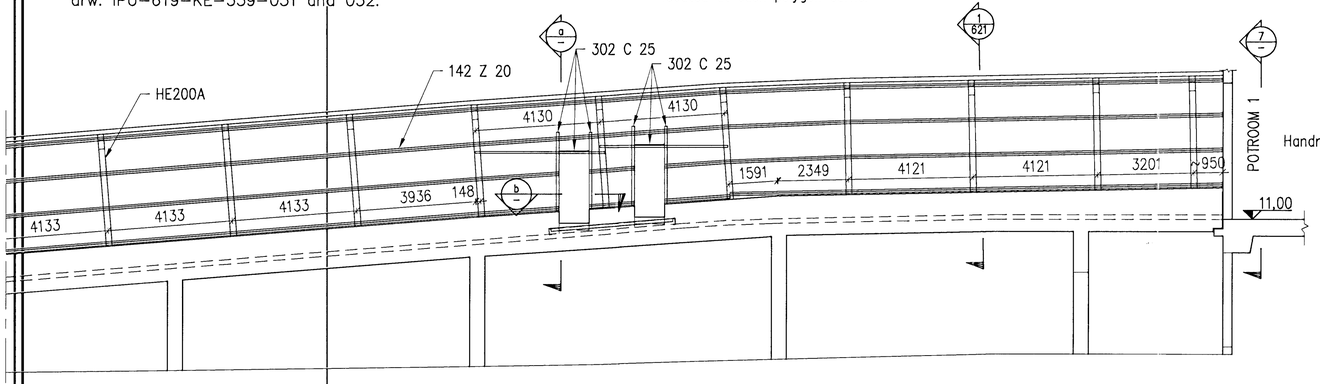

a / – SECTION 1:20

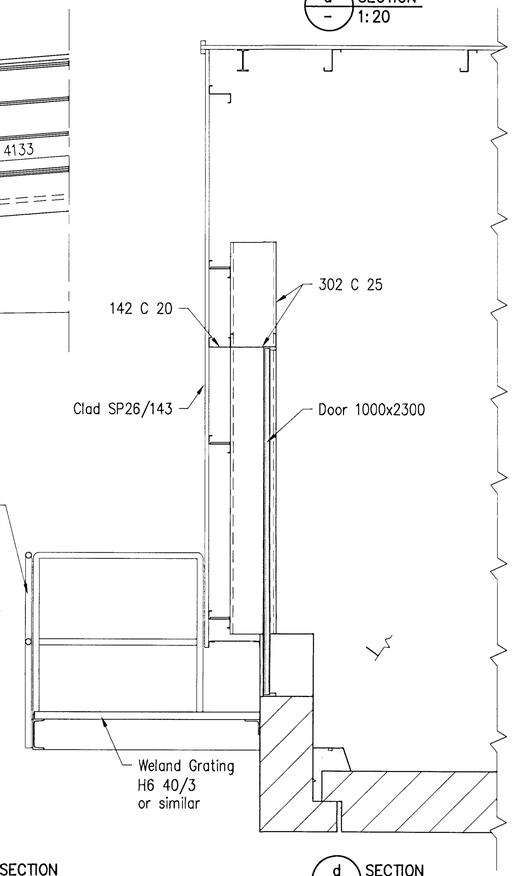

Samþykkt þann 02 OCT 2012
Byggingafulltrúinn í Hafnarfirði
F.h. Sigurður Steinar Jónsson

D1 / – SECTION 1:10

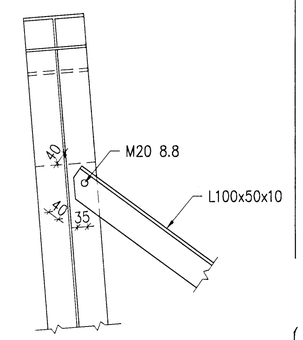

D2 / – SECTION 1:10

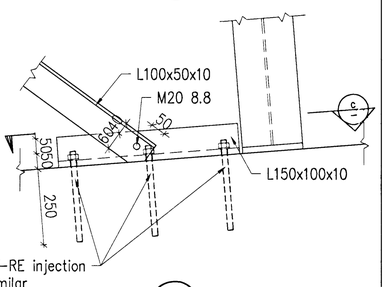

6 / 620 SECTION 1:50

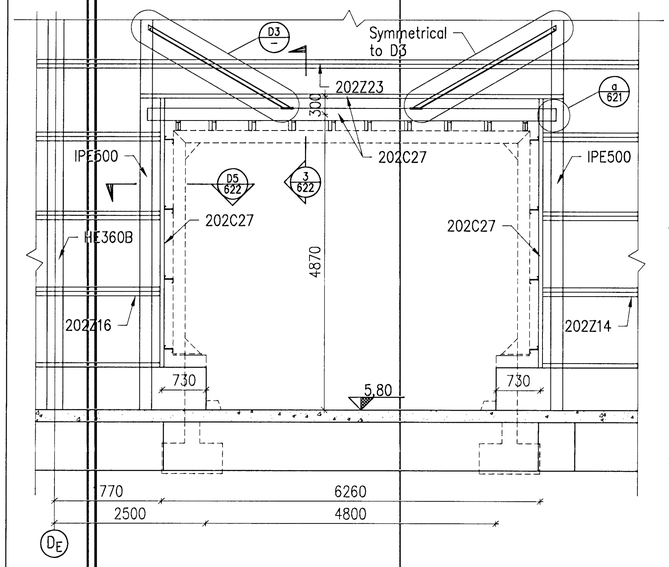

7 / 620 SECTION 1:50

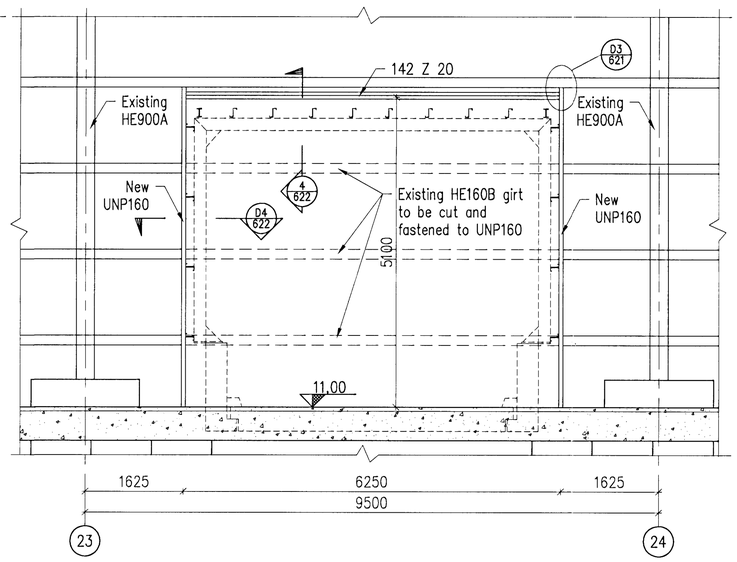

D3 / – SECTION 1:10

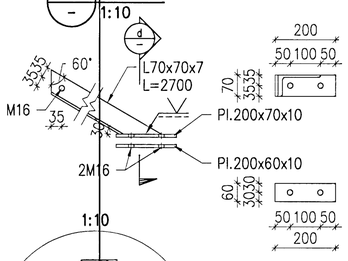

d / – SECTION 1:5

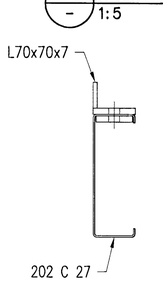

c / – SECTION 1:10

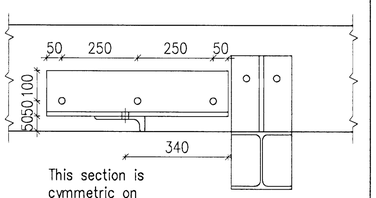

1:10

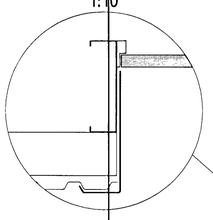

b / – SECTION 1:20

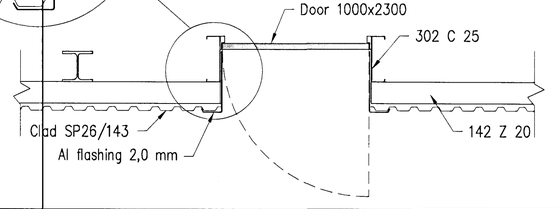

1:5 250 0 250mm
1:10 500 0 500mm
1:20 1000 0 1000mm
1:100 5 0 5m

Skýringar: GENERAL NOTES see drawing ICC-611-CA-541-600
Legend:

C:\DP\03 ICC\600 Casting\600 Drawings\Civil\ICC-611-ZA-541-623.dwg

Dfg nr Rev no	Lýsing Description	Dagsetning Date	Han/Tkn Des/Drw	Yfirf Ckd	Nota heim Suppl Rel	Nota heim ISAL Rel
B	Record Drawing	2012.07.23	HS	NI	FG	

This drawing is the property of Rio Tinto Alcan Iceland Ltd. and handed out for personal use only. It may neither be copied nor made available to others without permission of Rio Tinto Alcan Iceland Ltd. The receiver is liable for any misuse.

Stærð Format: A1 Mkv. Scale: 1:5/10/20/100
Dimensions without tolerances according to ISO 2768-1 medium.

HRV & HATCH JOINT VENTURE ISAL PRODUCTION UPGRADE

Dagsetning / Date	2011.04.07
Hannað / Designed	HS
Teikn / Drawn	AFV
Verktaki / Supplier	HRV
Teikn.nr.verktaka / Supplier drw.no.	ICC-611-ZA-541-623
Samþ.Akt / Approved	NI
Yfirf / Chkd	NI
Hluti af: / Part of:	

IPU-CASTHOUSE EXTENSION BUILDINGS, RAMPS
RAMP 1
SIDE VIEW
Teg.teikningar / Dwg. type: STEEL STRUCTURE

Rio Tinto Alcan
ISAL Alcan Iceland Ltd Straumsvík IS-222 Hafnarfjordur Iceland

ISAL Yfirfarið og samþ. dags / ISAL Checked, date
ISAL Samþykkt, dags / ISAL Approval, date

Flokkur nr.:	Blað nr.:	Næsta bl.nr.:
Kostn.nr.-Cono. / BGn.nr.-Eq.no		
5010	16957	
AKS		
UF002		
Teikn.nr. ISAL /Drw.no. of ISAL		Breyt./Rev.
253549		A