Samþykkt þann
02 OCT 2012
Byggingafulltrúinn í Hafnarfirði
F.h. Sigurður Steinar Jónsson

Nicki Indriðason
Kt. 181144-3949 NI

1 / 620 SECTION 1:50

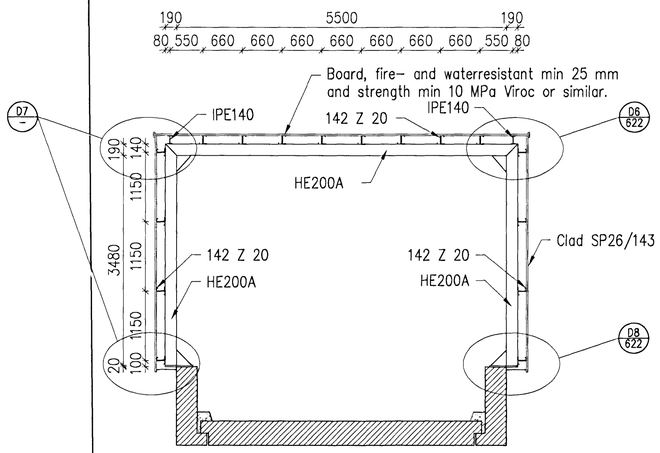

D2 / 620 DETAIL 1:10

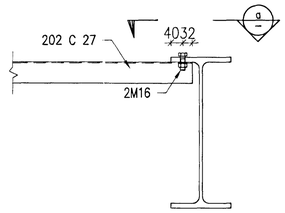

a / – SECTION 1:10

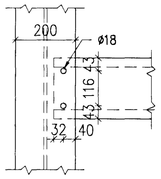

D3 / 623 DETAIL 1:10

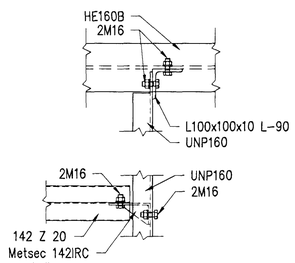

D4 / 620 DETAIL 1:10

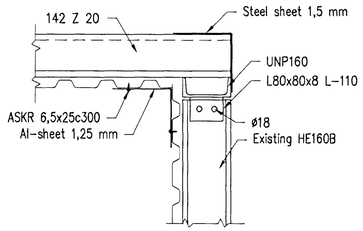

D7 / – DETAIL 1:10

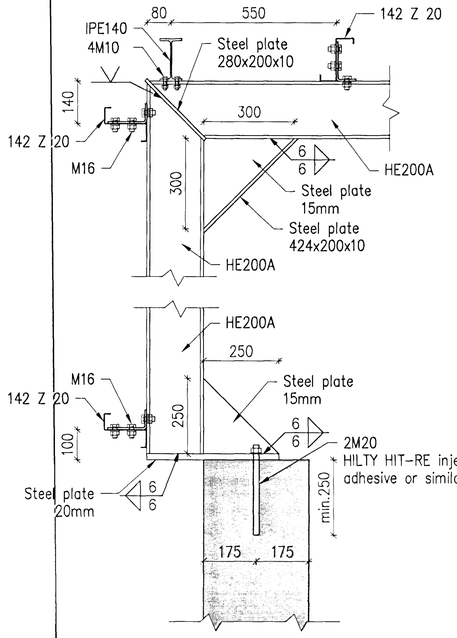

1:50 2500 0 2500mm
1:10 500 0 500mm
1:5 250 0 250mm

Skýringar: GENERAL NOTES see drawing ICC-611-CA-541-600
Legend:

C:\IDP\03 ICC\600 Casting\600 Drawings\Civil\ICC-611-ZA-541-621.dwg

Útg.nr Rev.no	Lýsing Description	Dagsetning Date	Hön/Ðkn Des/Drw	Yfirf Ckd	Notk.heim Suppl.Ref	Notk.heim ISAL Ref
7	Record Drawing	2012.07.23	HS	NI	FG	RAS

This drawing is the property of Rio Tinto Alcan Iceland Ltd. and handed out for personal use only. It may neither be copied nor made available to others without permission of Rio Tinto Alcan Iceland Ltd. The receiver is liable for any misuse.

Stærð / Format: A1 Mkv.: / Scale: 1:50,10,5
Dimensions without tolerances according to ISO 2768-1 medium.

HRV & HATCH JOINT VENTURE
ISAL PRODUCTION UPGRADE

Dagsetning / Date	2011.04.07
Hannað / Designed	HS
Teikn / Drawn	LDB
Verktaki / Supplier	HRV
Teikn.nr.verktaka / Supplier drw.no.	ICC-611-ZA-541-621
Samþykkt / Approved	NI
Yfirf / Chkd	NI
Hluti af: / Part of:	

IPU-CASTHOUSE EXTENSION BUILDINGS, RAMPS
RAMP 1
SECTIONS AND DETAILS
Teg.teikningar / Dwg. type: STEEL STRUCTURE

Flokkur nr.:	Blað nr.:	Næsta blnr.:

Kostn.nr.-Cono. / Bún.nr.-Eq.no: 5010 16957
AKS: UF002
Teikn.nr. ISAL /Drw.no. of ISAL: 253547
Breyt./Rev.: A

Rio Tinto Alcan
ISAL
Alcan Iceland Ltd
Straumsvík
IS-222 Hafnarfjordur
Iceland

ISAL Yfirfarið og skráð, dags / ISAL Checked, date
ISAL Samþykkt, dags / ISAL Approved, date