FOUNDATION F1
1:20

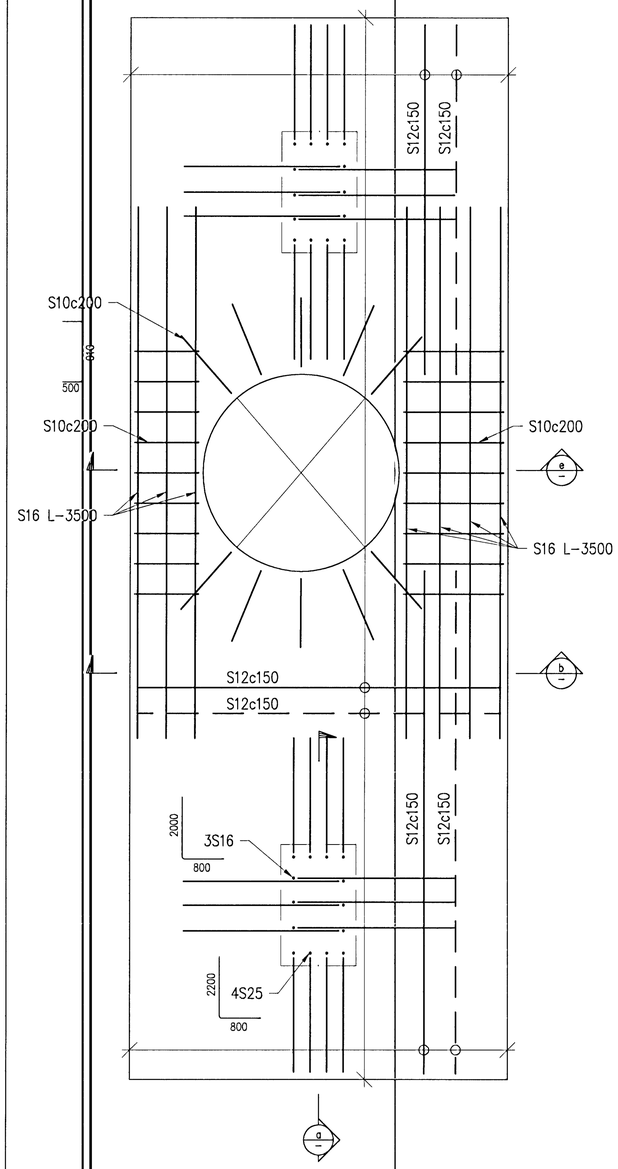

a SECTION
1:20

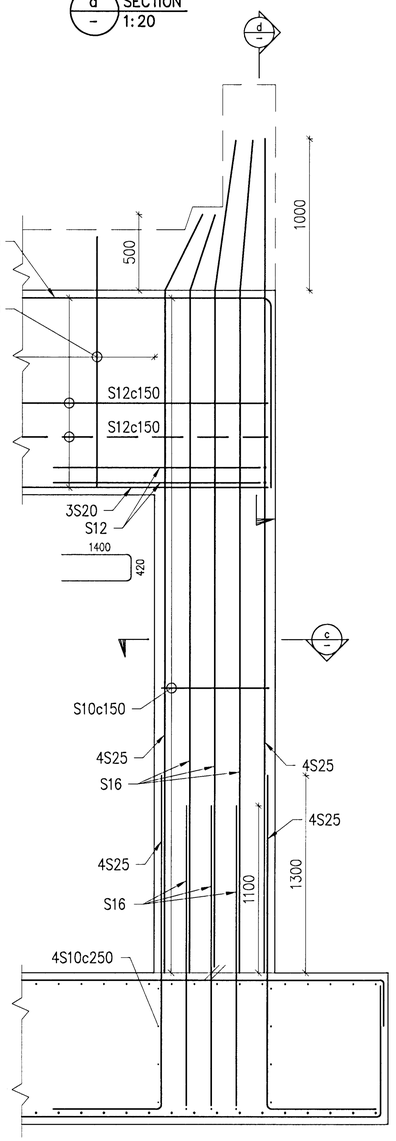

b SECTION
1:20

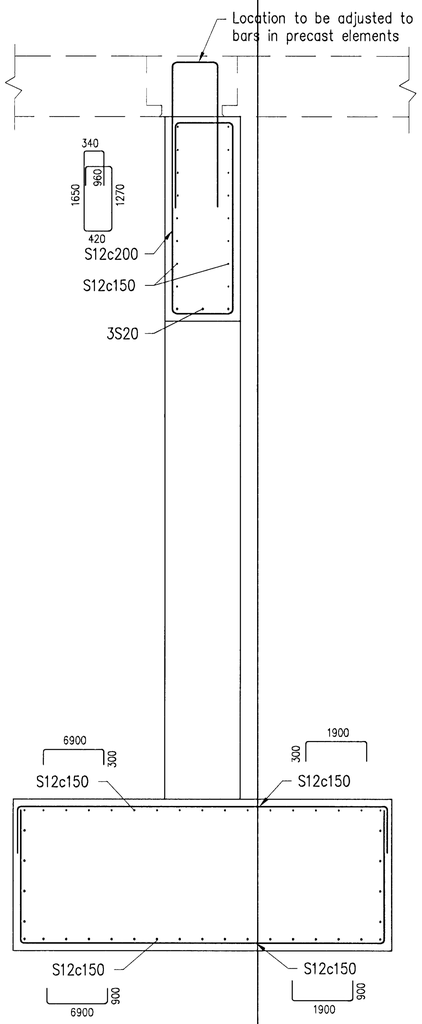

c SECTION
1:20

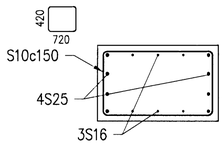

d SECTION
1:20

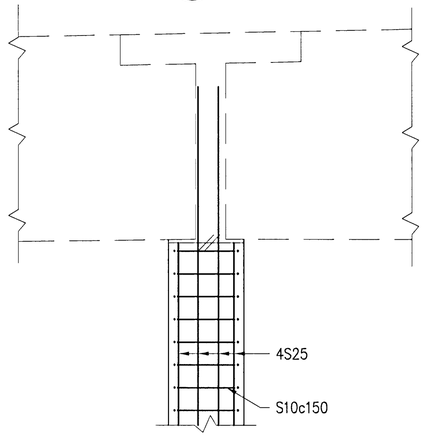

e SECTION
1:20

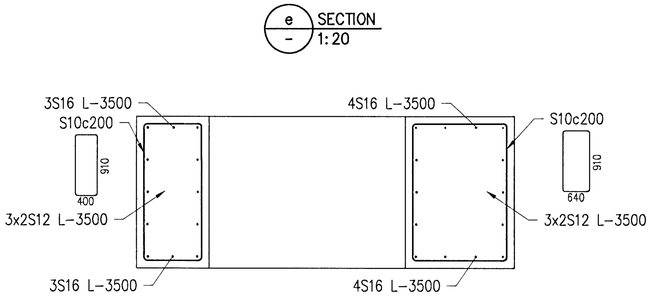

Samþykkt þann
02 OCT 2012
Byggingafulltrúinn í Hafnarfirði
F.h. Sigurður Steinar Jónsson

Nicki Indriðason
Kt. 181144-3949
NI

1:20
1000 0 1000mm

Skýringar: GENERAL NOTES see drawing ICC-611-CA-541-600
Legend: CONCRETE: C30/37:XF3-38

Concrete cover for reinforcement (tolerances acc. to FSENV1992)
Top of slab with traffic 60 mm
except slab on filling 40 mm

C:\IDP\04 IPU\099 As-built EPCM\600\ICC-611-CA-541-612-6.dwg

Útg.nr Rev.no	Lýsing Description	Dagsetning Date	Han/Tkn Des/Drw	Yfirf Ckd	Notk.heim Suppl.Ref	Notk.heim ISAL Ref
6	Record Drawing	2012.07.23	GMG	NI	FG	

This drawing is the property of Rio Tinto Alcan Iceland Ltd. and loaned out for personal use only. It may neither be copied nor made available to others without permission of Rio Tinto Alcan Iceland Ltd. The receiver is liable for any misuse.

Stærð: Format: A1 Mkv.: Scale: 1:20
Dimensions without tolerances according to ISO 2768-1 medium.

HRV & HATCH JOINT VENTURE ISAL PRODUCTION UPGRADE

Dagsetning / Date: 2011.04.07
Hannað / Designed: HS/GMG
Teikn / Drawn: GMG
Verktaki / Supplier: HRV
Teikn.nr.verktaka / Supplier drw.no.: ICC-611-CA-541-612
Samþ.aðil / Approved: NI
Yfirf / Chkd: NI
Hluti af: / Part of:

IPU-CASTHOUSE EXTENSION BUILDINGS, RAMPS
RAMP 1
FOUNDATION F1
Teg.teikningar / Dwg. type: REINFORCEMENT

Flokkur nr.: | Blað nr.: | Næsta bl.nr.:
Kostn.nr.-Cono. / Bún.nr.-Eq.no: 5010 16957
AKS: UF002
Teikn.nr. ISAL /Drw.no. of ISAL: 253523
Breyt./Rev.: A

Rio Tinto Alcan
ISAL Alcan Iceland Ltd Straumsvík IS-222 Hafnarfjordur Iceland

ISAL Yfirfarið og skráð, dags / ISAL Checked, date
ISAL Samþykkt, dags / ISAL Approved, date