Samþykkt þann
02 OCT 2012
Byggingafulltrúinn í Hafnarfirði
F.h. Sigurður Steinar Jónsson

Nicki Indriðason
Kt. 181144-3949

1 / 602 SECTION 1:20

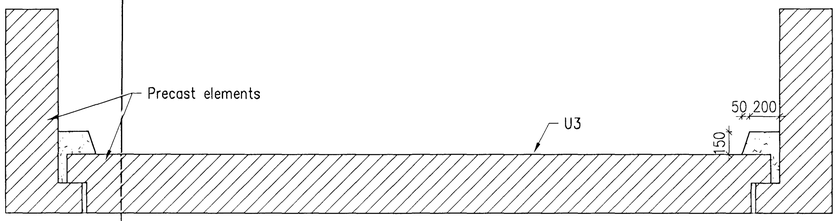

D1 / 602 DETAIL 1:20

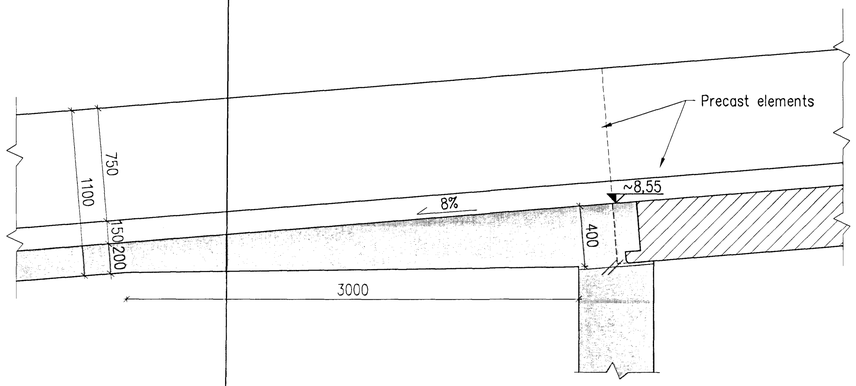

2 / 602 SECTION 1:20

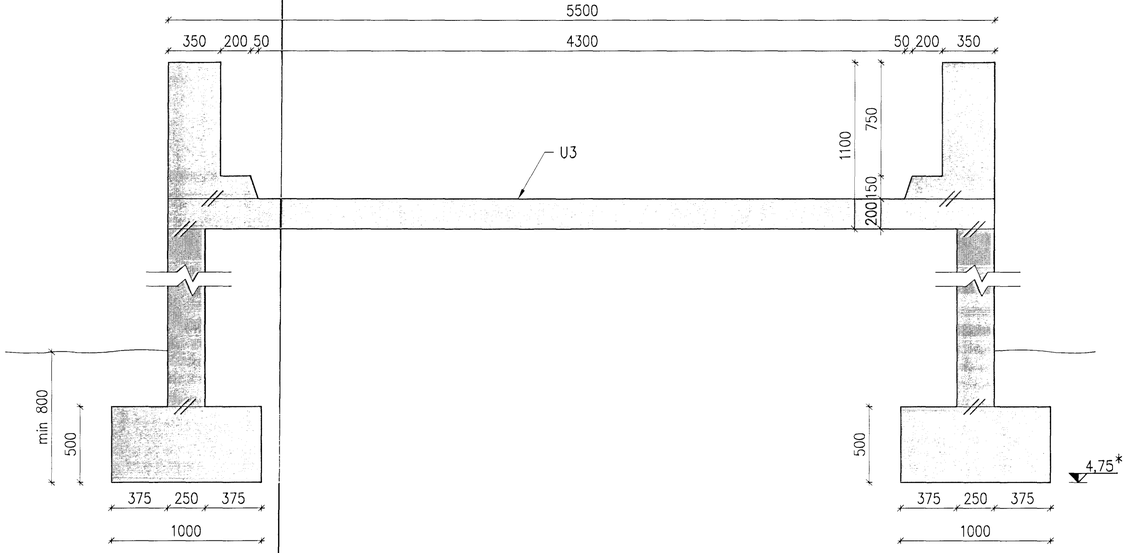

D2 / 602 DETAIL 1:10

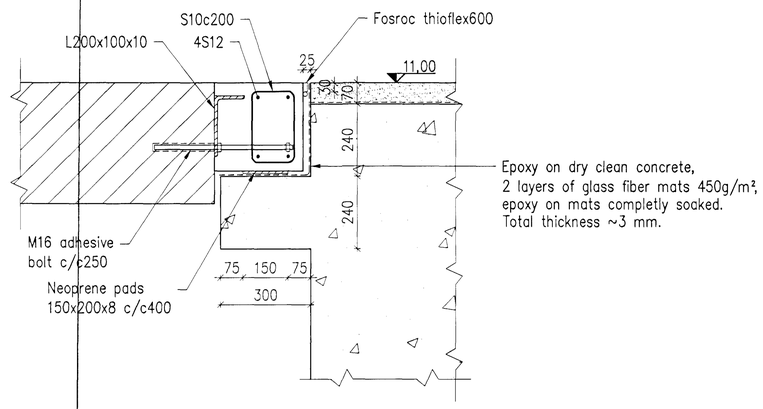

1:10
500 0 500mm

1:20
1000 0 1000mm

Skýringar: GENERAL NOTES see drawing ICC-611-CA-541-600

Legend: CONCRETE: C30/37:XF3-38

* Elevation of foundations on rock may differ (min. 800 from finished surface)

Precast elements are shown on contractors drawings

C:\IDP\03 ICE\600 Casting\600 Drawings\Civil\ICC-611-CA-541-607.dwg

Útg.nr Rev.no	Lýsing Description	Dagsetning Date	Hön/Tkn Des/Drw	Yfirf Chkd	Nótk heim Suppl Rel	Nótk heim ISAL Rel
6	Record Drawing	2012.07.23	GMG	NI	FG	

This drawing is the property of Rio Tinto Alcan Iceland Ltd. and handed out for personal use only it may neither be copied nor made available to others without permission of Rio Tinto Alcan Iceland Ltd. The receiver is liable for any misuse.

Stærð: Format A1 Mkv.: Scale: 1:20/10

Dimensions without tolerances according to ISO 2768-1 medium.

HRV & HATCH JOINT VENTURE
ISAL PRODUCTION UPGRADE

Dagsetning / Date: 2011.04.07
Hannað / Designed: HS/GMG
Teikn / Drawn: GMG
Verktaki / Supplier: HRV
Teikn.nr.verktaka / Supplier drw.no.: ICC-611-CA-541-607
Samþykkt / Approved: NI
Yfirf / Chkd: NI
Hluti af: / Part of:

IPU-CASTHOUSE EXTENSION BUILDINGS, RAMPS
RAMP 1
SECTIONS AND DETAILS
Teg.teikningar / Dwg. type: FORM WORK

Flokkur nr.: Bloð nr.: Næsta blnr.:
Kostn.nr.-Cono. / BGn.nr.-Eq.no: 5010 16957
AKS: UF002
Teikn.nr. ISAL /Drw.no. of ISAL: 253520
Breyt./Rev.: A

Rio Tinto Alcan
ISAL Álverið Straumsvík IS-222 Hafnarfjörður Iceland

ISAL Yfirfarið og skráð, dags / ISAL Checked, date
ISAL Samþykkt, dags / ISAL Approval, date