



Níels Indriðason
 Kt. 181144-3949
 NI

FOUNDATION F2
 1:20

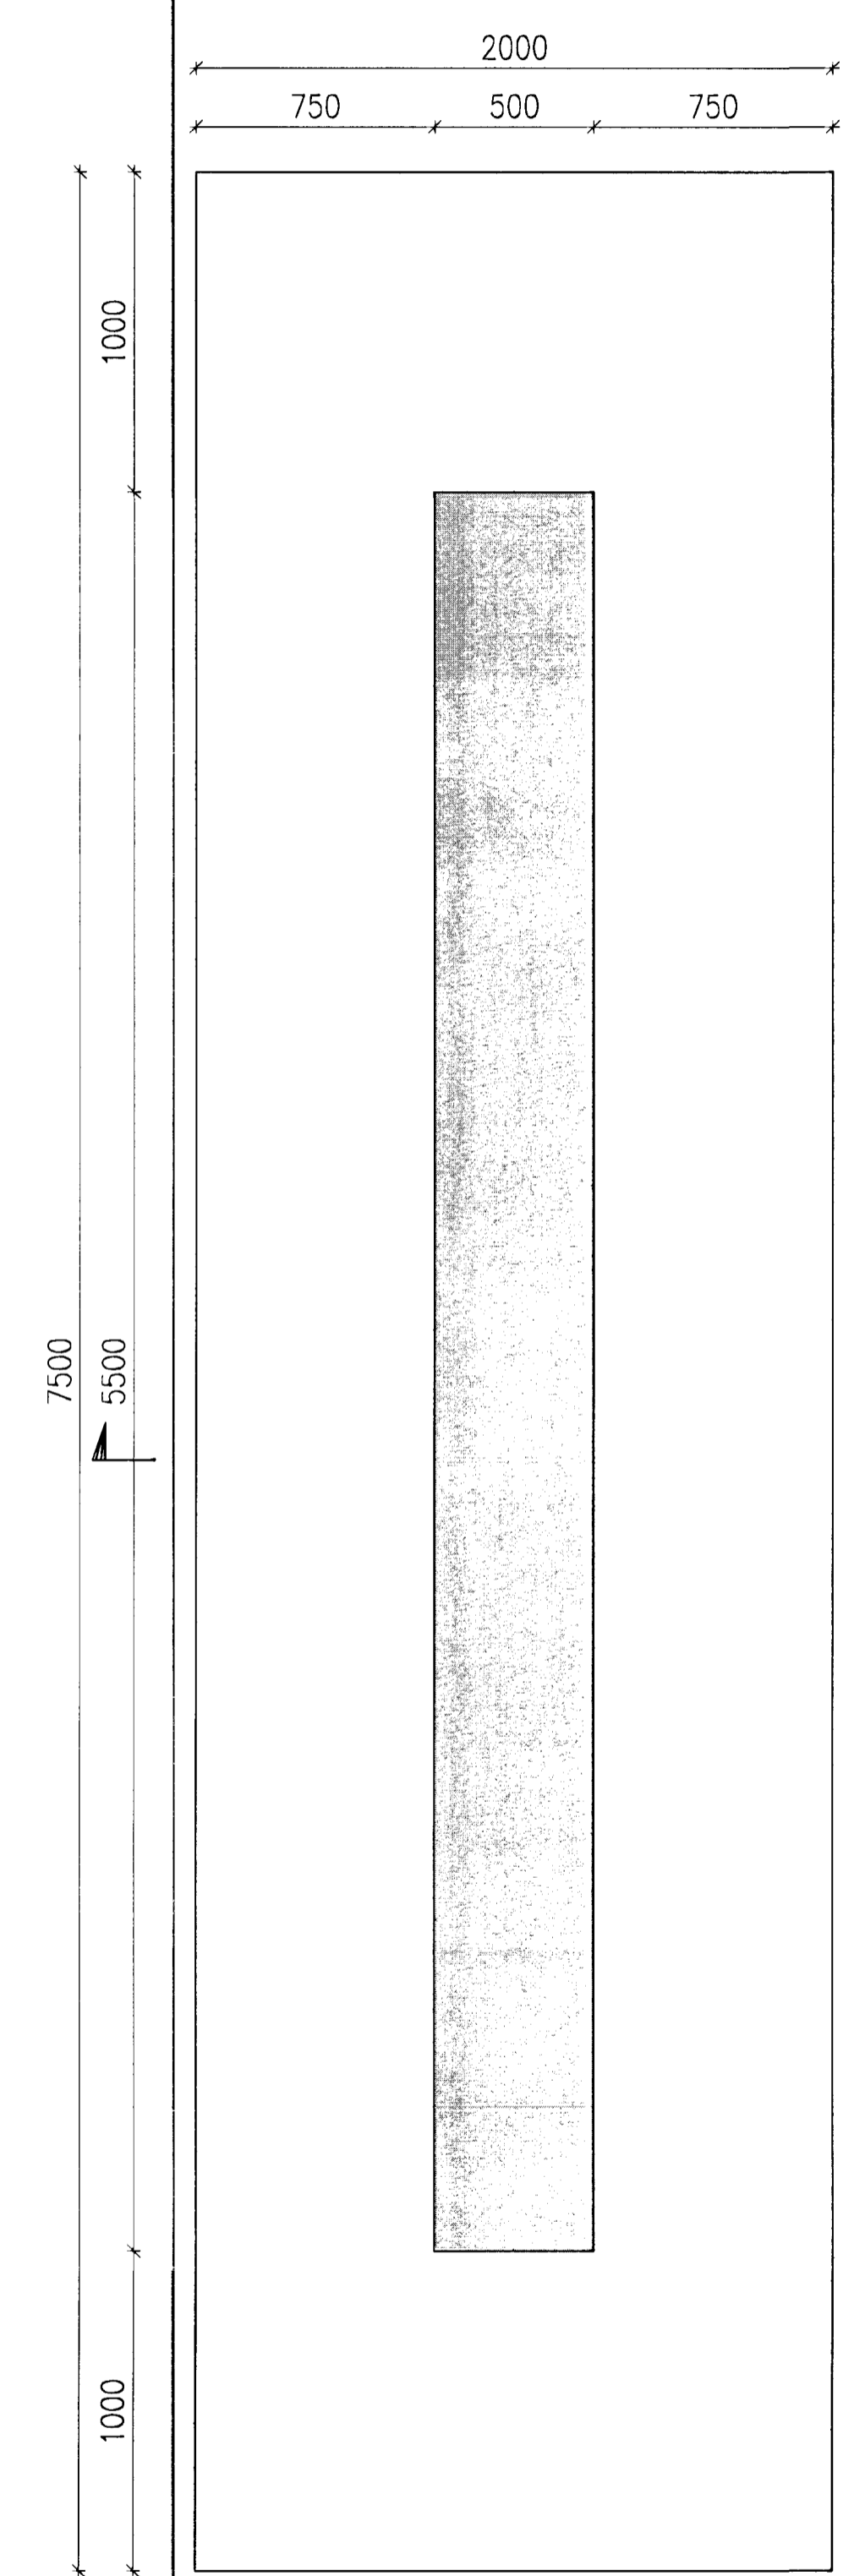

a SECTION
 1:20

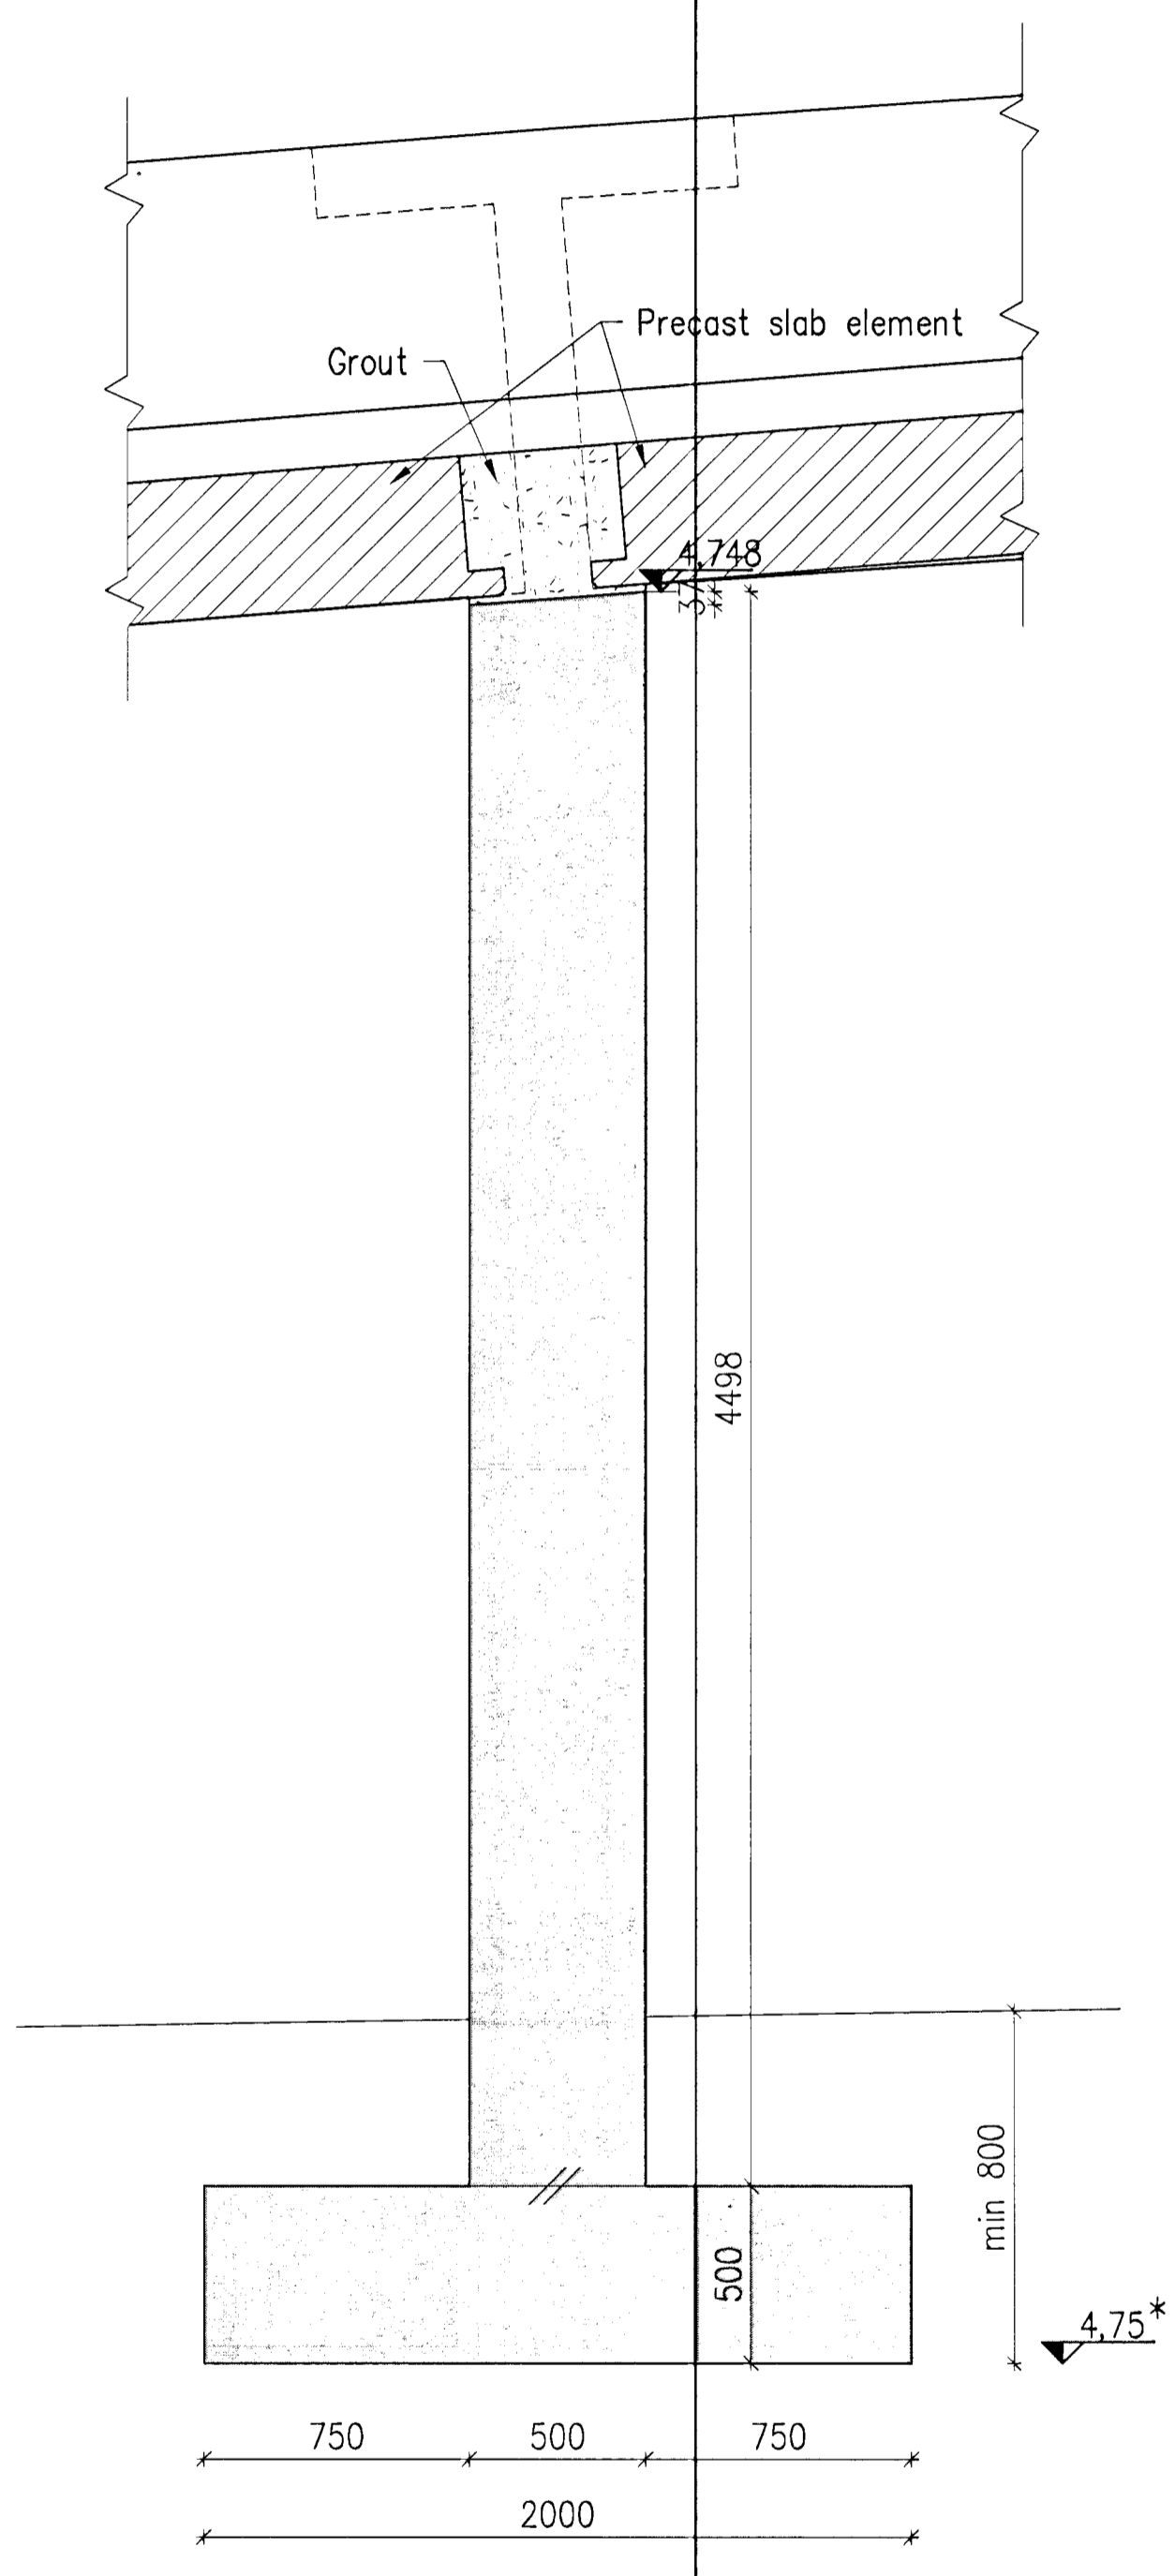

Skýringar: Legend:
 GENERAL NOTES see drawing ICC-611-CA-541-600
 CONCRETE: C30/37:XF3-38
 * Elevation of foundations on rock may differ (min. 800 from finished surface)
 Precast elements are shown on contractors drawings

Slg nr / Rev no	Lýsing / Description	Dagsetning / Date	Höfundur / Des/Drw	Yfir / Chk	Notk heim / Suppl	Notk heim / ISAL Ref
6	Record Drawing	2012.07.23	GMG	NI	TE	rd>

Dagsetning / Date 2011.04.07		Hannað / Designed HS/GMG		Teikn / Drawn GMG	
Verktaki / Supplier HRV		Tökn.nr.verktaka / Supplier drw.no. ICC-611-CA-541-604		Samþykkt / Approved NI	
Hluti af / Part of:		Yfirl / Chkd NI			

IPU-CASTHOUSE EXTENSION BUILDINGS, RAMPS			Flokkur nr.:	Blað nr.:	Nasta bl.nr.:
RAMP 1			Kostn.nr.-Cono. /	Böfn.nr.-Eq.no	
FOUNDATION F2			5010	16957	
Teg tekningar / Dwg. type: FORM WORK			AKS UF002		
Rio Tinto Alcan			ISAL Teikn.nr. ISAL / Drw.no. of ISAL 253517		
ISAL Yfirfarð og skráð, dags / ISAL Checked, date			ISAL Samþykkt, dags / ISAL Approved, date		