


4 SIDE VIEW

A SECTION


Samþykkt þann
 02 OCT 2012
 F.h. Sigurður Steinar Jónsson

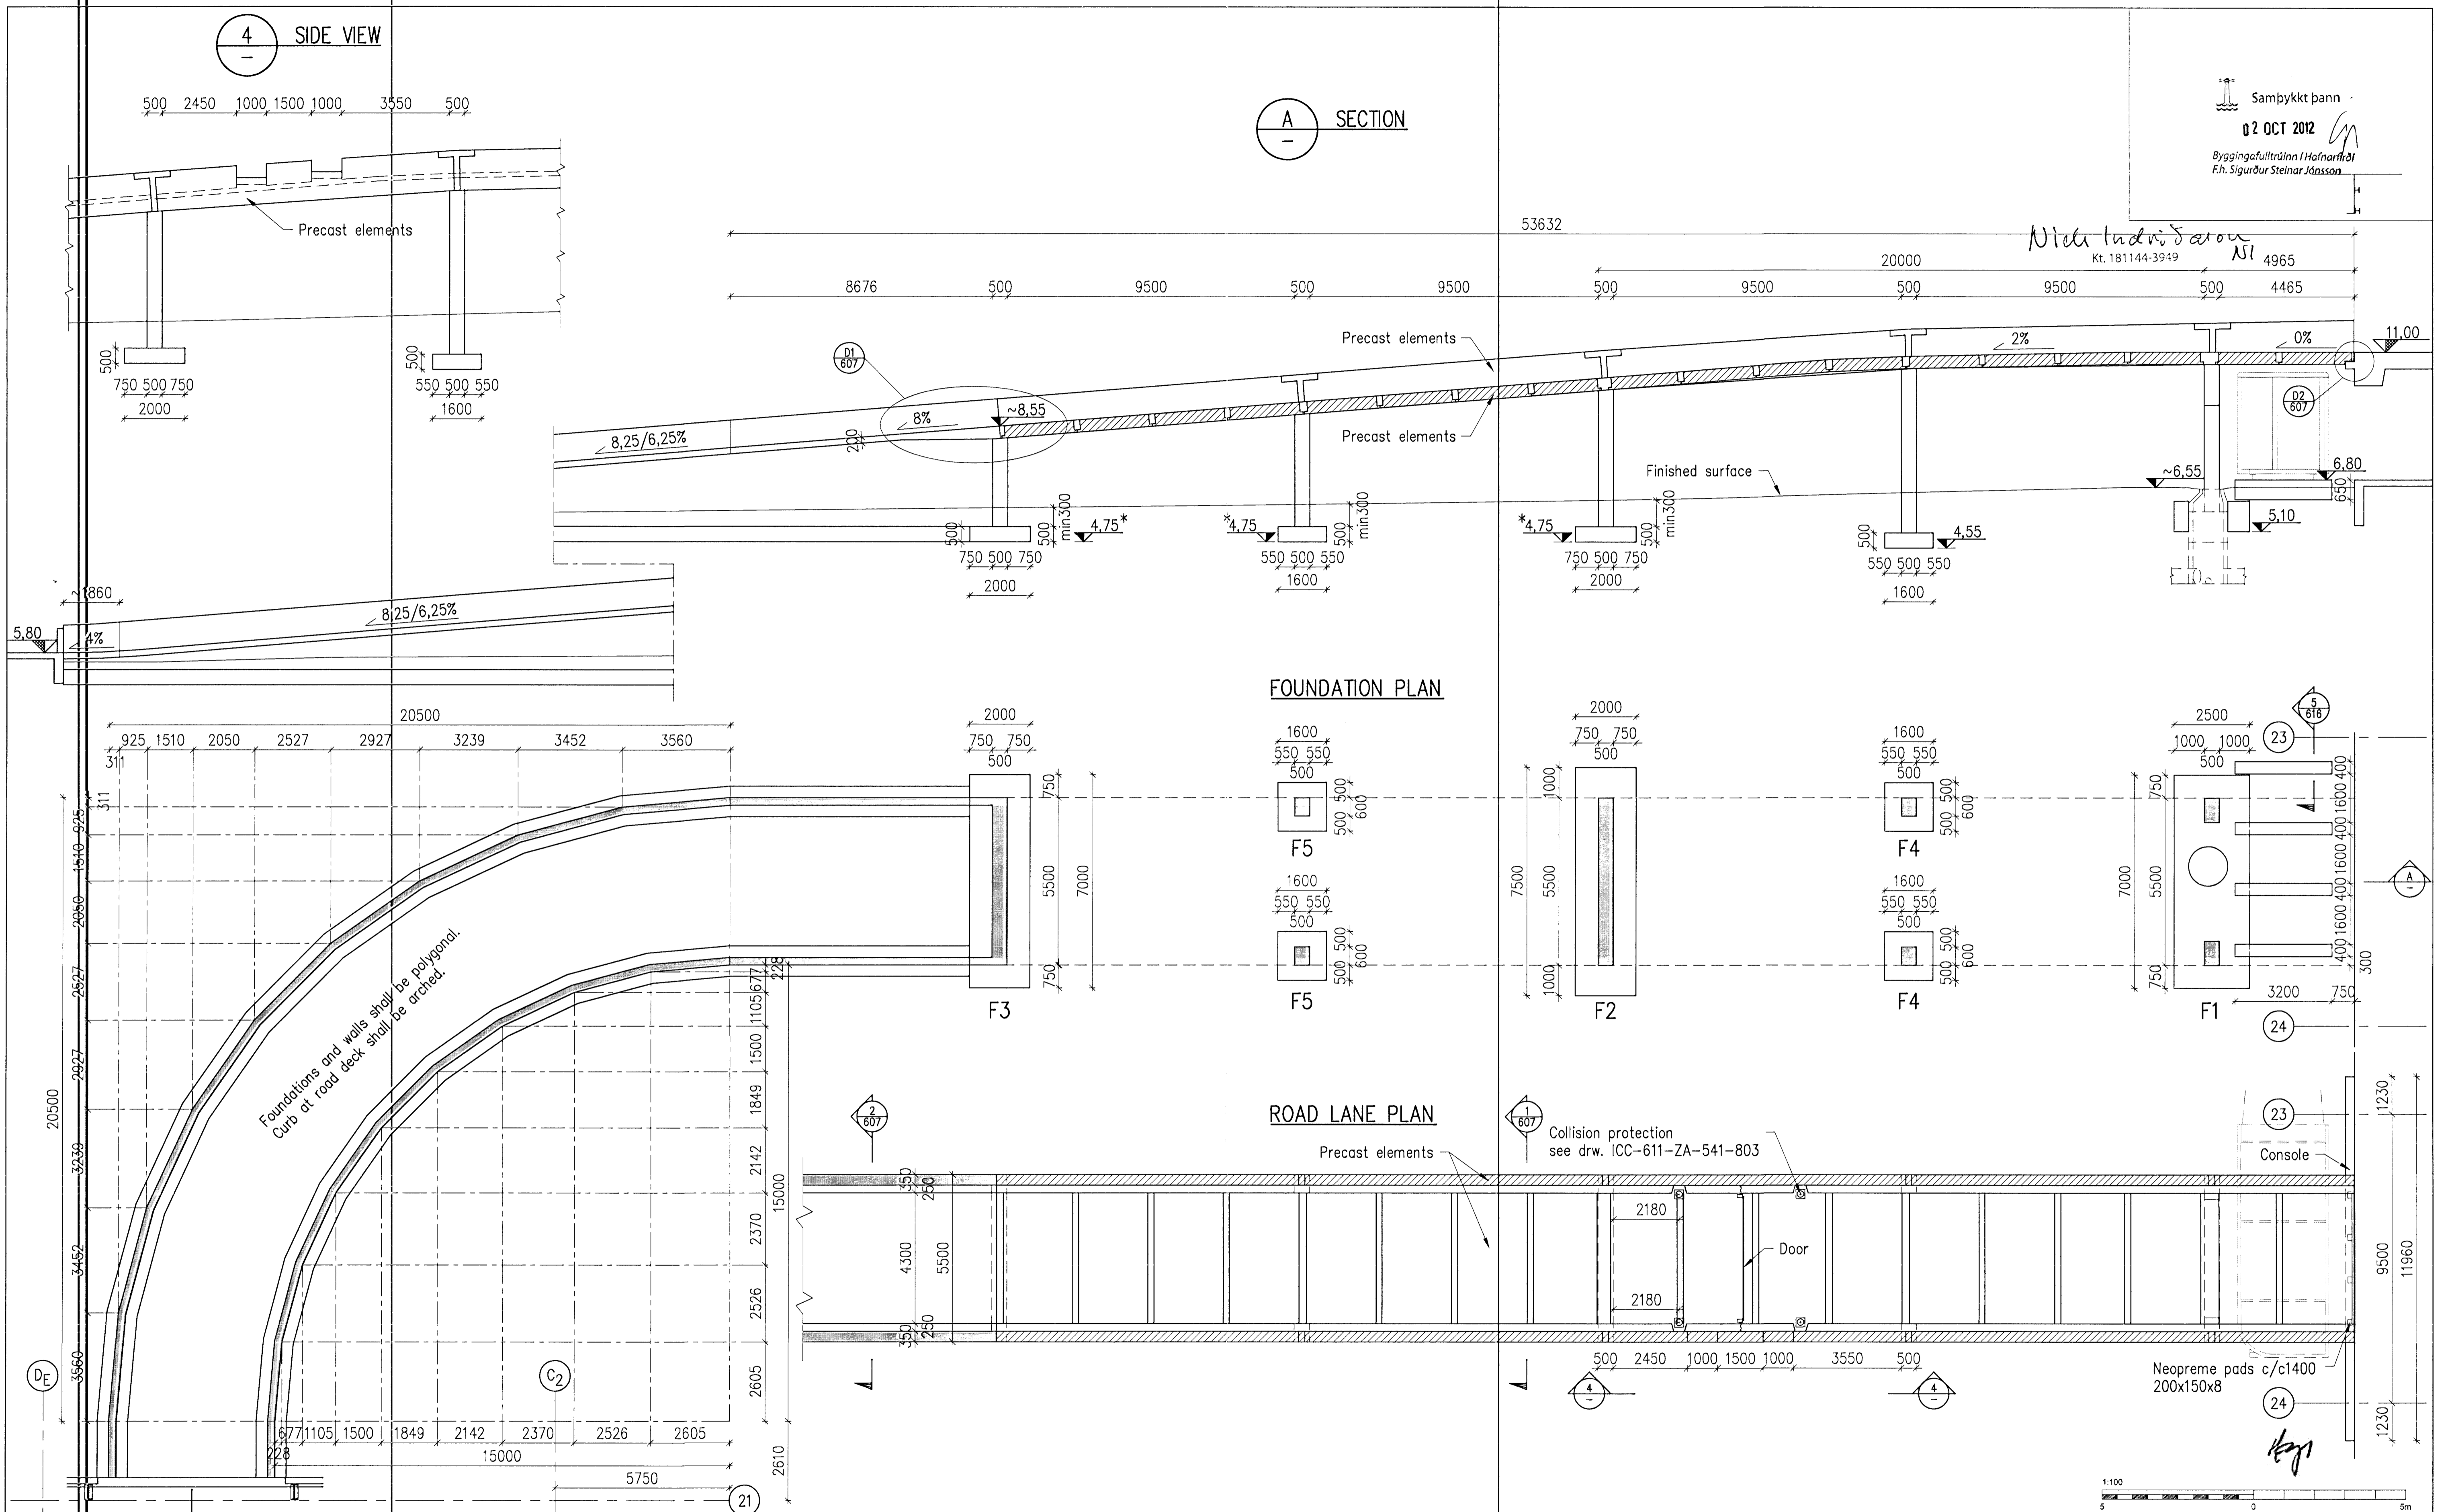

Foundations and walls shall be polygonal.
 Curb at road deck shall be arched.

Collision protection
 see drw. ICC-611-ZA-541-803

Neoprene pads c/c1400
 200x150x8

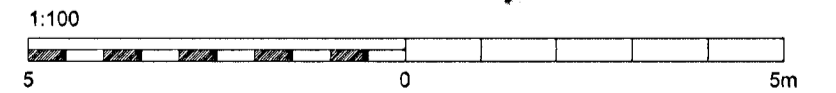

Skýringar: Legend:	GENERAL NOTES see drawing ICC-611-CA-541-600 CONCRETE: C30/37;XF3-38 * Elevation of foundations on rock may differ (min. 800 from finished surface)	Outside view see drawing ICC-611-ZA-541-625 Precast elements are shown on contractor drawings	This drawing is the property of Rio Tinto Alcan Iceland Ltd. and loaned out for personal use only. It may neither be copied nor made available to others without permission of Rio Tinto Alcan Iceland Ltd. The receiver is liable for any misuse.				HRV HATCH JOINT VENTURE ISAL PRODUCTION UPGRADE	Dagsetning / Date 2011.04.07	IPU-CASTHOUSE EXTENSION BUILDINGS, RAMPS RAMP 1 PLAN	Flakur nr.: 5010	Blað nr.: 16957	Næsta bl. nr.: 16958
