PLAN, 1:250

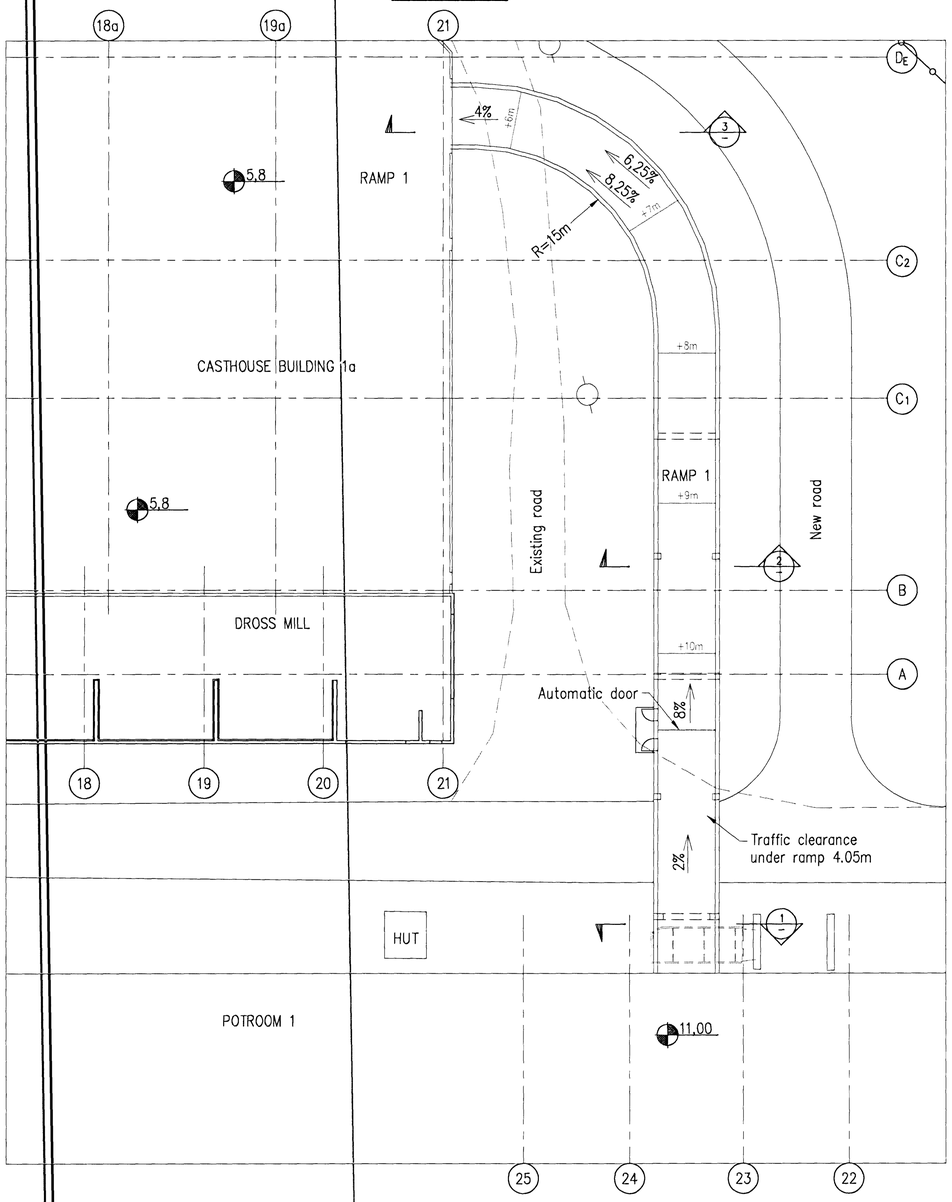

1 SECTION 1:100

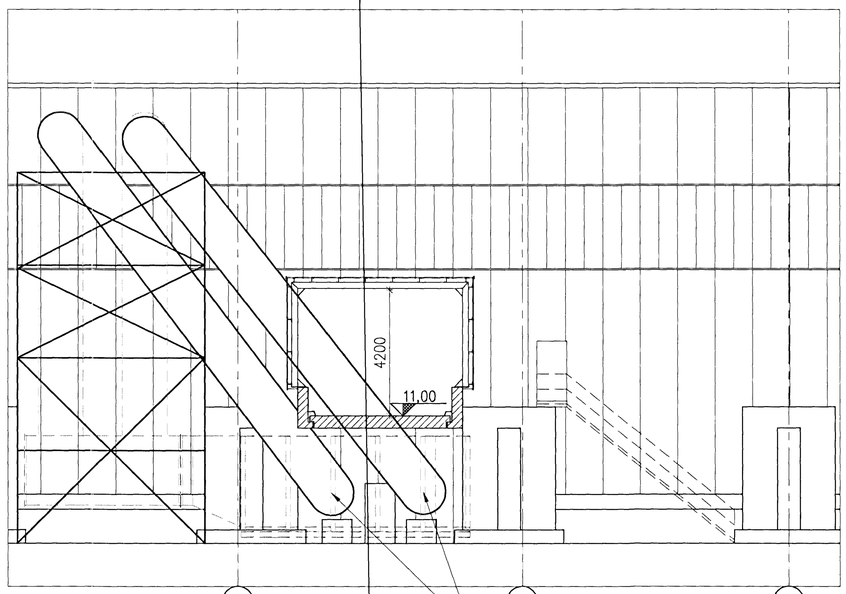

2 SECTION 1:100

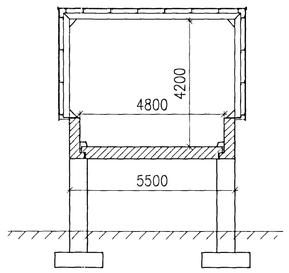

3 SECTION 1:250

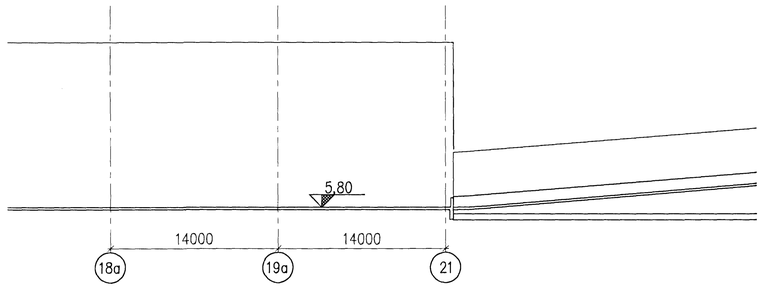

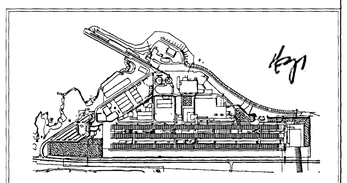

IPU Keyplan - Scale. 1:15000

1:100
5 0 5m

1:250
12.5 0 12.5m

Samþykkt þann
02 OCT 2012
Byggingafulltrúinn í Hafnarfirði
F.h. Sigurður Steinar Jónsson

Nicki Indriðason
Kt. 181144-3949 NI

Skýringar: GENERAL NOTES see drawing ICC-611-CA-541-600
Legend: CONCRETE: C30/37:XF3-38

C:\DP\03 icc\600 casting\600 drawings\civil\ICC-611-CA-541-601.dwg

Útg.nr. Rev.no	Lýsing Description	Dagsetning Date	Hön/Tkn Des/Drw	Yfirf Chkd	Notk.heim Suppl.Ref	Notk.heim ISAL Ref
6	Record Drawing	2012.06.07	HS	NI	FH	

This drawing is the property of Rio Tinto Alcan Iceland Ltd. and handed out for personal use only it may neither be copied nor made available to others without permission of Rio Tinto Alcan Iceland Ltd. The receiver is liable for any misuse.

Stærð: Format: A1 Mkv.: Scale: 1:100/250
Dimensions without tolerances according to ISO 2768-1 medium.

HRV & HATCH JOINT VENTURE ISAL PRODUCTION UPGRADE

Dagsetning / Date: 2011.04.07
Hannað / Designed: HS
Teikn / Drawn: LDB
Verktaki / Supplier: HRV
Teikn.nr.verktaka / Supplier drw.no.: ICC-611-CA-541-601
Samþykkt / Approved: NI
Yfirf / Chkd: NI
Hluti af: / Part of:

IPU-CASTHOUSE EXTENSION BUILDINGS, RAMPS
RAMP 1
PLAN VIEW AND SECTIONS
Teg.teikningar / Dwg. type: FORM WORK

Flokkur nr.: Blað nr.: Næsta bl.nr.:
Kostn.nr.-Cono. / BGn.nr.-Eq.no: 5010 16957
AKS: UF002
Teikn.nr. ISAL / Drw.no. of ISAL: 253514
Breyt./Rev.: A

Rio Tinto Alcan
ISAL Álcan Iceland Ltd. Straumsvík IS-222 Hafnarfjordur Iceland

ISAL Yfirfarið og skráð, dags / ISAL Checked, date
ISAL Samþykkt, dags / ISAL Approved, date