
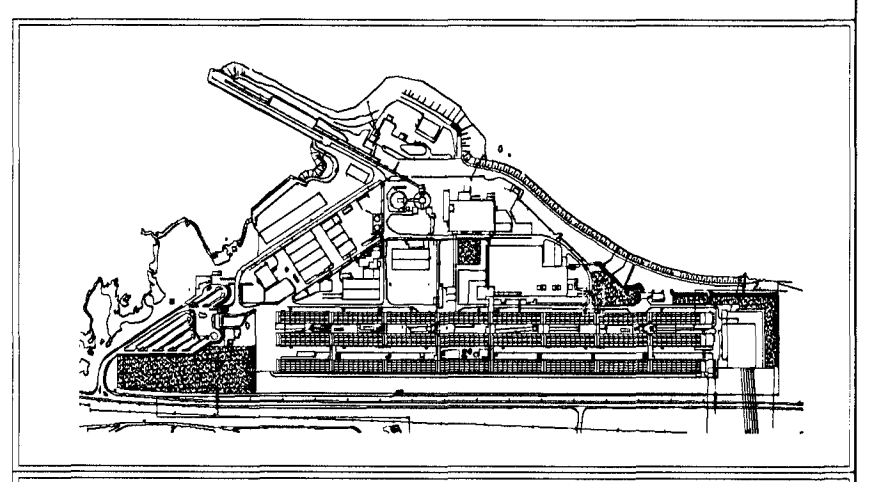


Sampykkt þann  
 02 OCT 2012  
 Byggingafulltrúinn / Hafnarfró  
 F.n. Sigurður Steinar Jónsson

Nick Indriðarson  
 Kt. 181144-3949 NI

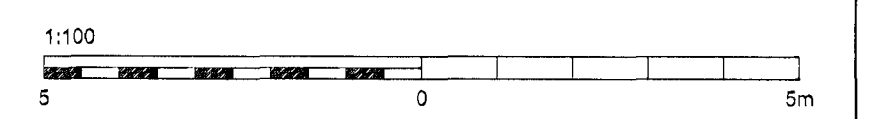

Skýringar  
 Legend:  
**Note**  
 Foundations on rock shall be at min. 800mm depth from finished surface. Excavation depth can be adjusted to that. Where pipes or other utilities are located in the vicinity, foundations may have to go deeper. In such case to be decided by the engineer.

Stig nr	Rev no	Lýsing	Útgáfa	Stig nr	Rev no	Lýsing	Útgáfa
4		Record Drawing	2012.07.23	GMG	NI	PG	reka

This drawing is the property of Rio Tinto Alcan Iceland Ltd. and handed out for personal use only. It may neither be copied nor made available to others without permission of Rio Tinto Alcan Iceland Ltd. The receiver is liable for any misuse.			
Stærð:	A1	Mæki:	1:100
Formi:	A1	Skala:	1:100
Dimensions without tolerances according to ISO 2768-1 medium.			

Dagsetning / Date	2011.05.13
Hannað / Designed	GMG
Tekni / Drawn	LDB
Vertekni / Supplier	HRV
Tekni nr. vertekna / Supplier drw. no.	ICC-611-C5-541-601
Samþykkt / Approved	NI
Yfirlit / Checked	NI

IPU-CASTHOUSE EXTENSION BUILDINGS, RAMPS		
RAMP 1		
PLAN VIEW		
EXCAVATION		
Flokkur nr. / Blað nr. / Kostn. nr. - Cono. / Blm. nr. - Eq.no.	5010	16957
UFO02	253503	A