



Samþykkt þann
 02 OCT 2012
 Byggingafulltrúinn / Hafnarfrósi
 F.h. Sigurður Steinar Jónsson

Níels Indriðason
 Kt. 181144-3949
 NI

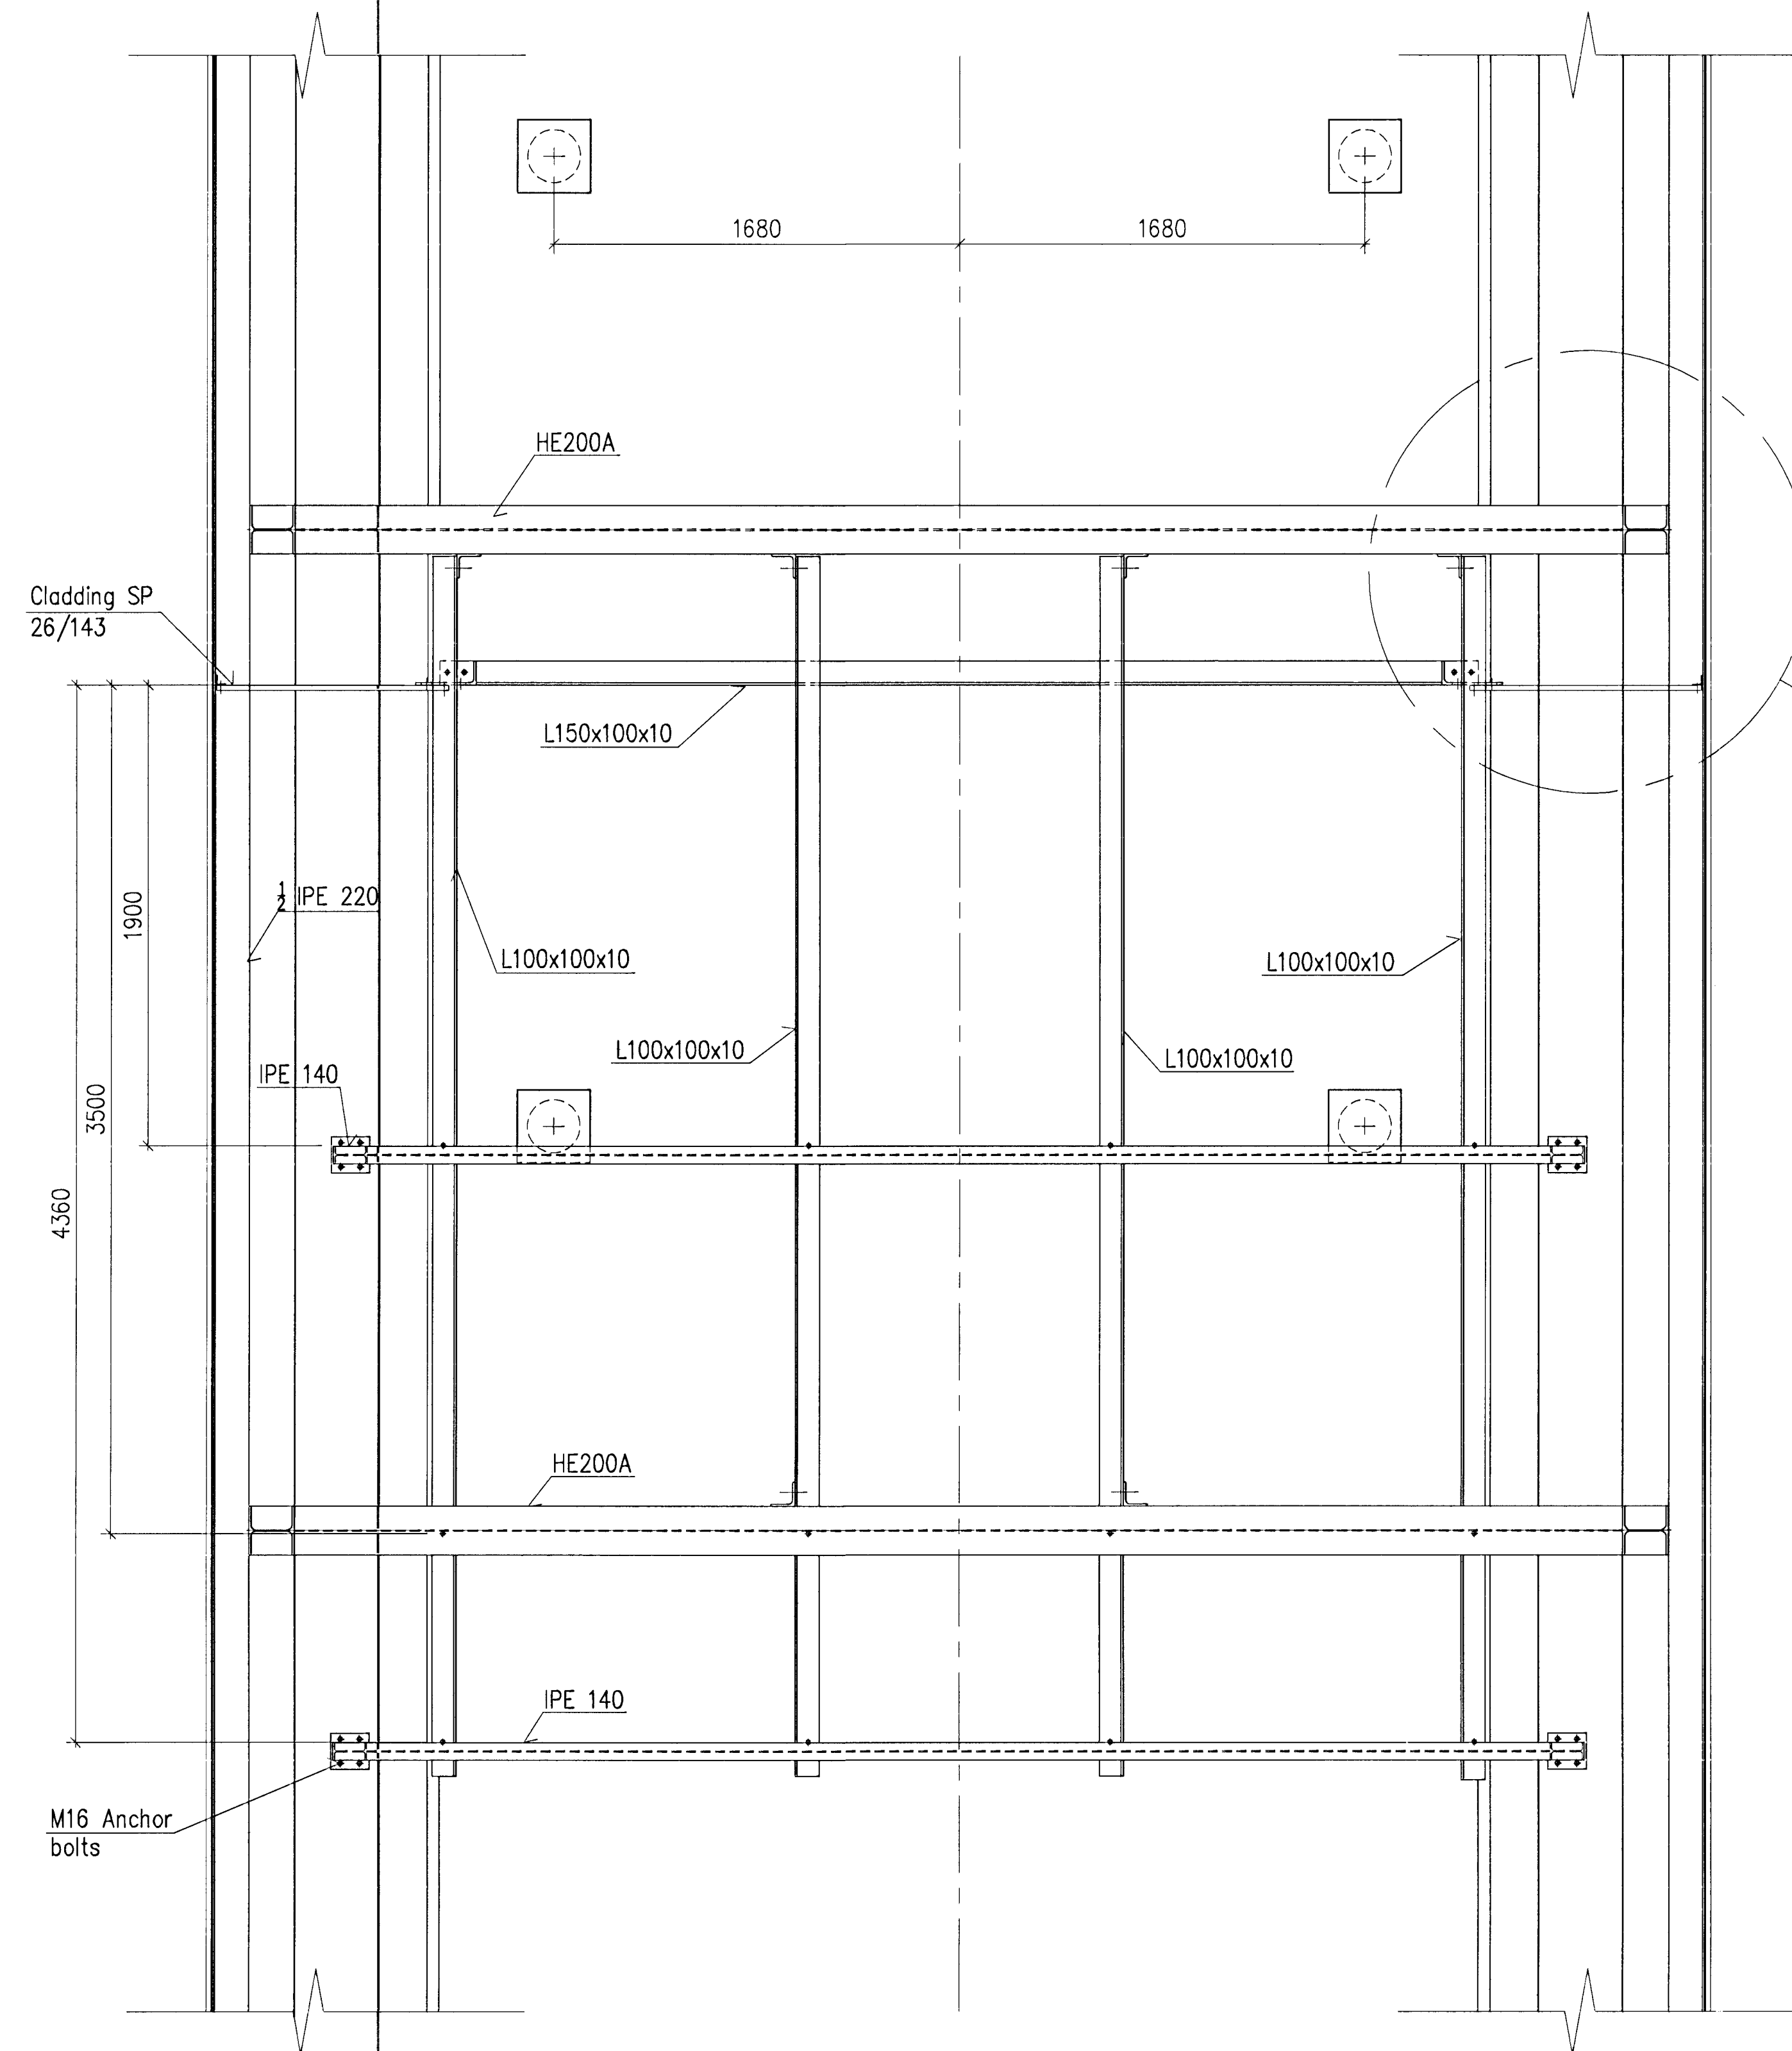

B SECTION
 801 1:20

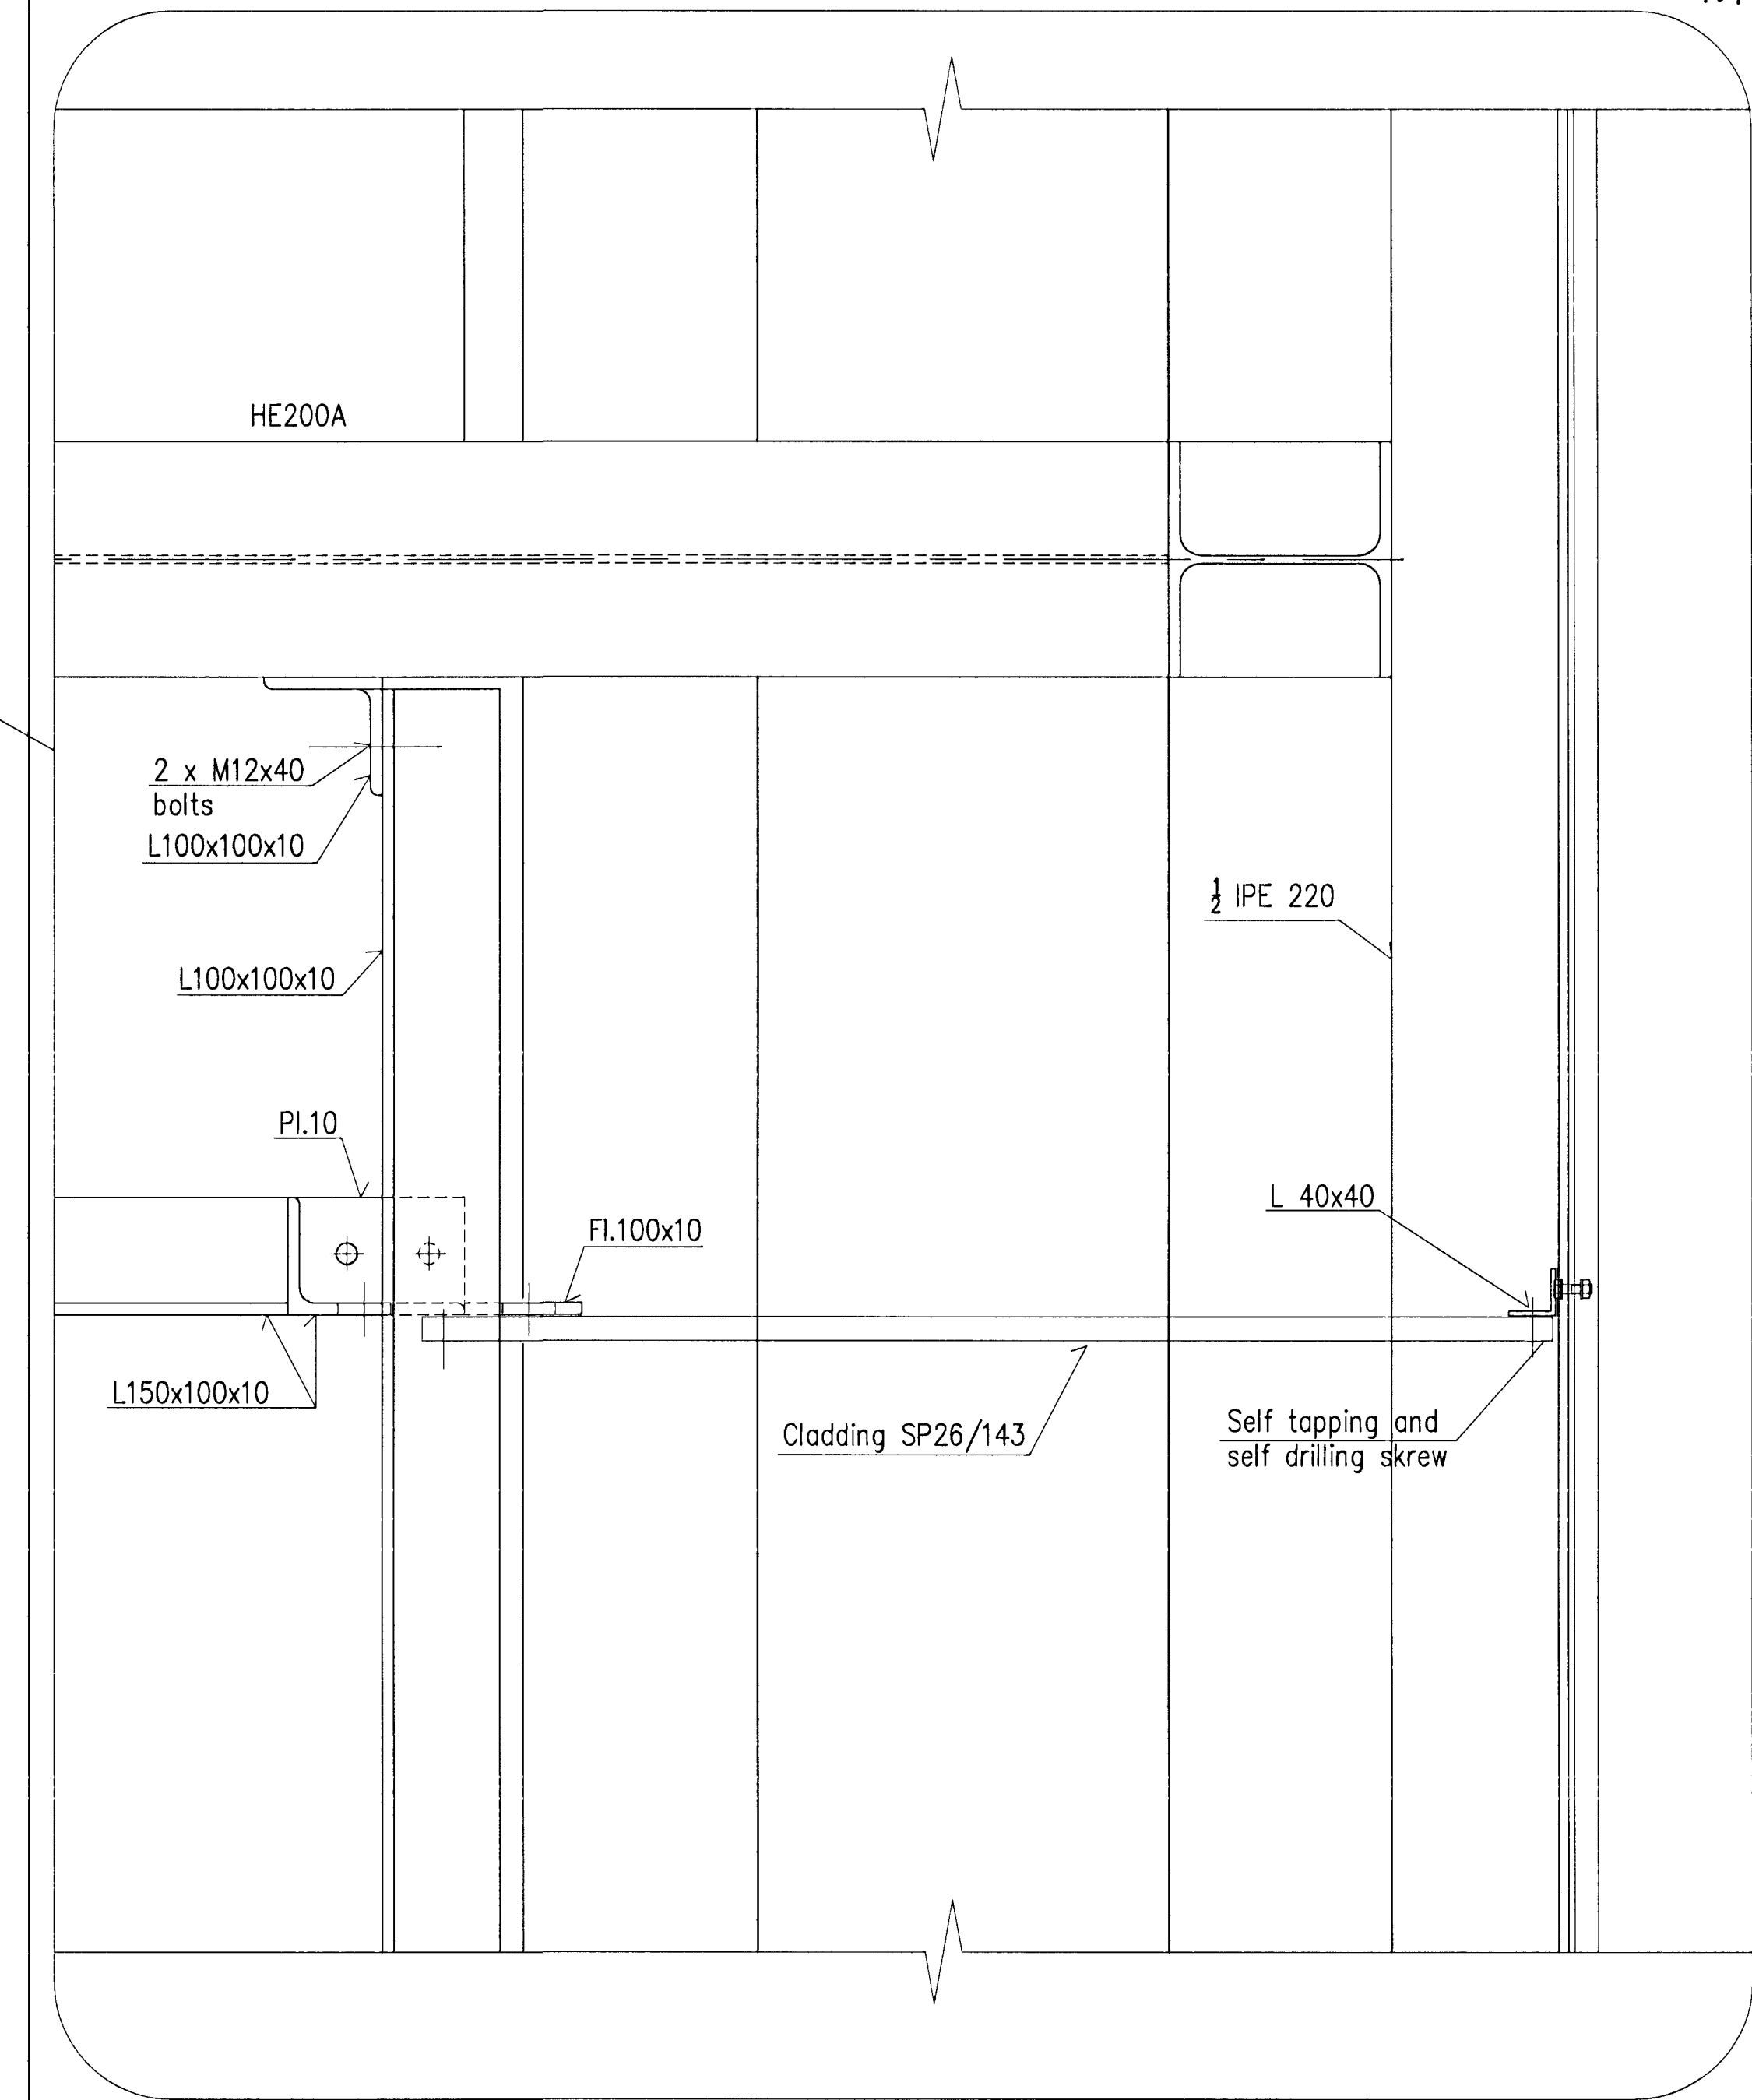

DETAIL-CLADDING
 1:5

Skýringar:
 Legend: *Dimension dependant on the door type EFAFLEX EFA-SST, L-N-ECO.

C:\DP\03 ICC-600 Casting\600 Drawings\Civil\ICC-611-ZA-541-802.dwg

5	Record Drawing	2012.07.23	VMM	NI	PG	NI	NI	NI	NI
Útg nr	Rev no	Dagsetning	Hor/Þis	Yfir	Notk heim	Notk heim	Notk heim	Notk heim	Notk heim
		Date	Des/Draw	Old	Suppl	Rel	ISAL	Rel	



Dagsetning / Date
 2010.12.28
 Hannab / Designed
 VMM
 Verktaki / Supplier
 HRV
 Tekn.nr.verktaka / Supplier drw.no.
 ICC-611-CA-541-802
 Snnhskt / Approved
 Yfir / Chkd
 NI
 Hluti af: / Part of:

IPU 600 - CASTING
 CASTHOUSE EXTENSION
 RAMP 1
 Tag tekiingar / Desg. type:
 DOOR LAYOUT
RioTinto Alcan

Flokkur nr.: Blað nr.: Nasta bl.nr.:
 5010 16957
 Kostn.nr.-Cano. / Blun.nr.-Eq.no.
 AKS
 UF002
 ISAL Tekn.nr. ISAL / Drw.no. of ISAL Breyt./Rev.
 ISAL Alcan Iceland Ltd. 253555 A
 IS-222 Hafnarfrósi Iceland

ISAL Yfirbúð og skráð, dags / ISAL Checked, date
 ISAL Samþykkt, dags / ISAL Approved, date