PLAN VIEW

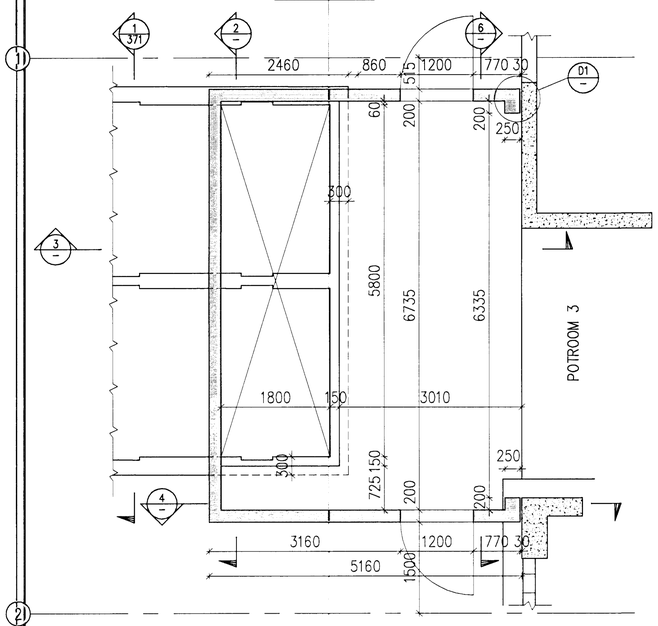

2/– SECTION

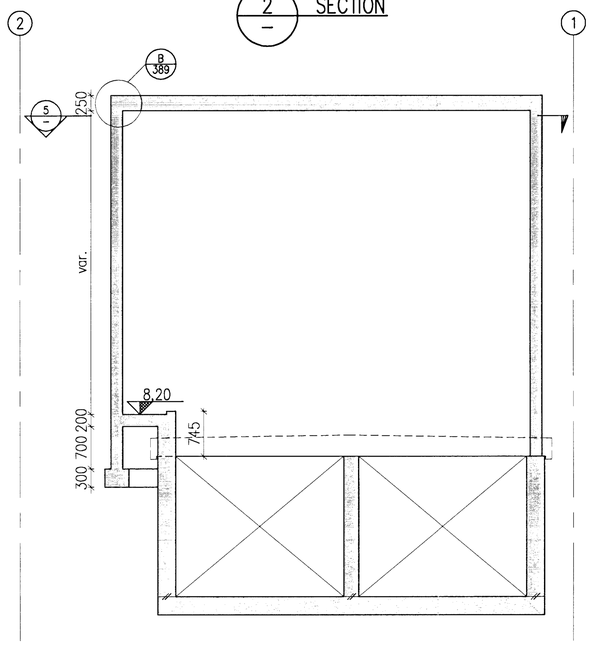

3/– SECTION

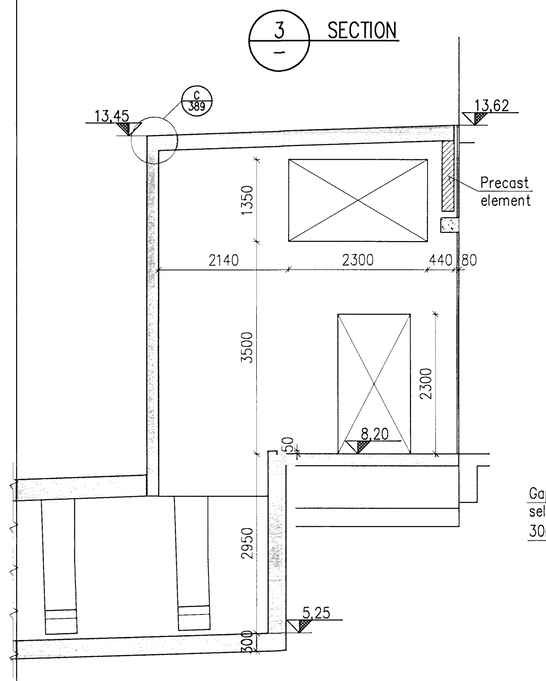

Samþykkt þann
02 OCT 2012
Byggingafulltrúinn í Hafnarfirði
F.h. Sigurður Steinar Jónsson

Niels Indriðason
Kt. 181144-3949
NI

D1/– 1:10

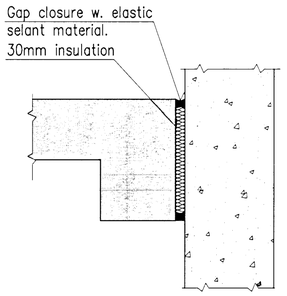

4/– SECTION

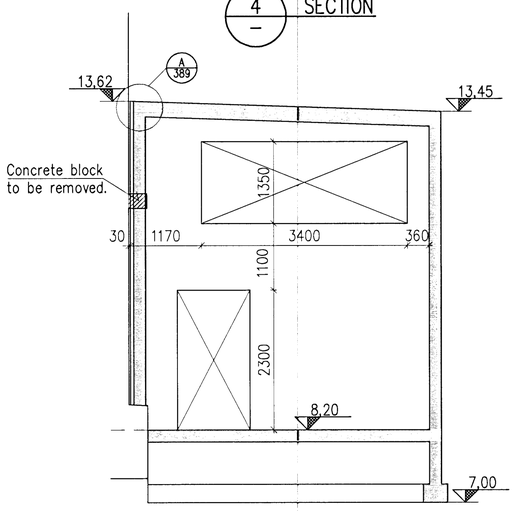

5/– SECTION

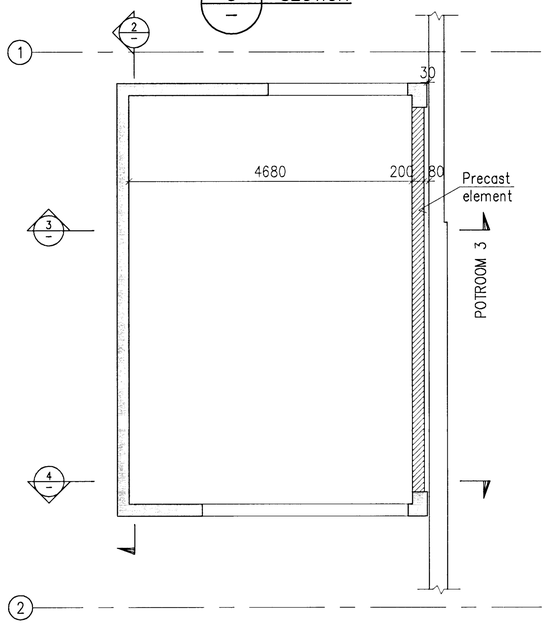

6/– SECTION

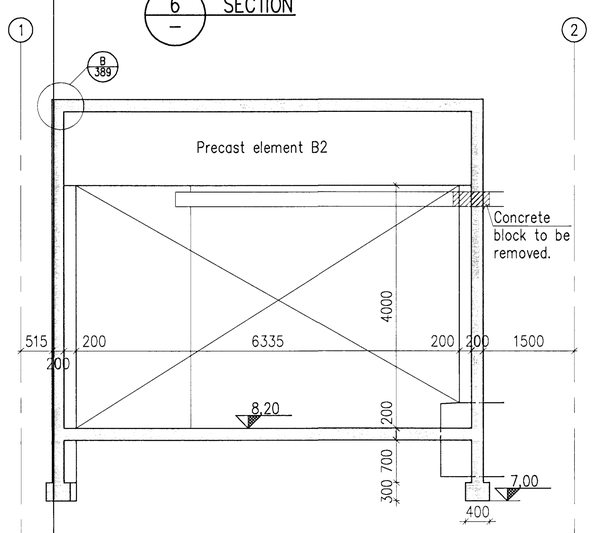

1:10
500 0 500mm

1:50
2500 0 2500mm

Skýringar
Legend:

Concrete: C30/37: XF3-32

Precast elements are shown on drw. IDP-410-CA-015-388

C:\IDP\01 IDP\400 – Reduction\410 Substation\Drawings\Civil\IDP-410-CA-015-381.dwg

Útg.nr Rev.no	Lýsing Description	Dagsetning Date	Han/Tkn Des/Drw	Yfirf Ckd	Notk.heim Suppl.Rel	Notk.heim ISAL Rel
12	Record drawing	2012.09.12	GMG	NI	EG.	

This drawing is the property of Rio Tinto Alcan Iceland Ltd. and handed out for personal use only. It may neither be copied nor made available to others without permission of Rio Tinto Alcan Iceland Ltd. The receiver is liable for any misuse.

Stærð / Format: A1 Mkv. / Scale: 1:50

Dimensions without tolerances according to ISO 2768-1 medium.

HRV HATCH JOINT VENTURE
ISAL PRODUCTION UPGRADE

Dagsetning / Date	2011.02.21
Hannað / Designed	HS
Teikn / Drawn	LDB
Verktaki / Supplier	HRV
Teikn.nr.verktaka / Supplier drw.no.	IDP-410-CA-015-381
Samþykkt / Approved	NI
Yfirf / Chkd	NI
Hluti af: / Part of:	

IPU 410 – RECTIFIER BUILDINGS
INTAKE BUILDING PL 3
PLAN VIEW AND SECTIONS
Teg.teikningar / Dwg. type: FORM WORK

Flokkur nr.:	Blað nr.:	Næsta bl.nr.:
Kostn.nr.-Cono. / BGn.nr.-Eq.no		
4011	13983	
AKS		
UB13		

Rio Tinto Alcan
ISAL
Alcan Iceland Ltd
Straumsvík
IS-222 Hafnarfjörður
Iceland

Teikn.nr. ISAL /Drw.no. of ISAL	Breyt./Rev.
251303	A

ISAL Yfirfarið og skráð, dags / ISAL Checked, date

ISAL Samþykkt, dags / ISAL Approval, date