Samþykkt þann
01 OCT 2012
Byggingafulltrúinn í Hafnarfirði
F.h. Sigurður Steinar Jónsson

Nicki Indriðason
Kt. 181144-3949

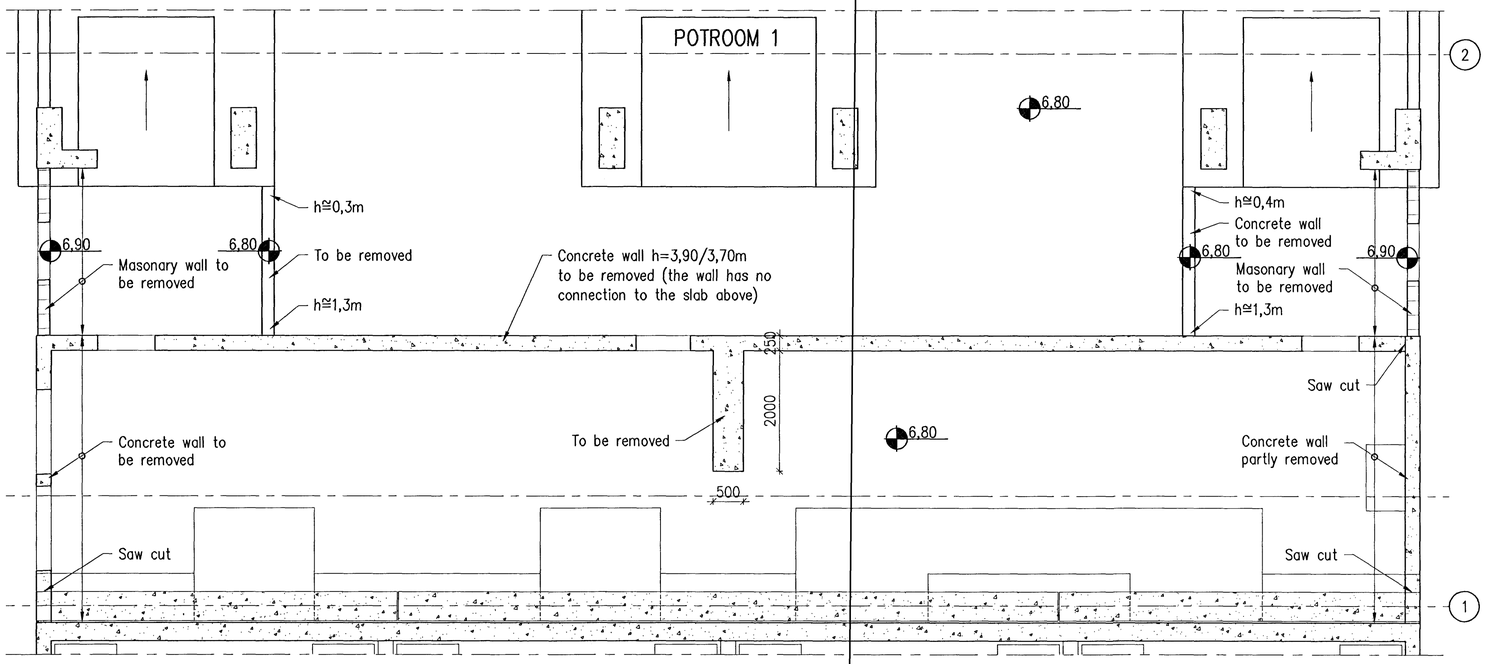

EXISTING PLAN VIEW 1:50

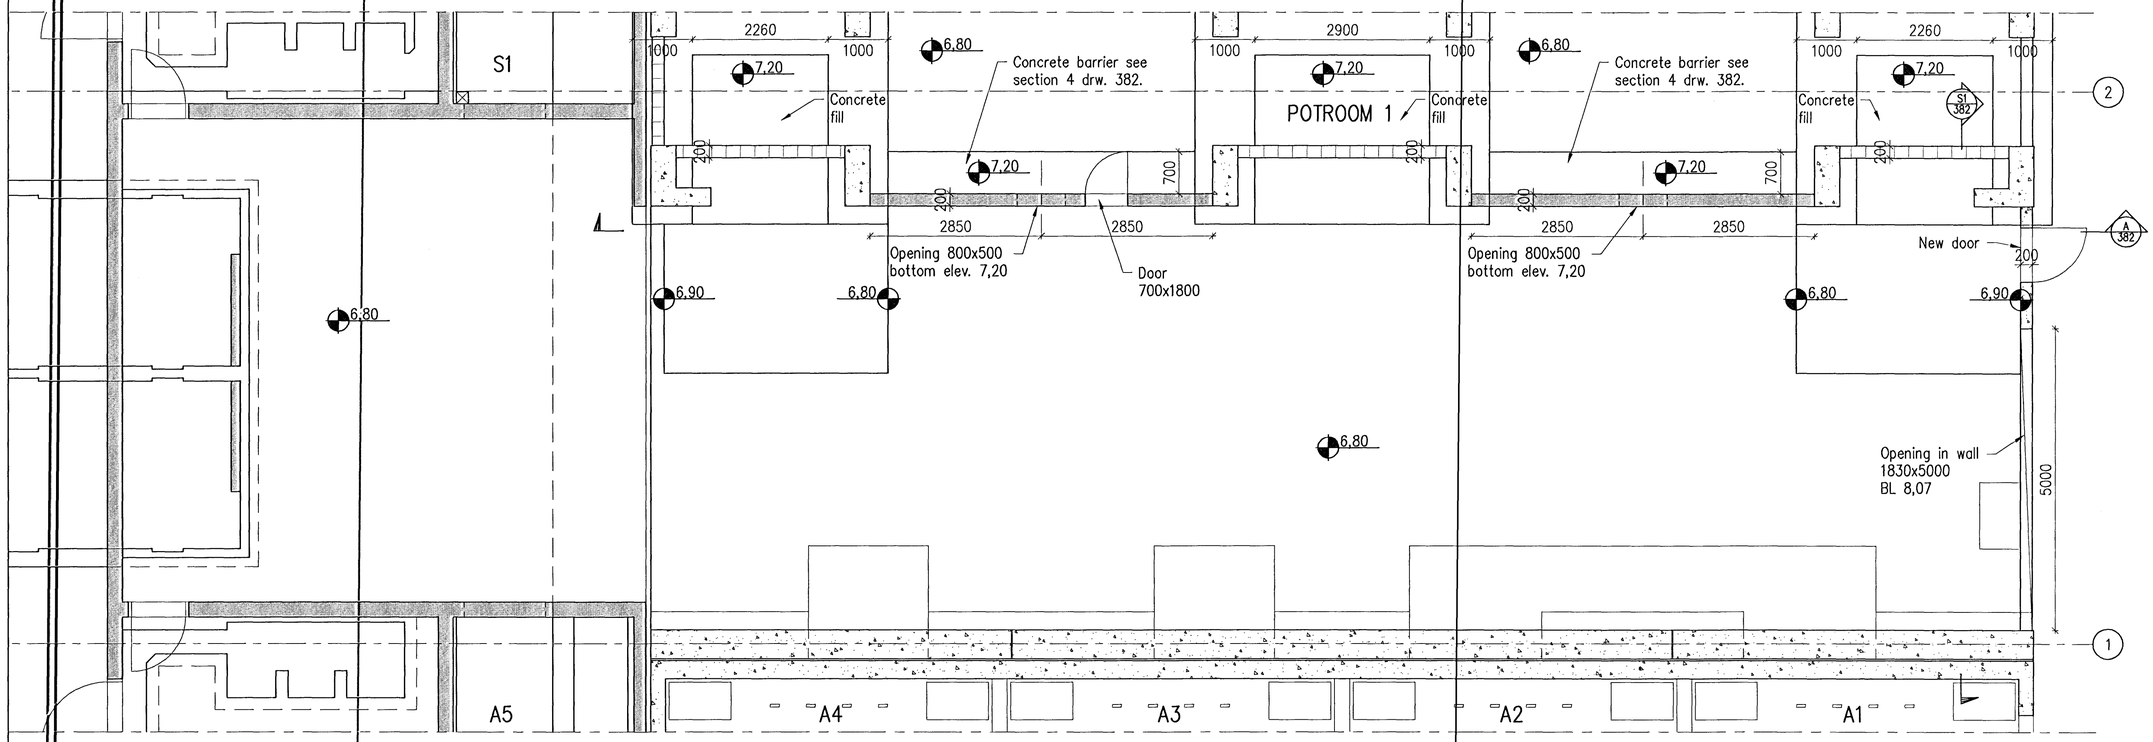

NEW PLAN VIEW 1:50

1:50
2500 0 2500mm

Skýringar:
Legend:

Concrete cover 30 mm.
Concrete: C30/37.
Reinforcement: B500C.
NB: No equipment shown on this drawing.

C:\IDP\01 IDP\400 – Reduction\410 Substation\Drawings\Civil\IDP-410-CA-109-381.dwg

Útg.nr Rev no	Lýsing Description	Dagsetning Date	Han/Tkn Des/Drw	Yfirf Chkd	Notk.heim Suppl Ref	Notk.heim ISAL Ref
6	Record drawing	2012.09.13	GMG	NI	EG	

This drawing is the property of Rio Tinto Alcan Iceland Ltd. and handed out for personal use only it may neither be copied nor made available to others without permission of Rio Tinto Alcan Iceland Ltd. The receiver is liable for any misuse.

Stærð: Format: A1 Mkv.: Scale: 1:50
Dimensions without tolerances according to ISO 2768-1 medium.

HRV & HATCH JOINT VENTURE
ISAL PRODUCTION UPGRADE

Dagsetning / Date: 2011.07.14
Hannað / Designed: SE
Teikn / Drawn: LDB
Verktaki / Supplier: HRV
Teikn.nr.verktaka / Supplier drw.no.: IDP-410-CA-109-381
Samþykkt / Approved: NI
Yfirf / Chkd: NI
Hluti af: / Part of:

IPU 410-RECTIFIER BUILDINGS-POTROOM 1
COLLECTOR BUSBAR ROOMS LAYOUT
Teg.teikningar / Dwg. type: FORM WORK

Flokkur nr.: | Blað nr.: | Næsta blnr.:
Kostn.nr.-Ccno. / Bún.nr.-Eq.no: 4011 13981
AKS: UB11
Teikn.nr. ISAL /Drw.no. of ISAL: 251320
Breyt./Rev.: A

Rio Tinto Alcan
ISAL
Alcan Iceland Ltd
Straumsvík
IS-222 Hafnarfjordur
Iceland

ISAL Yfirfarið og skráð, dags / ISAL Checked, date
ISAL Samþykkt, dags / ISAL Approved, date