Format A1 (841x594 mm) is 20 mm outside of this frame

Samþykkt bann
[illegible]. 2002
Byggingarfulltrúinn í Hafnarfirði
[illegible]

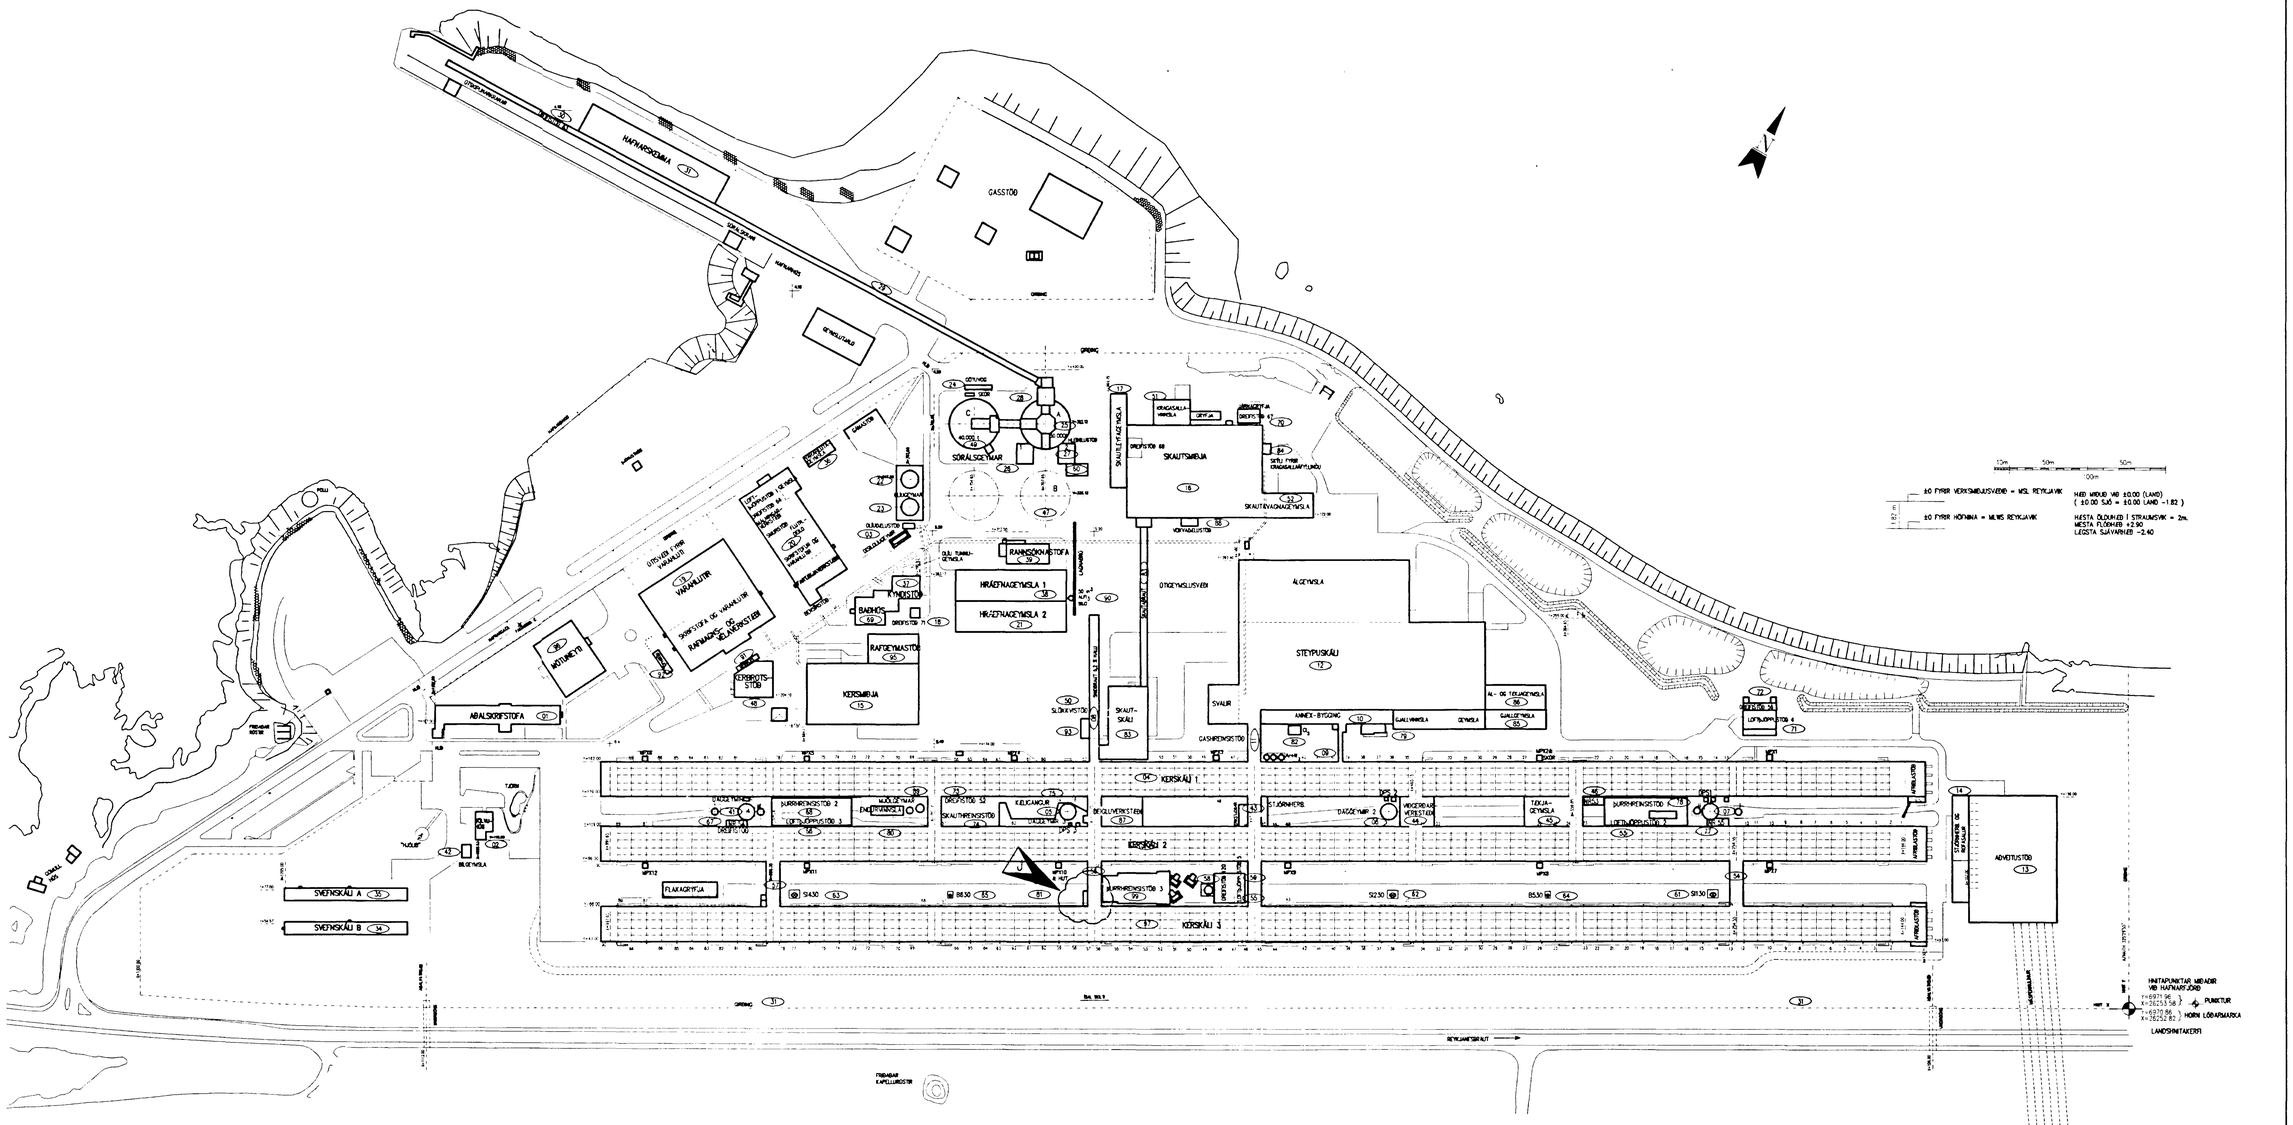

1: 2000

100 0 100 200 m

J: \[99-1xx]\99110\verkhl 59-vörtufræs\DWG\185390J.dwg

Nick Indriðason 181144-3849

Skýringar:
Explanations:

J	VÖRTUFRÆS Í TENGIGANGI 56-57	9.11.2002	NI/HFB	
I	SKAUTLEIÐSLUNUM Í TENGIGANGI 56-57	10.12.2001	NI/HFB	SvS
H	KÆLIÆST. Í TENGIBYGG. 78-79	26.11.2001	NI	SvS
G	AL- OG TÉKKGEYMSLA (BE) INNF.	20.11.2001	SE	SvS
F	SKAUTABRAUT OG GJALLGEYMSLA INNF.	08.10.2001	GJR/	SvS
E	MATSHLUTA Í 84 BÁTSTÆKJUM RANNSÓKNARSTOFU, GJALLGEYMSLA	14.11.2000	NI	SvS
D	MATSHLUTA Í 84 BÁTT INN (SKILI FYRIR KRAGASALLAAFFYLL)	11.05.2000	AS	SvS
C	INNF. NÝ GRUNNMYND	05.04.2000	NI	SvS
Breyt. Rev.	Breyting Revision	Dags Date	Samb. Approved	Nálk. hermi Released

Allt tekningar nr. ISAL
Part drawing no. of ISAL

Samsetn tekningar nr. ISAL
Assembly drawing no. of ISAL

This drawing is the property of the ICELANDIC ALUMINIUM CO. LTD. and handed out for personal use only. It may neither be copied nor made available to others without permission of the ICELANDIC ALUMINIUM CO. LTD. The receiver is liable for any misuse.

Fjöldi stykkja / Number of pieces: IV III II I

Hlutur / Object	Álverið, allar byggingar Ný matshlutanúmer	Athugasemdir / Remarks	
Efni / Material			
Áætl. þyngd / est. wt. kg		Mælikvarði / Scale	1: 2000
Heild. þyngd / total wt. kg		Stærð frumteikn. / Format of orig.	A1
Verktaki / Supplier	VERKFRÆÐISTOFA SIGURÐAR THORODDSEN	Drawing no. of supp. / teikn.nr. verktaka	99.110-001
Teiknað / Drawn	NI 11.05.1998	Yfirfarið / Checked	NI 11.05.2001
Samþykkt / Approved			
algroup alusulsse primary materials	icelandic aluminium co. ltd. p.o. box 244 is-222 hafnarfjordur, iceland	Teikn. nr. ISAL / drawing no. ISAL	185390
		Breyt. / rev.	J
Teiknað / Drawn		Yfirfar. og skráð / Checked and filed	28.02.2000 GUR
		Nálkun hermuð / released	28.02.2000 SvS