REMOVABLE ALUMNIUM WALL, 1:20

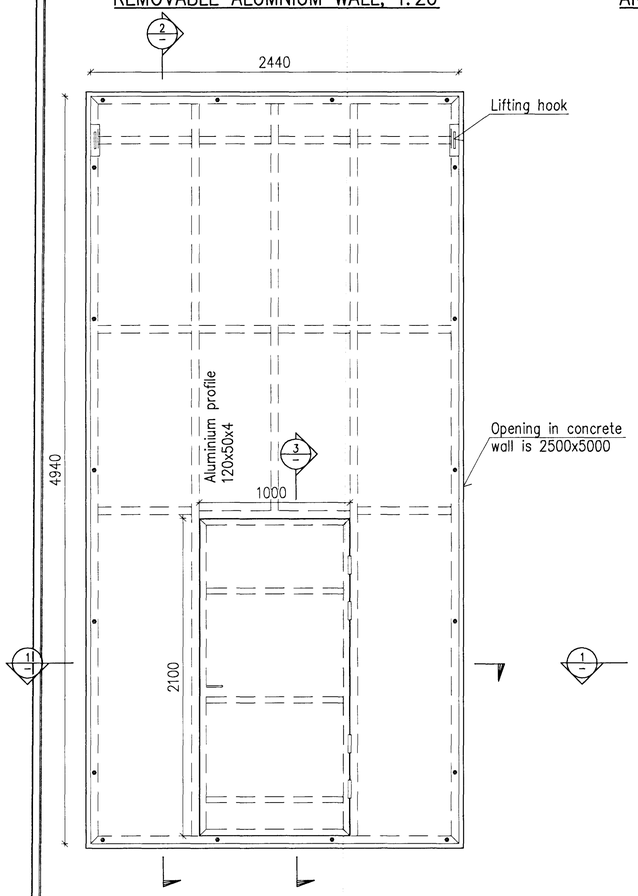

ARRANGEMENT OF ALUMINUM PLATES, 1:20

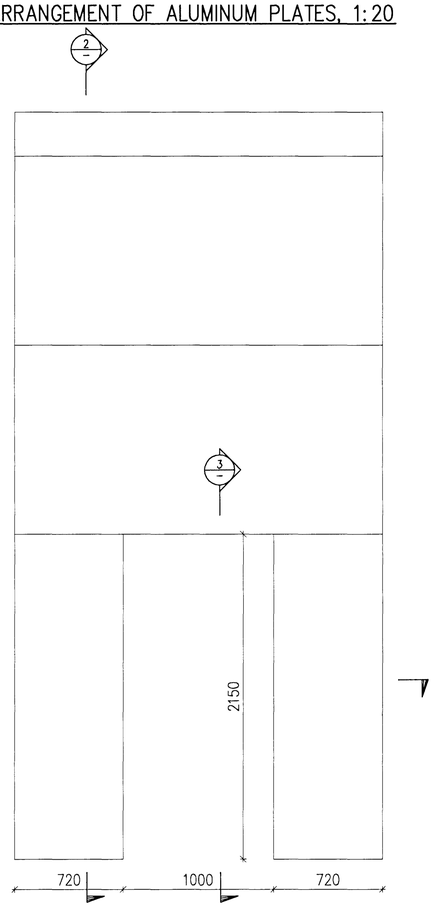

LIFTING HOOK, 1:2

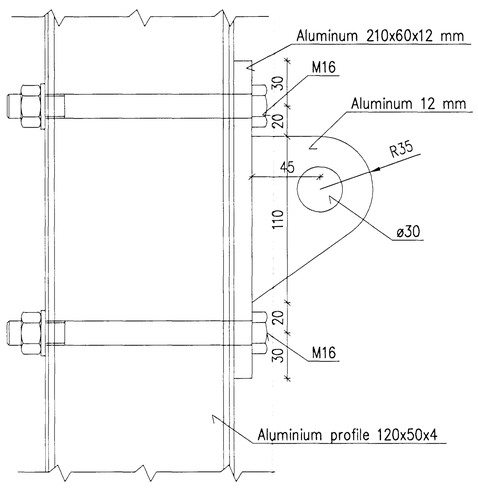

2/– 1:10

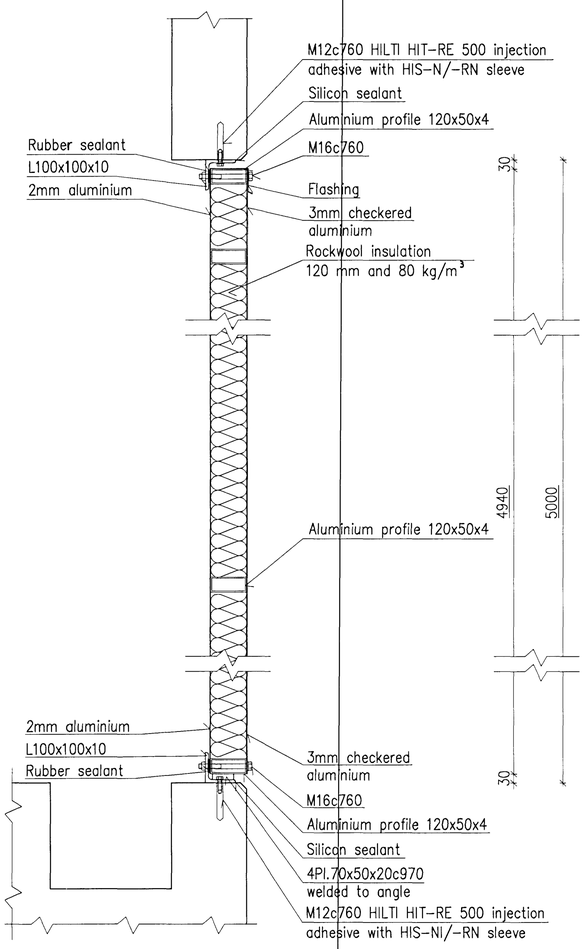

1/– 1:10

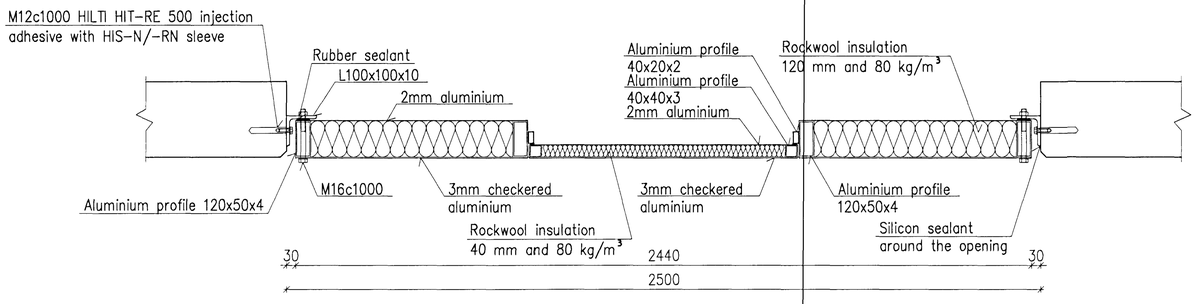

3/– 1:10

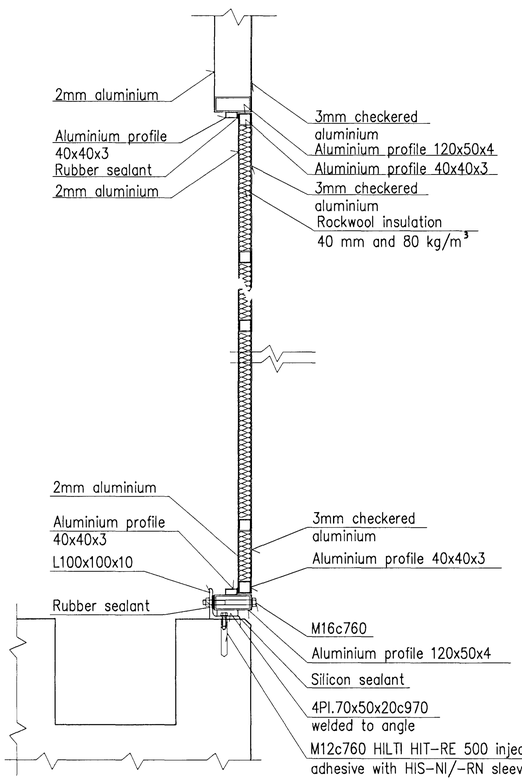

Samþykkt þann
01 OCT 2012
Byggingafulltrúinn í Hafnarfirði
F.h. Sigurður Steinar Jónsson

Nicki Indriðason
Kt. 181144-3949
NI

1:2 100 0 100 200 mm
1:10 100 0 200 400 600 800 1000 mm
1:20 1000 0 1000 2000 mm

Skýringar / Legend:

Útg.nr / Rev.no	Lýsing / Description	Dagsetning / Date	Hönn/Tkn / Des/Drw	Yfirf / Chkd	Notk.heim Suppl.Ref	Notk.heim ISAL Ref
3	Record drawing	2012.09.12	HS	NI	EG	

This drawing is the property of Rio Tinto Alcan Iceland Ltd. and handed out for personal use only. It may neither be copied nor made available to others without permission of Rio Tinto Alcan Iceland Ltd. The receiver is liable for any misuse.

Stærð / Format: A1 Mkv. / Scale: 1:2/10/20
Dimensions without tolerances according to ISO 2768-1 medium.

HRV & HATCH JOINT VENTURE ISAL PRODUCTION UPGRADE

Dagsetning / Date	2011.03.29
Hannað / Designed	HS
Teikn / Drawn	LDB
Verktaki / Supplier	HRV
Teikn.nr.verktaka / Supplier drw.no.	IDP-410-ZA-015-210
Samþ.yfirf / Approved	NI
Yfirf / Chkd	NI
Hluti af: / Part of:	

IPU410-RECTIFIER BUILDINGS
A5/S1, B5/S2
REMOVABLE ALUMNIUM WALL, SIDE VIEW, SECTIONS
Teg.teikningar / Dwg. type: STRUCTURAL STEEL

Flokkur nr.:	Blað nr.:	Næsta blnr.:
Kostn.nr.-Cono. / Bún.nr.-Eq.no		
4011	13981	
AKS		
UB11		

ISAL Alcan Iceland Ltd Straumsvík IS-222 Hafnarfjordur Iceland

Teikn.nr. ISAL /Drw.no. of ISAL: 251351
Breyt./Rev.: A

Rio Tinto Alcan

ISAL Yfirfarið og skráð, dags / ISAL Checked, date
ISAL Samþykkt, dags / ISAL Approved, date

C:\IDP\01_IDP\400 – Reduction\410 Substation\Drawings\Civil\IDP-410-ZA-015-210.dwg