PLAN VIEW, 1:200

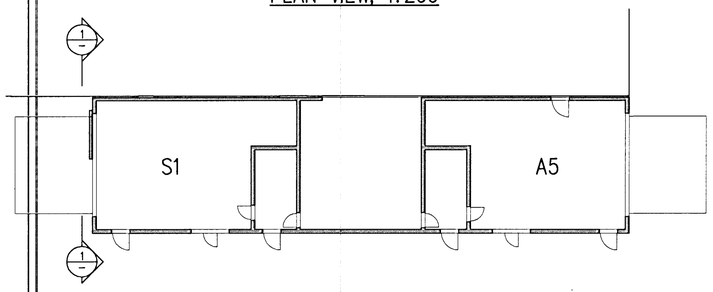

1 – SIDE VIEW, 1:50 WALL GIRTS SHOWN

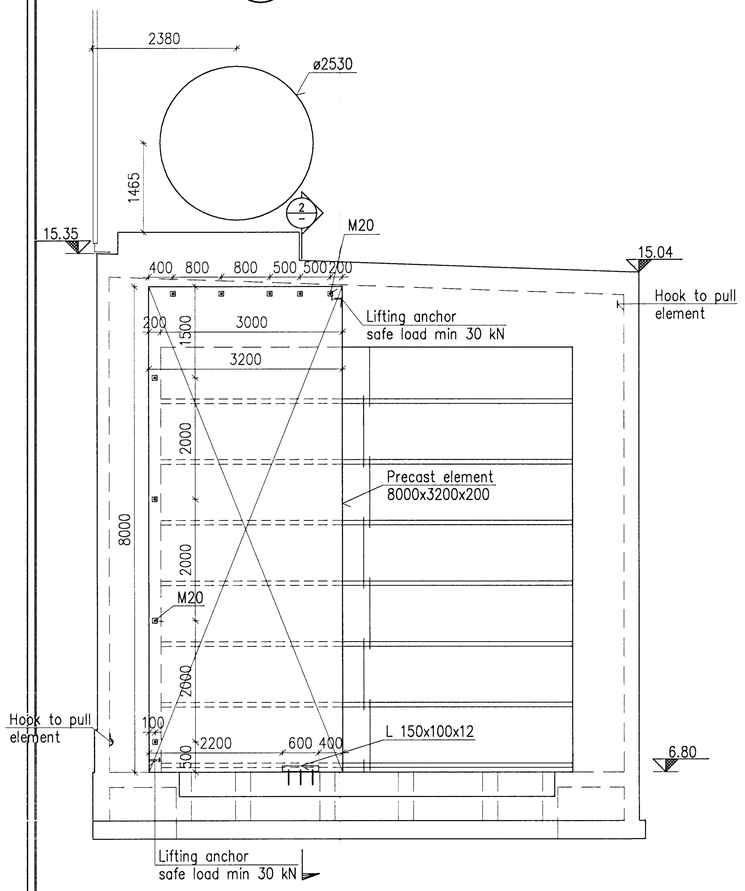

2 – SECTION, 1:20

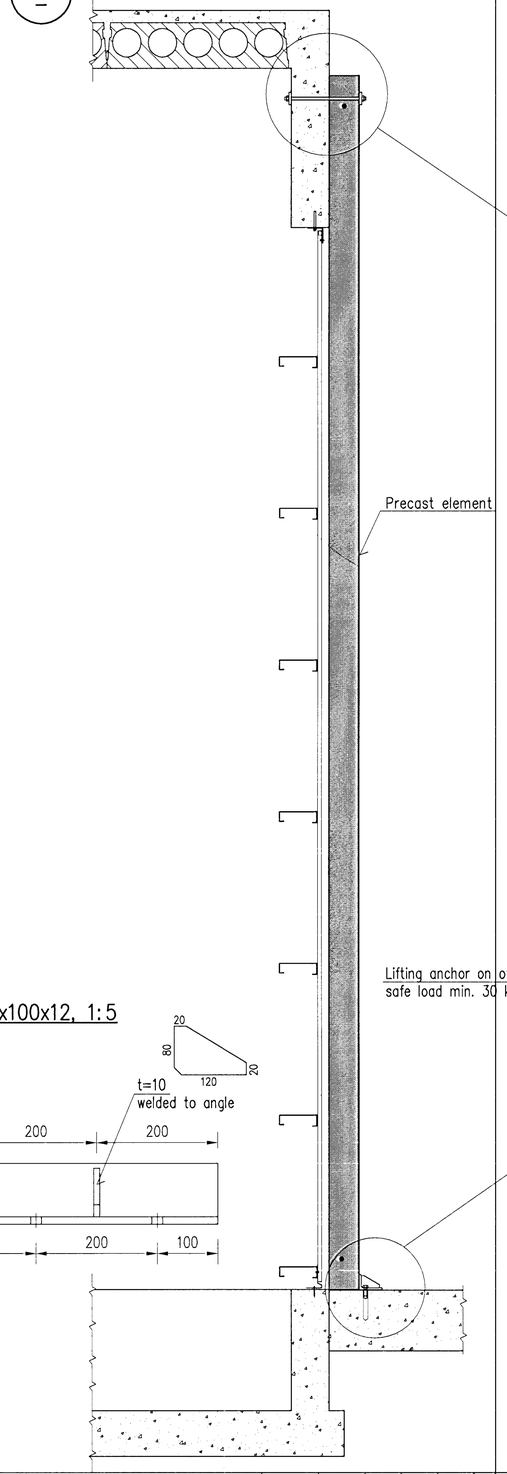

1:5

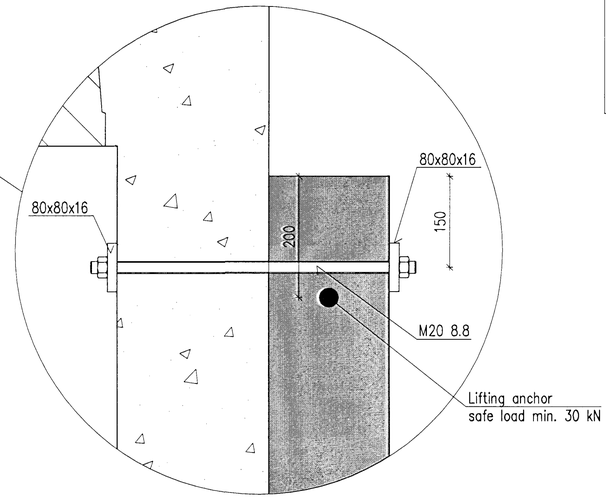

L 150x100x12, 1:5

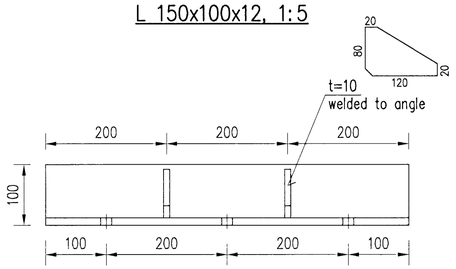

1:5

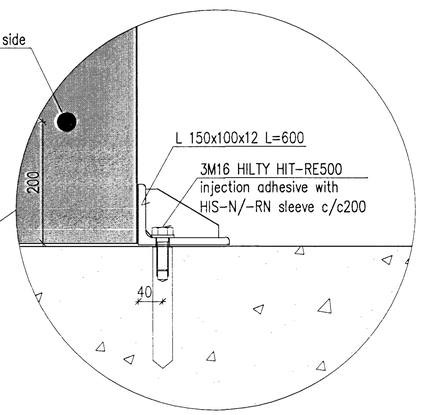

CONCRETE: C30/37

REINFORCEMENT–SECTION, 1:20

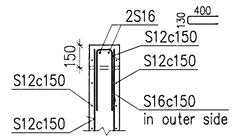

REINFORCEMENT–SECTION, 1:20

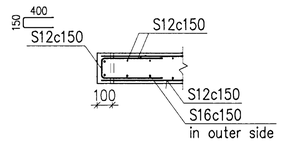

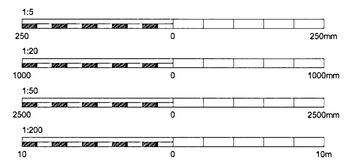

Samþykkt þann
01 OCT 2012
Byggingafulltrúinn í Hafnarfirði
F.h. Sigurður Steinar Jónsson

Nicki Indriðason
Kt. 181144-3949 NI

Skýringar / Legend:

Lifting hooks for transport are not shown, they shall be in accordance with contractors installing method statement.

Rev no	Lýsing / Description	Dagsetning / Date	Han/Tkn Des/Drw	Yfirf Chd	Notk.heim Suppl Rel	Notk.heim ISAL Rel
2	Record drawing	2012.09.12	HS	NI		

This drawing is the property of Rio Tinto Alcan Iceland Ltd. and handed out for personal use only. It may neither be copied nor made available to others without permission of Rio Tinto Alcan Iceland Ltd. The receiver is liable for any misuse.

Stærð / Format: A1 Mkv. / Scale: 1:5/20/50/200

Dimensions without tolerances according to ISO 2768-1 medium.

HRV & HATCH JOINT VENTURE ISAL PRODUCTION UPGRADE

Dagsetning / Date: 2011.10.21

Hannað / Designed: HS | Teikn / Drawn: LDB

Verktaki / Supplier: HRV

Teikn.nr.verktaka / Supplier drw.no.: IDP-410-CA-015-280

Samþykkt / Approved: NI | Yfirf / Chkd

Hluti af: / Part of:

IPU410–RECTIFIER BUILDINGS

A5/S1

FIRE PROTECTION WALL

Teg.teikningar / Dwg. type: FORM WORK

Flokkur nr.: | Blað nr.: | Næsta blnr.:

Kostn.nr.–Cono. / BGn.nr.–Eq.no: 4011 13981

AKS: UB11

Teikn.nr. ISAL /Drw.no. of ISAL: 251276

Breyt./Rev.: A

Rio Tinto Alcan

ISAL Alcan Iceland Ltd Straumsvík IS-222 Hafnarfjörður Iceland

ISAL Yfirfarið og skráð, dags / ISAL Checked, date

ISAL Samþykkt, dags / ISAL Approval, date

C:\IDP\01_IDP\400 – Reduction\410 Substation\Drawings\Civil\IDP-410-CA-015-280.dwg