Samþykkt þann
01 OCT 2012
Byggingafulltrúinn í Hafnarfirði
F.h. Sigurður Steinar Jónsson

Nicki Indriðason
Kt. 181144-3949 NI

## G/231 SIDE VIEW, 1:20




## PLAN VIEW, 1:50




## 1/– SECTION, 1:20

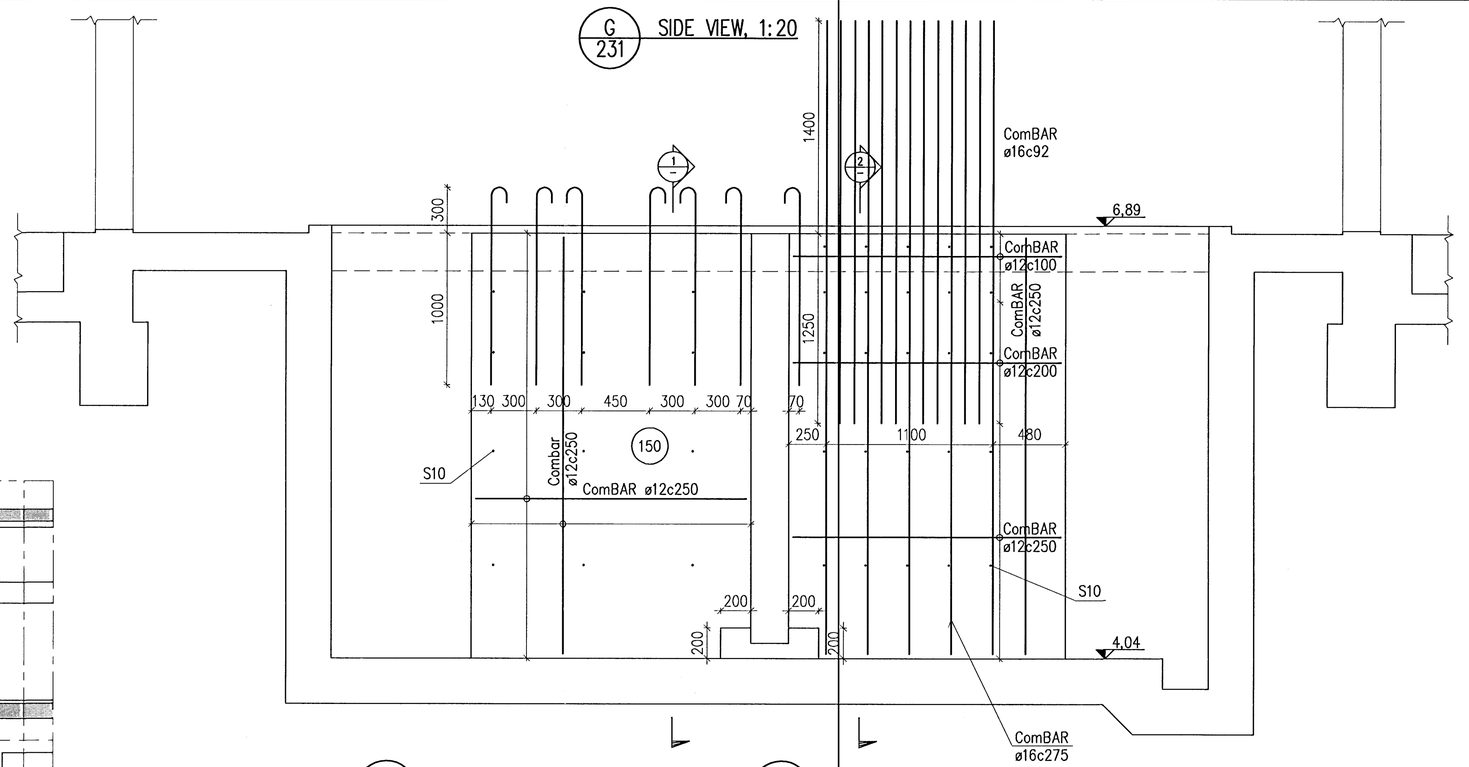


## 2/– SECTION, 1:20

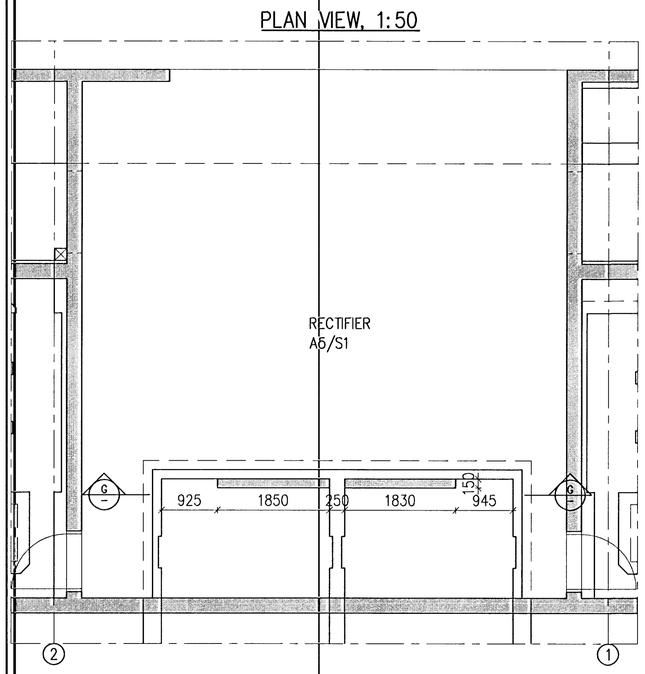


## 3/– SECTION, 1:5

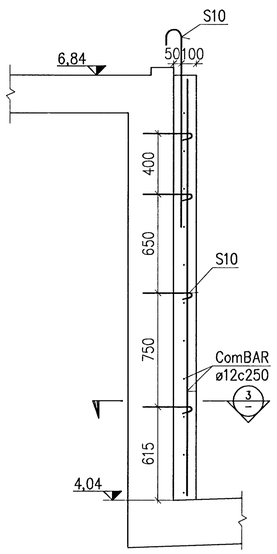


1:5 250 0 250mm
1:20 1000 0 1000mm
1:50 2500 0 2500mm

Skýringar:
Legend:
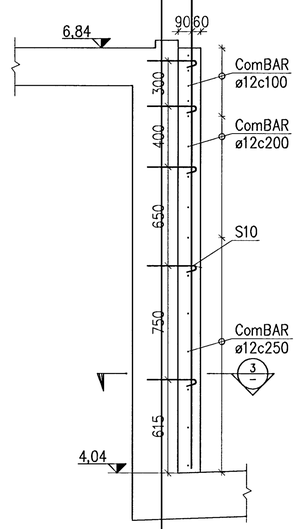
## GENERAL NOTES:

Also see drw. IDP-410-CA-015-030

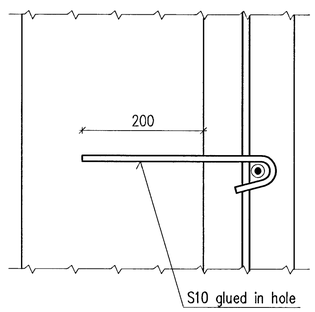Concrete: C30/37:XF3-32

Reinforcement:
ComBAR are glass-fibre Reinforced Plastic Reinforcement.
Ultimate tensile strength = 1000 MPa.

C:\IDP\01_IDP\400 – Reduction\410 Substation\Drawings\Civil\IDP-410-CA-015-249.dwg

| Útg nr Rev no | Lýsing Description | Dagsetning Date | Han/Tkn Des/Drw | Yfirf Ckd | Notk heim Suppl Ref | Notk heim ISAL Ref |
|---|---|---|---|---|---|---|
| 3 | Record drawing | 2012.09.12 | HS | NI | | |

This drawing is the property of Rio Tinto Alcan Iceland Ltd. and handed out for personal use only. It may neither be copied nor made available to others without permission of Rio Tinto Alcan Iceland Ltd. The receiver is liable for any misuse.

Stærð Format: A1 Mkv. Scale: 1:5/20/50
Dimensions without tolerances according to ISO 2768-1 medium.

HRV & HATCH JOINT VENTURE
ISAL PRODUCTION UPGRADE

| | |
|---|---|
| Dagsetning / Date | 2012.01.20 |
| Hannað / Designed | HS |
| Teikn / Drawn | LDB |
| Verktaki / Supplier | HRV |
| Teikn.nr.verktaka / Supplier drw.no. | IDP-410-CA-015-249 |
| Samþ.af / Approved | NI |
| Yfirf / Chkd | NI |
| Hluti af: / Part of: | |

IPU 410 – RECTIFIER BUILDINGS
BUSBAR TUNNEL BETWEEN PL1 & PL2
CORRECTED LOCATION OF ENDWALL

| | | |
|---|---|---|
| Flokkur nr.: | Blað nr.: | Næsta blnr.: |
| Kostn.nr.–Ccno. / Bún.nr.–Eq.no | 4011 | 16961 |
| Teg.teikningar / Dwg. type: | AKS | UB21 |
| Teikn.nr. ISAL /Drw.no. of ISAL | 251256 | Breyt./Rev. A |

Rio Tinto Alcan
ISAL Álverið við Straumsvík IS-222 Hafnarfjörður Iceland

ISAL Yfirfarið og skráð, dags / ISAL Checked, date
ISAL Samþykkt, dags / ISAL Approved, date