



ROOF, 1:50

Samþykkt þann
 01 OCT 2012
 Byggingafulltrúinn / Hjúkandi
 F.H. Sigurður Steinar Jónsson


Hildur Indriðadóttir
 Kt. 181144-3949 NI

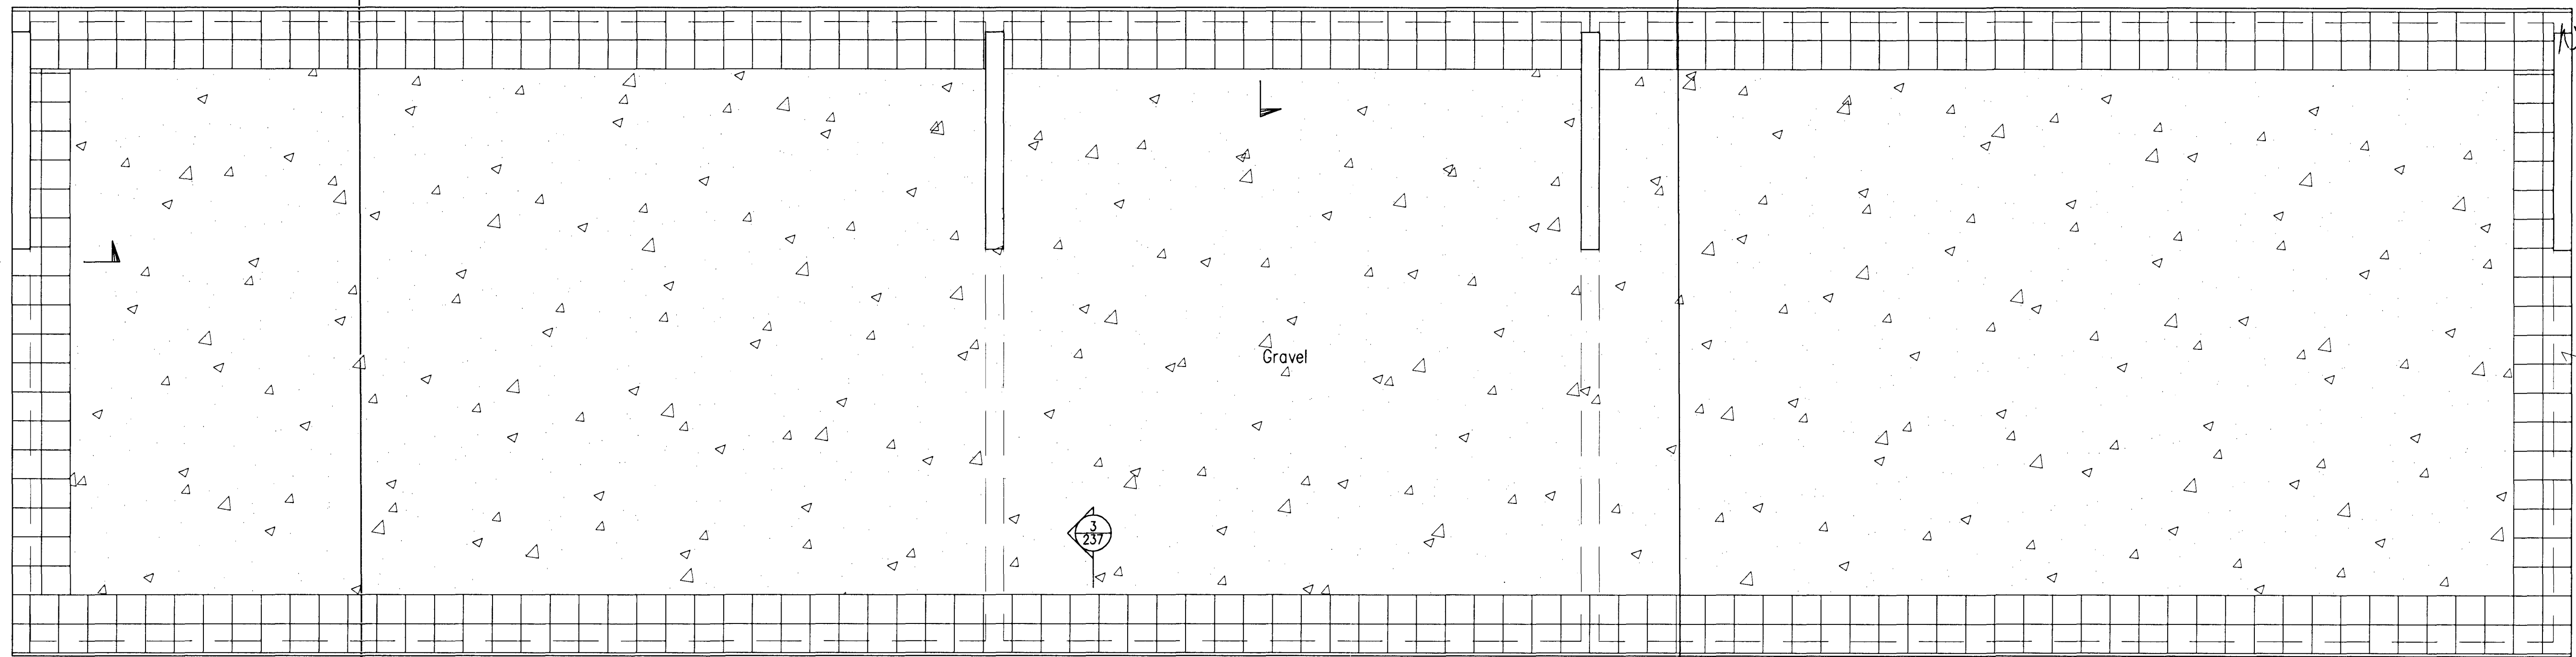

Paving stones
 400x400x50

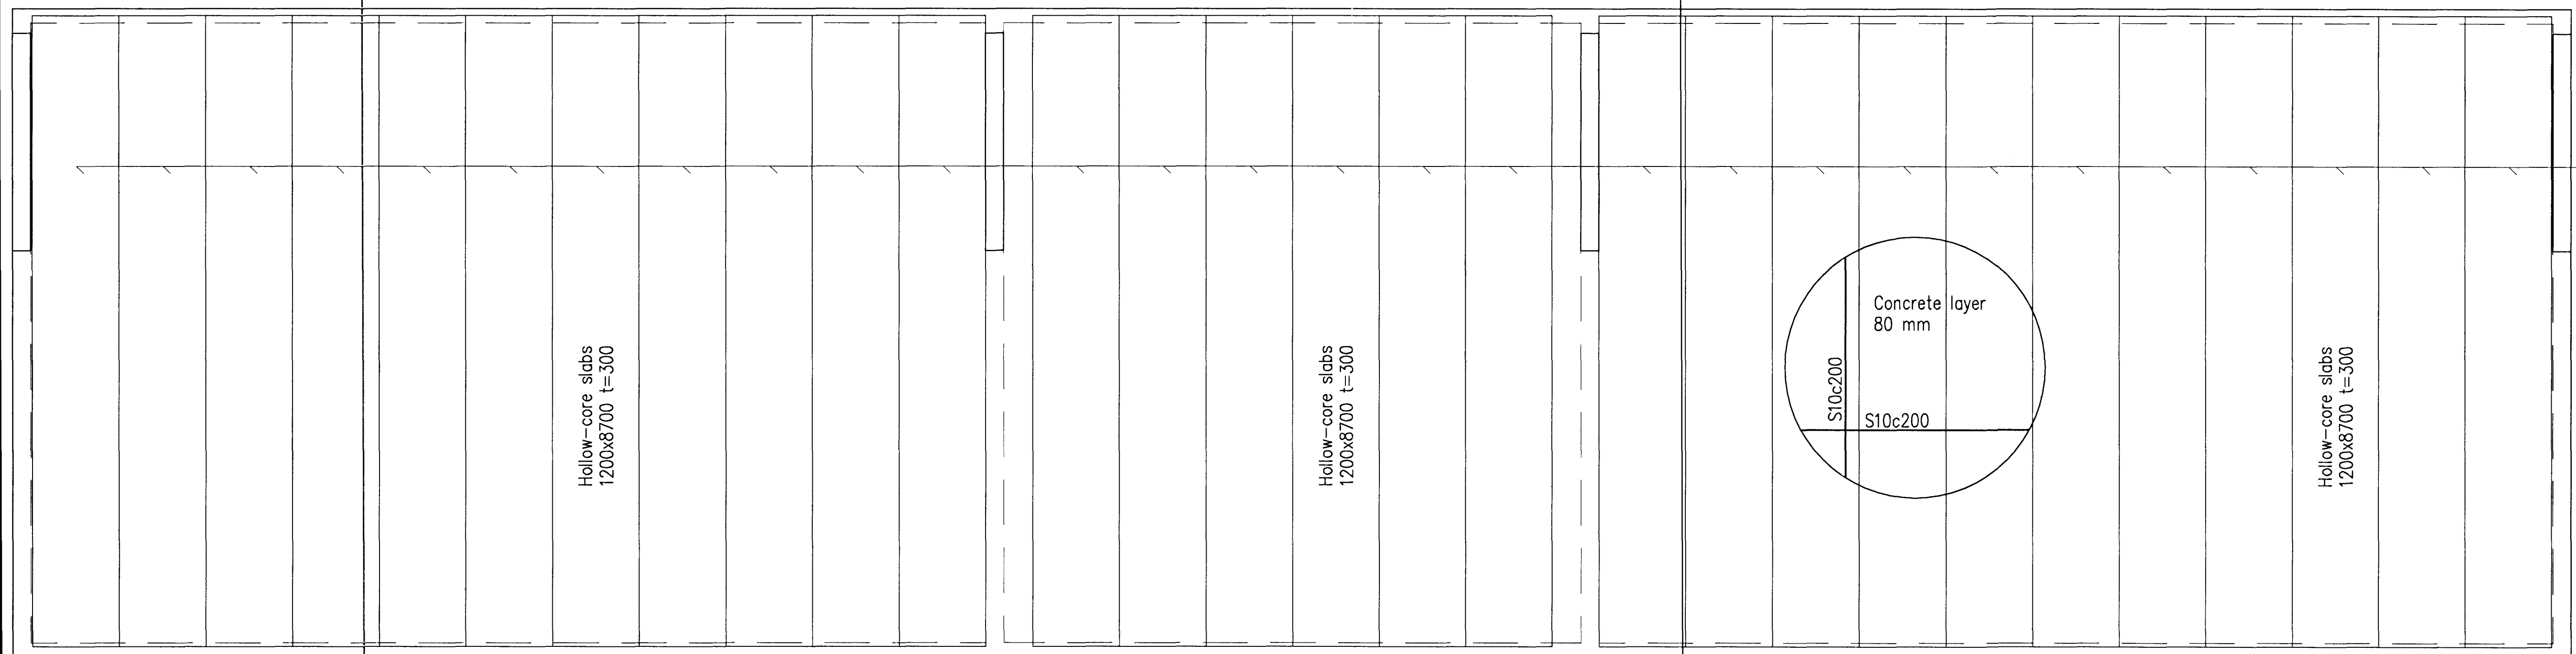

Hollow-core slab
 Load:
 Selfweight 3,0kN/m²
 Concrete 2,0kN/m²
 Gravel 2,0kN/m²
 Snow 5,0kN/m²
 Total 12,0kN/m²
 Fire resistance REI 180.

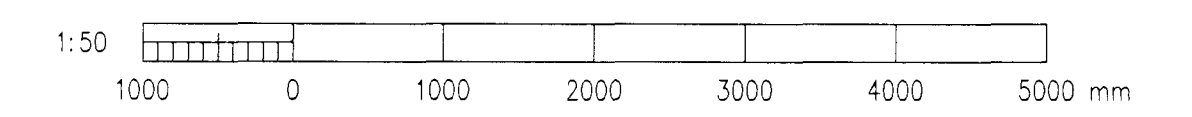

Skýringar: Legend:	<p>This drawing is the property of Rio Tinto Alcan Iceland Ltd. and handed out for personal use only. It may neither be copied nor made available to others without permission of Rio Tinto Alcan Iceland Ltd. The receiver is liable for any misuse.</p>									
	<p>Dimensions without tolerances according to ISO 2768-1 medium.</p>									
14	Record drawing	2012.09.12	HS	NI	SK	PER				
Útg. nr. Rev. no.	Lýsing Description	Dagsetning Date	Har./Ön. Des./Drw	Yfirf. Ckd	Notk. heim. Suppl. Rel	Nösk. heim. ISAL. Rel				
				Dagsetning / Date 2008.10.01		IPU410-RECTIFIER BUILDINGS A5/S1 ROOF		Flokkur nr.: Blað nr.: Nasta bl.: 4011 13981		
		Hönnuð / Designed HS		Tekn. / Drawn LDB		Verktaki / Supplier HRV		Teg. teikningar / Dwg. type: BUILDING FITTOUT		
		Tekn. nr. verktaka / Supplier drw. no. IDP-410-CA-015-236		Samþykkt / Approved NI		Yfirf. / Chkd NI		ISAL Tekn. nr. ISAL / Drw. no. of ISAL 251252		
		Húti of: / Part of:		Rio Tinto Alcan Alcan Iceland Ltd Straumurkvik IS-222 Hafnarþorur Ísland		ISAL Samþykkt, dags / ISAL Checked, date E1/SJö 2010.09.21		ISAL Samþykkt, dags / ISAL Approval, date IKR / 2010.09.21		