


Samþykkt þann  
 01 OCT 2012  
 Byggingafrutturinn I Hlynur  
 F.h. Sigurður Steinar Jónsson

Nick Indrisarou  
 Kt. 181144-3949 NI

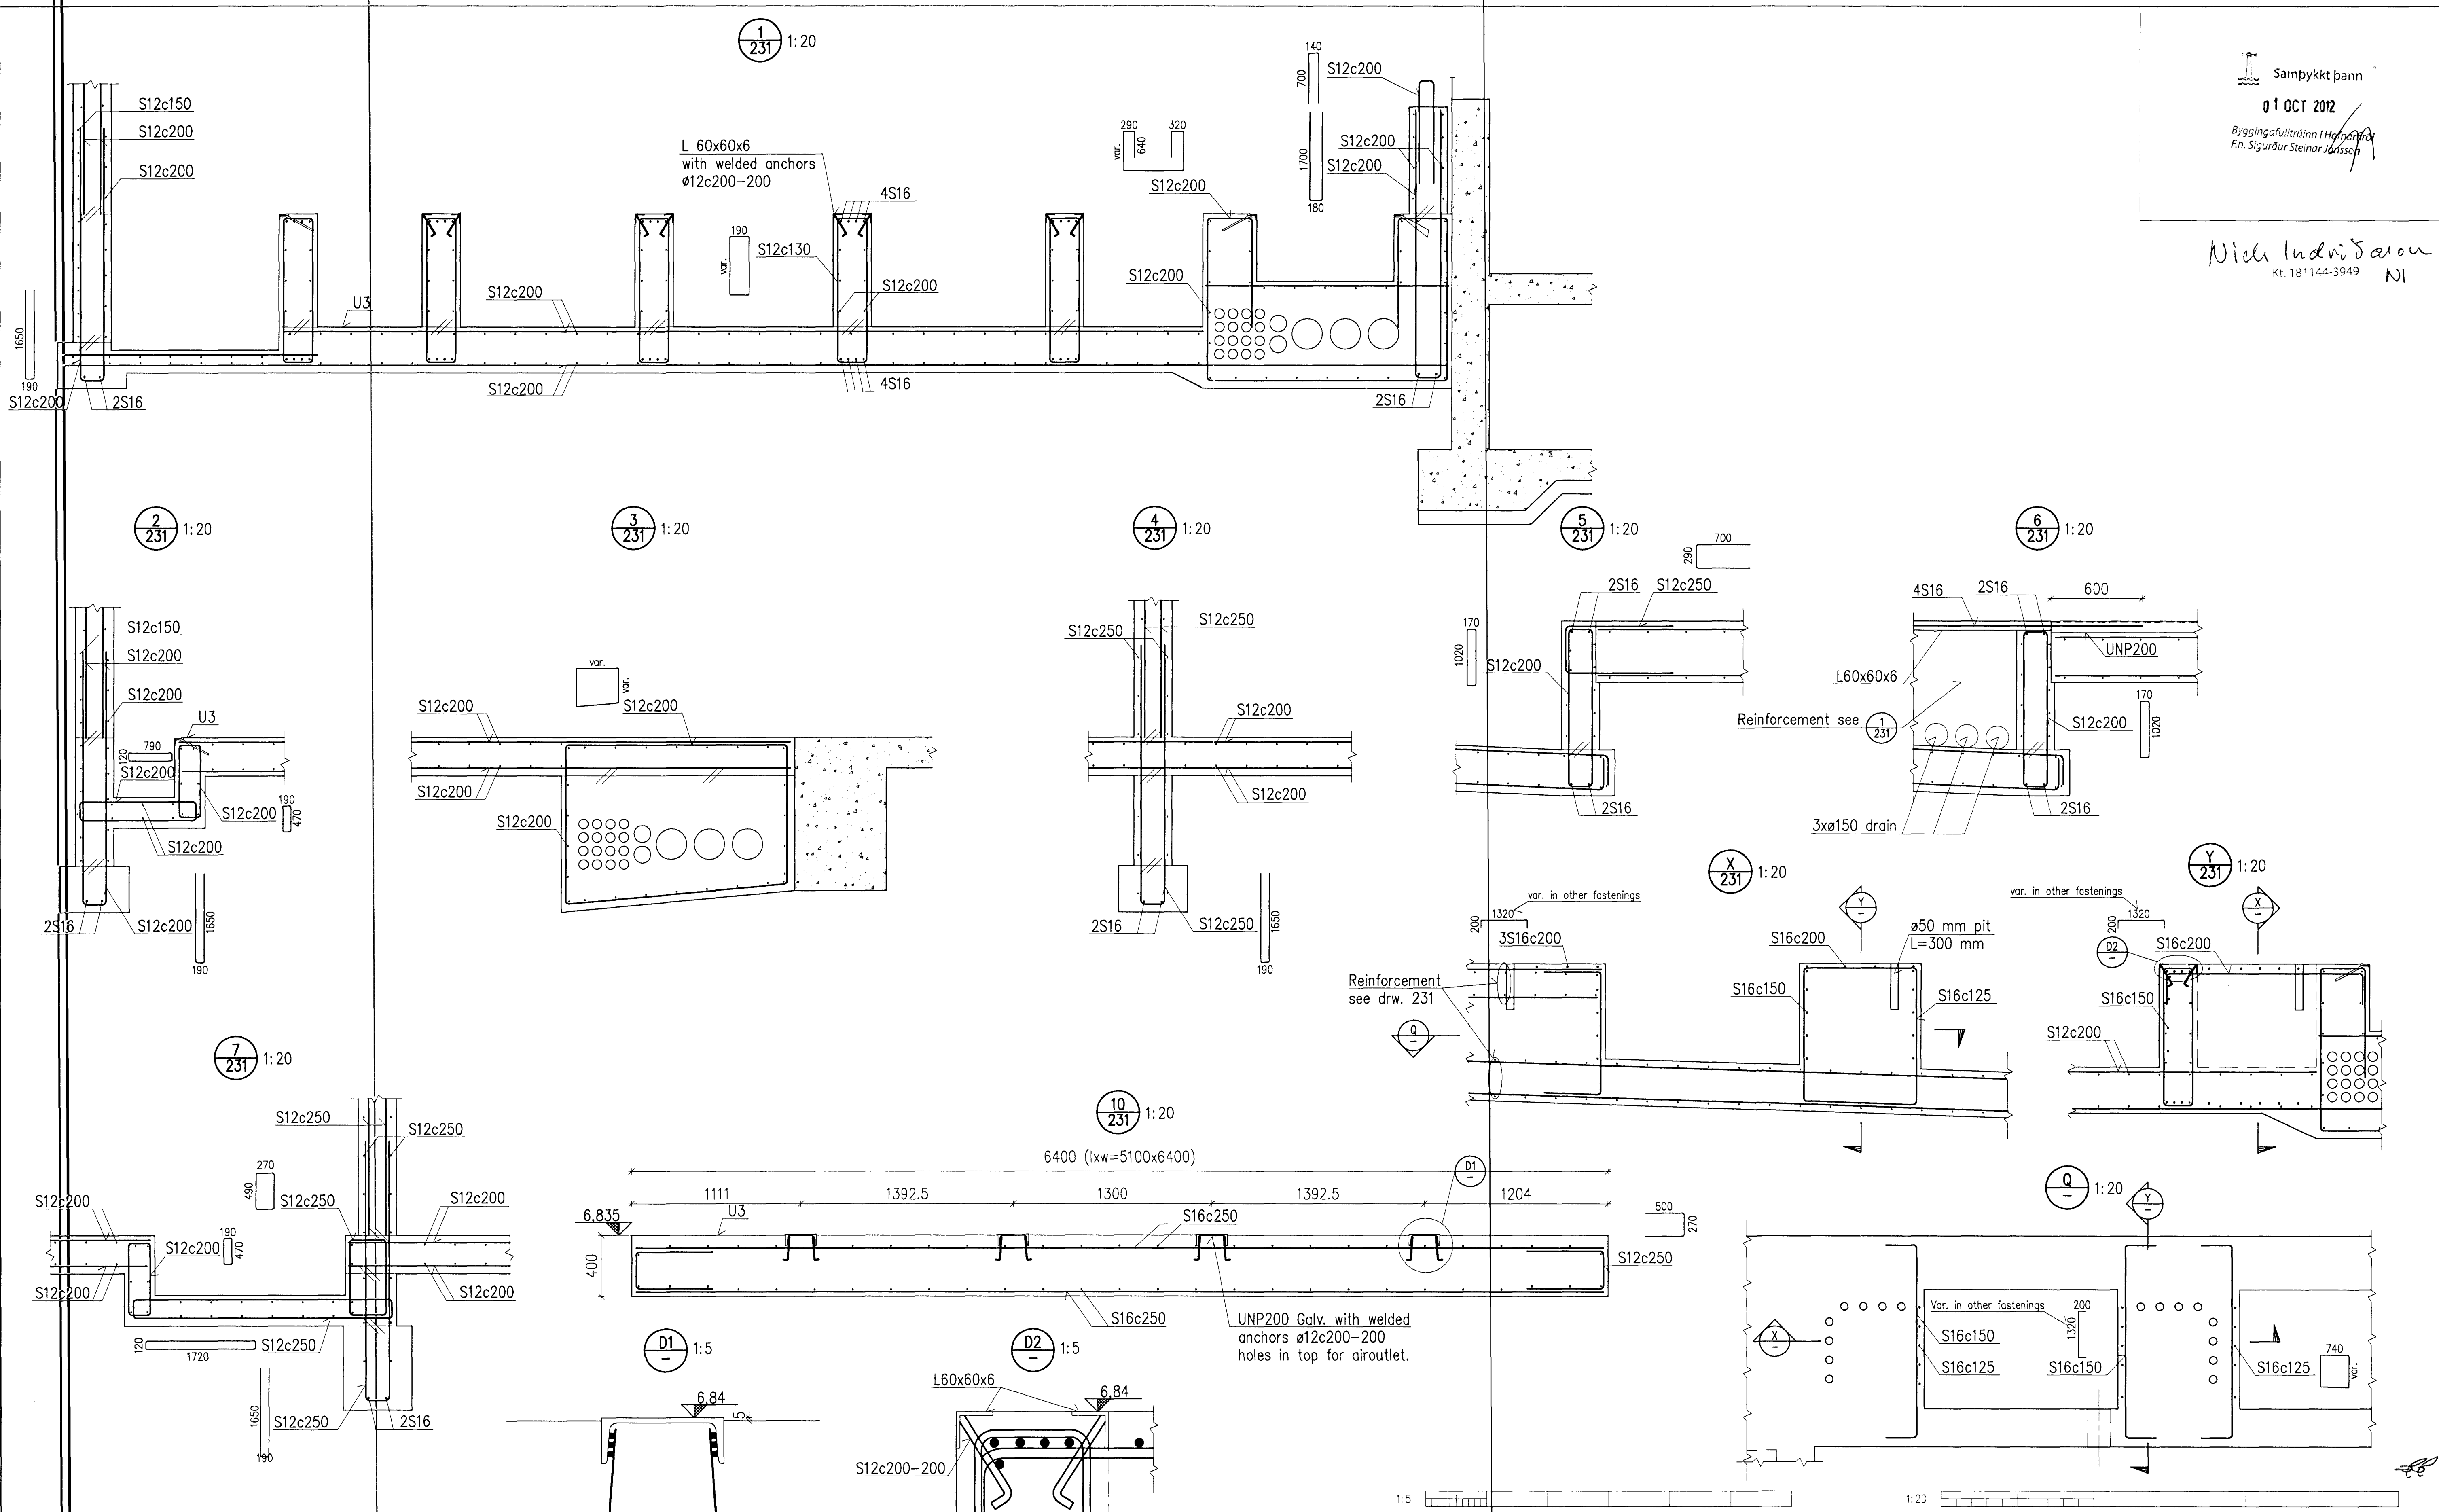

Skýringar Legend:	This drawing is the property of Rio Tinto Alcan Iceland Ltd. and handed out for personal use only. It may neither be copied nor made available to others without permission of Rio Tinto Alcan Iceland Ltd. The receiver is liable for any misuse.					Dagsetting / Date 2008.10.01 Hönnuð / Designed HS Teikn / Drawn LDB Verktaki / Supplier HRV	IPU410-RECTIFIER BUILDINGS A5/S1 SECTIONS REINFORCEMENT	Flokkur nr.: 4011 Blað nr.: 13981	Næsta bl. nr.: AKS UB11
	Scale: 1:5, 1:20 Dimensions without tolerances according to ISO 2788-1 medium.								
18 Record drawing Útg. nr. Rev. no.	Dagsetting Date 2012.09.12	Hönnuð/ Des./Dw. HS	Yfir/ Chk. NI	Notk. heiti/ Name reth	Notk. heiti/ Name reth	ISAL Verkfæri og skráð, dags / ISAL Checked, date	ISAL Samþykkt, dags / ISAL Approved, date		