A/224 SECTION, 1:50

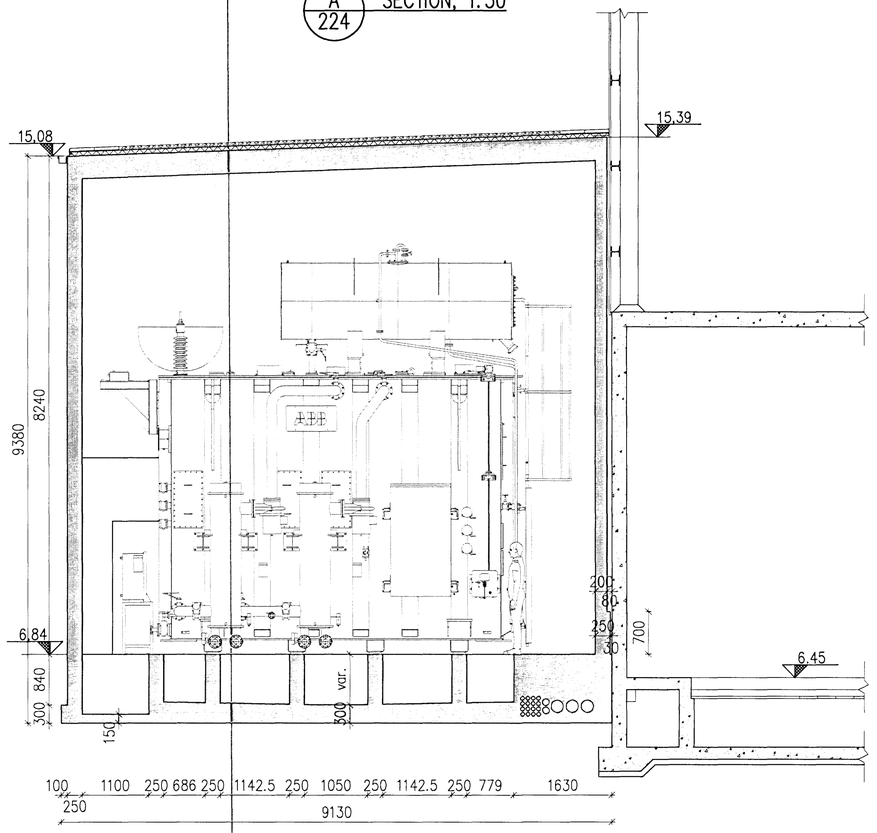

B/224 SECTION, 1:50

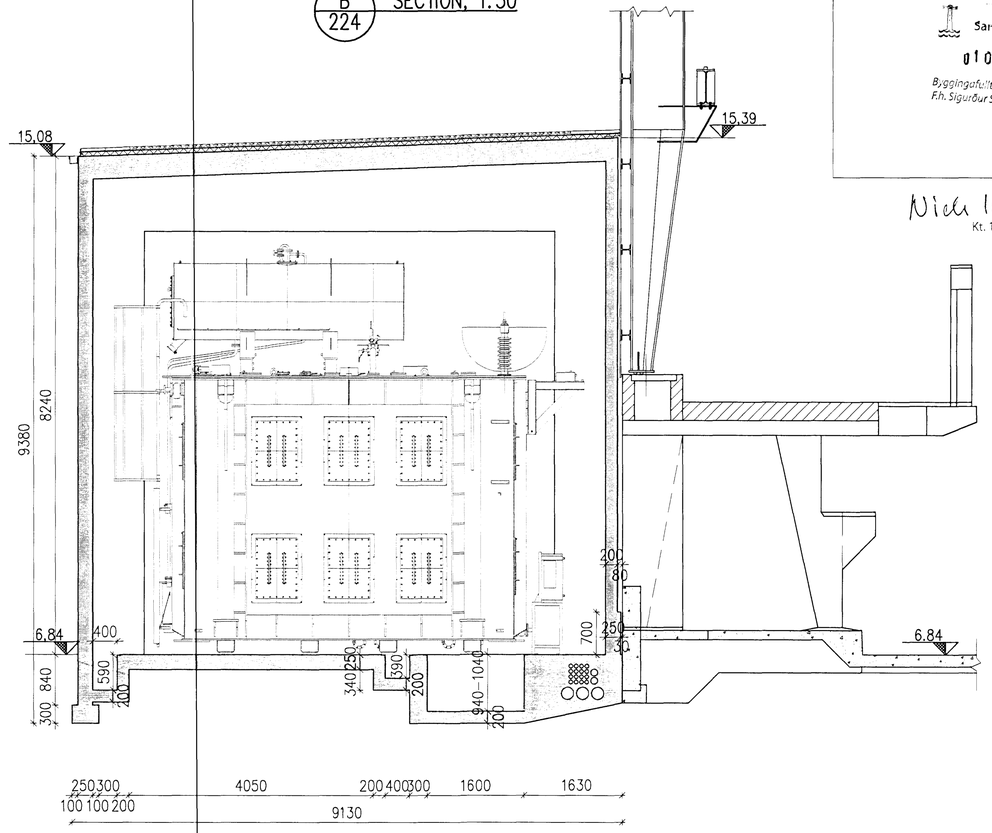

Samþykkt þann
01 OCT 2012
Byggingafulltrúinn í Hafnarfirði
F.h. Sigurður Steinar Jónsson

Niels Indriðason
Kt. 181144-3949 NI

E/224 SECTION, 1:20

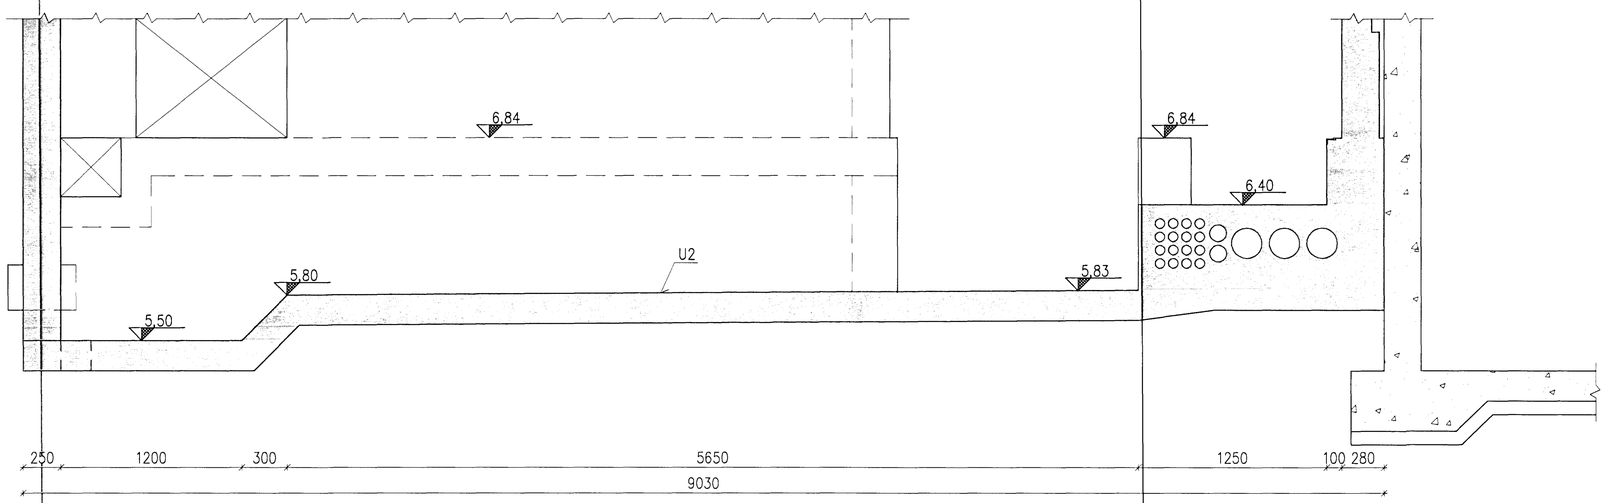

1:50
1000 0 1000 2000 3000 4000 5000 mm

1:20
1000 0 1000 2000 mm

Skýringar:
Legend:

C:\IDP\01 IDP\400 – Reduction\410 Substation\Drawings\Civil\IDP-410-CA-015-227.dwg

Útg.nr Rev.no	Lýsing Description	Dagsetning Date	Hön/Tkn Des/Drw	Yfirf Chkd		Notk.heim Suppl.Ref	Notk.heim ISAL Ref
16	Record drawing	2012.09.12	HS	NI			

This drawing is the property of Rio Tinto Alcan Iceland Ltd. and handed out for personal use only. It may neither be copied nor made available to others without permission of Rio Tinto Alcan Iceland Ltd. The receiver is liable for any misuse.

Stærð / Format: A1 Mkv. / Scale: 1:20, 1:50
Dimensions without tolerances according to ISO 2768-1 medium.

HRV & HATCH JOINT VENTURE
ISAL PRODUCTION UPGRADE

Dagsetning / Date	2009.01.22
Hannað / Designed	HS
Teikn / Drawn	LDB
Verktaki / Supplier	HRV
Teikn.nr.verktaka / Supplier drw.no.	IDP-410-CA-015-227
Samþykkt / Approved	NI
Yfirf / Chkd	NI
Hluti af: / Part of:	

IPU410–RECTIFIER BUILDINGS
A5/S1
SECTIONS A, B and E
Teg.teikningar / Dwg. type: FORM WORK

Rio Tinto Alcan
ISAL Alcan Iceland Ltd Straumsvík IS-222 Hafnarfjordur Iceland

Flokkur nr.:	Blað nr.:	Næsta bl.nr.:
Kostn.nr.-Cono. / Bún.nr.-Eq.no		
4011	13981	
AKS		
UB11		
Teikn.nr. ISAL /Drw.no. of ISAL		Breyt./Rev.
251243		A

ISAL Yfirfarið og skráð, dags / ISAL Checked, date
ISAL Samþykkt, dags / ISAL Approval, date