Samþykkt þann
01 OCT 2012
Byggingafulltrúinn í Hafnarfirði
F.h. Sigurður Steinar Jónsson

Nicki Indriðason
Kt. 181144-3949 NI

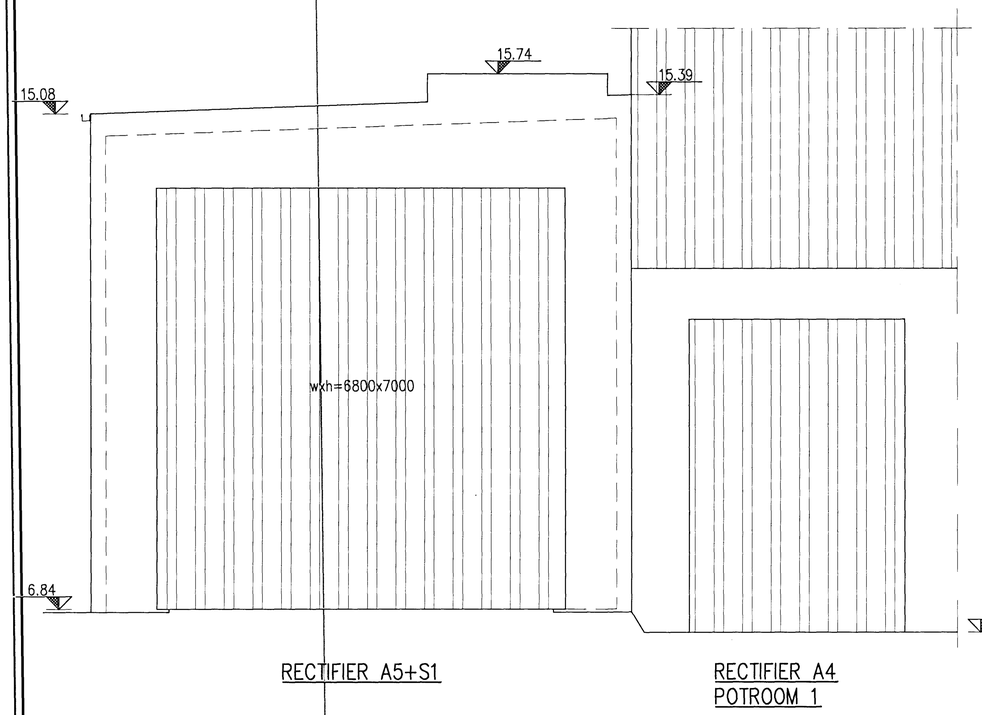

RECTIFIER A5+S1

RECTIFIER A4
POTROOM 1

SIDE VIEW 1:50

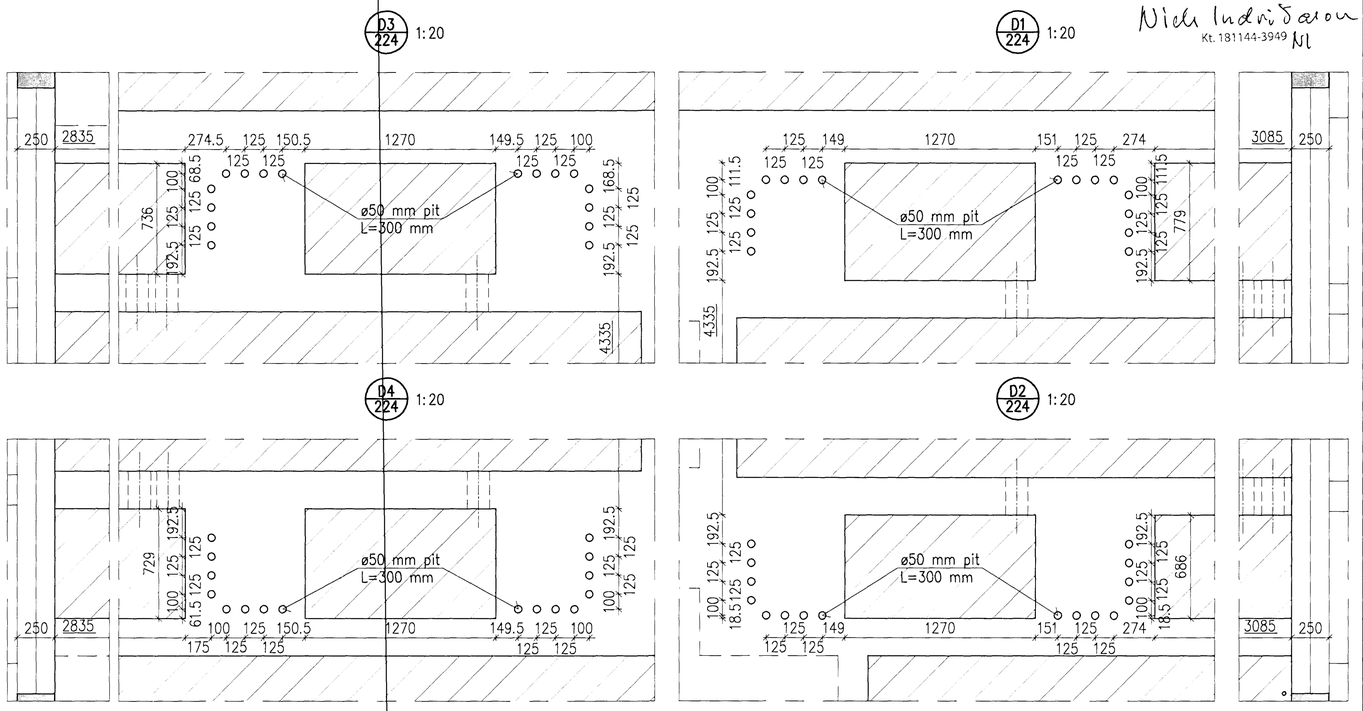

Dimensions of holes must be taken with great precision. Holes can be made with PEH pipes who will be removed/drilled out afterwards.

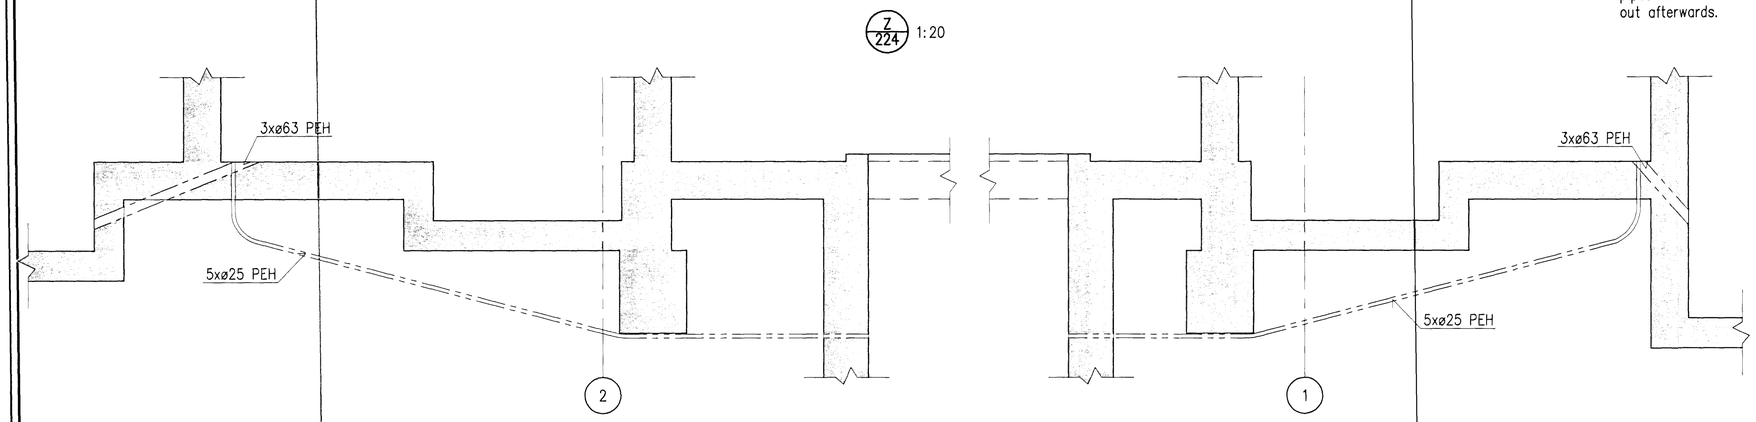

1:20 1000 0 1000 2000 mm
1:50 1000 0 1000 2000 3000 4000 5000 mm

Skýringar:
Legend:

Stg nr Rev no	Lýsing Description	Dagsetning Date	Hön/Tkn Des/Drw	Yfirf Ckd	Nota heim Suppl Rel	Nota heim ISAL Rel
16	Record drawing	2012.09.12	HS	NI		

This drawing is the property of Rio Tinto Alcan Iceland Ltd. and handed out for personal use only. It may neither be copied nor made available to others without permission of Rio Tinto Alcan Iceland Ltd. The receiver is liable for any misuse.

Stærð/Format: A1 Mkv./Scale: 1:20, 1:50
Dimensions without tolerances according to ISO 2768-1 medium.

HRV & HATCH JOINT VENTURE ISAL PRODUCTION UPGRADE

Dagsetning / Date	2009.01.22
Hannað / Designed	HS
Teikn / Drawn	LDB
Verktaki / Supplier	HRV
Teikn.nr.verktaka / Supplier drw.no.	IDP-410-CA-015-226
Samþykkt / Approved	NI
Yfirf / Ckkd	NI
Hlutl. af. / Part of:	

IPU410-RECTIFIER BUILDINGS
A5/S1
SIDE VIEW 2/2, FASTENING FOR TRANSFORMER
Teg.teikningar / Dwg. type: FORM WORK

Flokkur nr.:	Blað nr.:	Næsta blnr.:
Kostn.nr.-Cono. / Bún.nr.-Eq.no		
4011	13981	
AKS		
UB11		

Rio Tinto Alcan
ISAL Alcan Iceland Ltd Straumsvík IS-222 Hafnarfjordur Iceland

Teikn.nr. ISAL /Drw.no. of ISAL	Breyt./Rev.
251242	A

ISAL Yfirfarið og skráð, dags / ISAL Checked, date
ISAL Samþykkt, dags / ISAL Approval, date

C:\IDP\01 IDP\400 - Reduction\410 Substation\Drawings\Civil\IDP-410-CA-015-226.dwg