ROOF PURLINS, SECTION A, 1:10

061

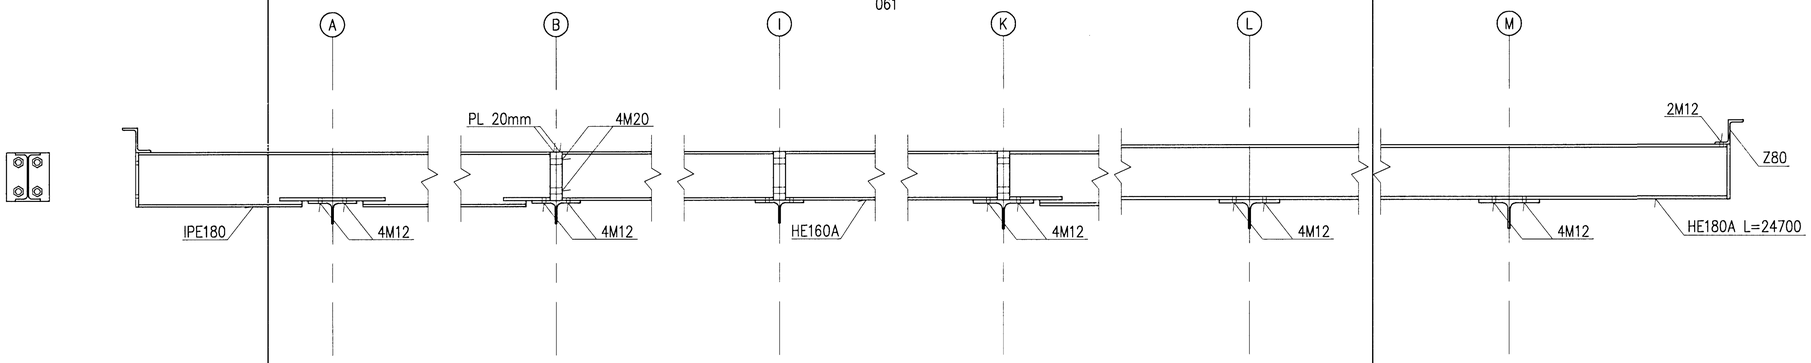

ROOF PURLINS, SECTION B, 1:10

061

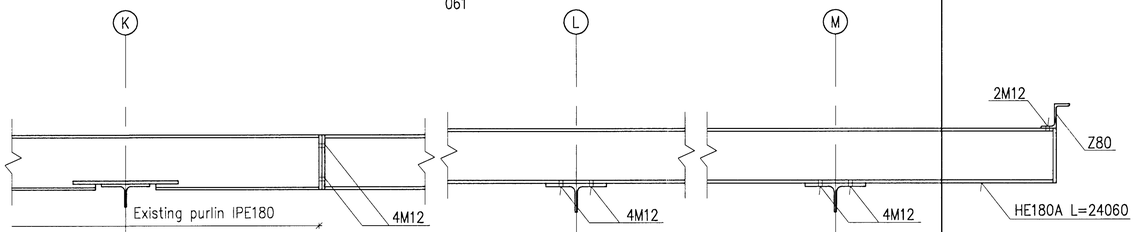

WALLS GIRTS, SECTION C, 1:50

062-063

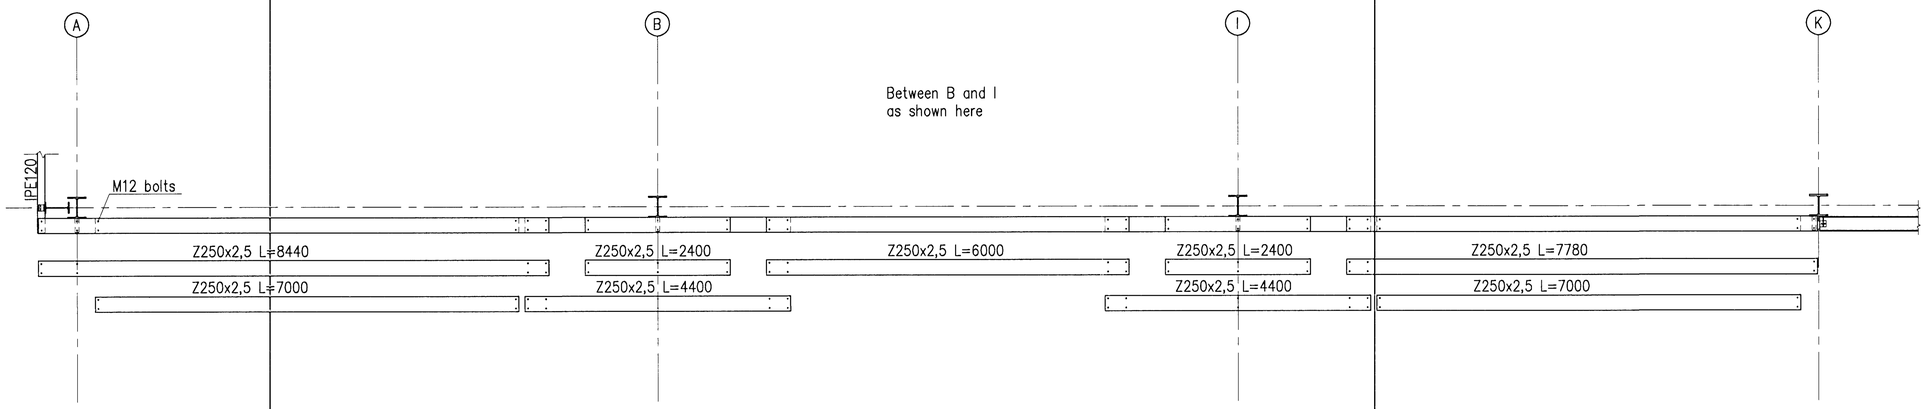

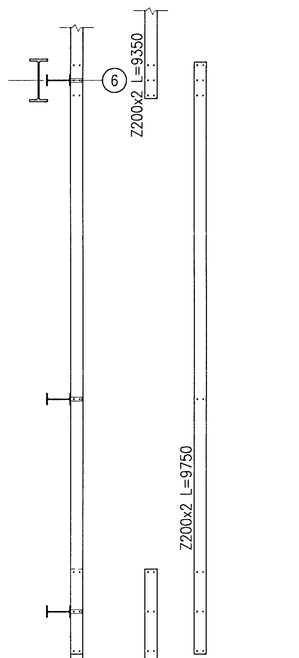

1:10
100 0 200 400 600 800 1000 mm

1:50
1000 0 1000 2000 3000 4000 5000 mm

Sambykkt þann
01 OCT 2012
Byggingafulltrúinn í Hafnarfirði
f.h. Sigurður Steinar Jónsson

Nicki Indriðason
Kt. 181144-3949

Skýringar
Legend:

Útg.nr Rev.no	Lýsing Description	Dagsetning Date	Hönn/Tkn Des/Drw	Yfirf Ckd	Nótk.heim Suppl.Rel	Nótk.heim ISAL Rel
14	Record Drawing	2012.06.11	HS	NI	EG	[illegible]

This drawing is the property of Rio Tinto Alcan Iceland Ltd. and handed out for personal use only. It may neither be copied nor made available to others without permission of Rio Tinto Alcan Iceland Ltd. The receiver is liable for any misuse.

Stærð/Format: A1 Mkv./Scale: 1:10, 1:50
Dimensions without tolerances according to ISO 2768-1 medium.

HRV & HATCH JOINT VENTURE
ISAL PRODUCTION UPGRADE

Dagsetning / Date	2008.10.01
Hannað / Designed	HS
Teikn / Drawn	LDB
Verktaki / Supplier	HRV
Teikn.nr.verktaka / Supplier drw.no.	IDP-410-ZA-015-068
Samþ.skýt / Approved	NI
Yfirf / Chkd	NI
Hluti af: / Part of:	

IPU 410 – SUBSTATION
220 kV SWITCHYARD BLD.
ROOF PURLINS AND WALL GIRTS

Teg.teikningar / Dwg. type: STRUCTURAL STEEL

Flokkur nr.: | Blað nr.: | Næsta bl.nr.:
Kostn.nr.-Cono. / BGn.nr.-Eq.no: 4011 01188
AKS: UB01

Rio Tinto Alcan
ISAL Alcan Iceland Ltd Straumsvík IS-222 Hafnarfjörður Iceland

Teikn.nr. ISAL / Drw.no. of ISAL: 251339
Breyt./Rev.: A

ISAL Yfirfarið og skráð, dags / ISAL Checked, date
ISAL Samþykkt, dags / ISAL Approval, date

C:\IDP\01 IDP\400 – Reduction\410 Substation\Drawings\Civil\IDP-410-ZA-015-068.dwg