



Sampykkt þann  
 01 OCT 2012  
 Byggingafráttirinn / Hafnaráttir  
 F.h. Sigurður Steinar Jónsson

Níels Indriásson  
 Kt: 184814-3949  
 NI

ROOF BEAMS (RB)

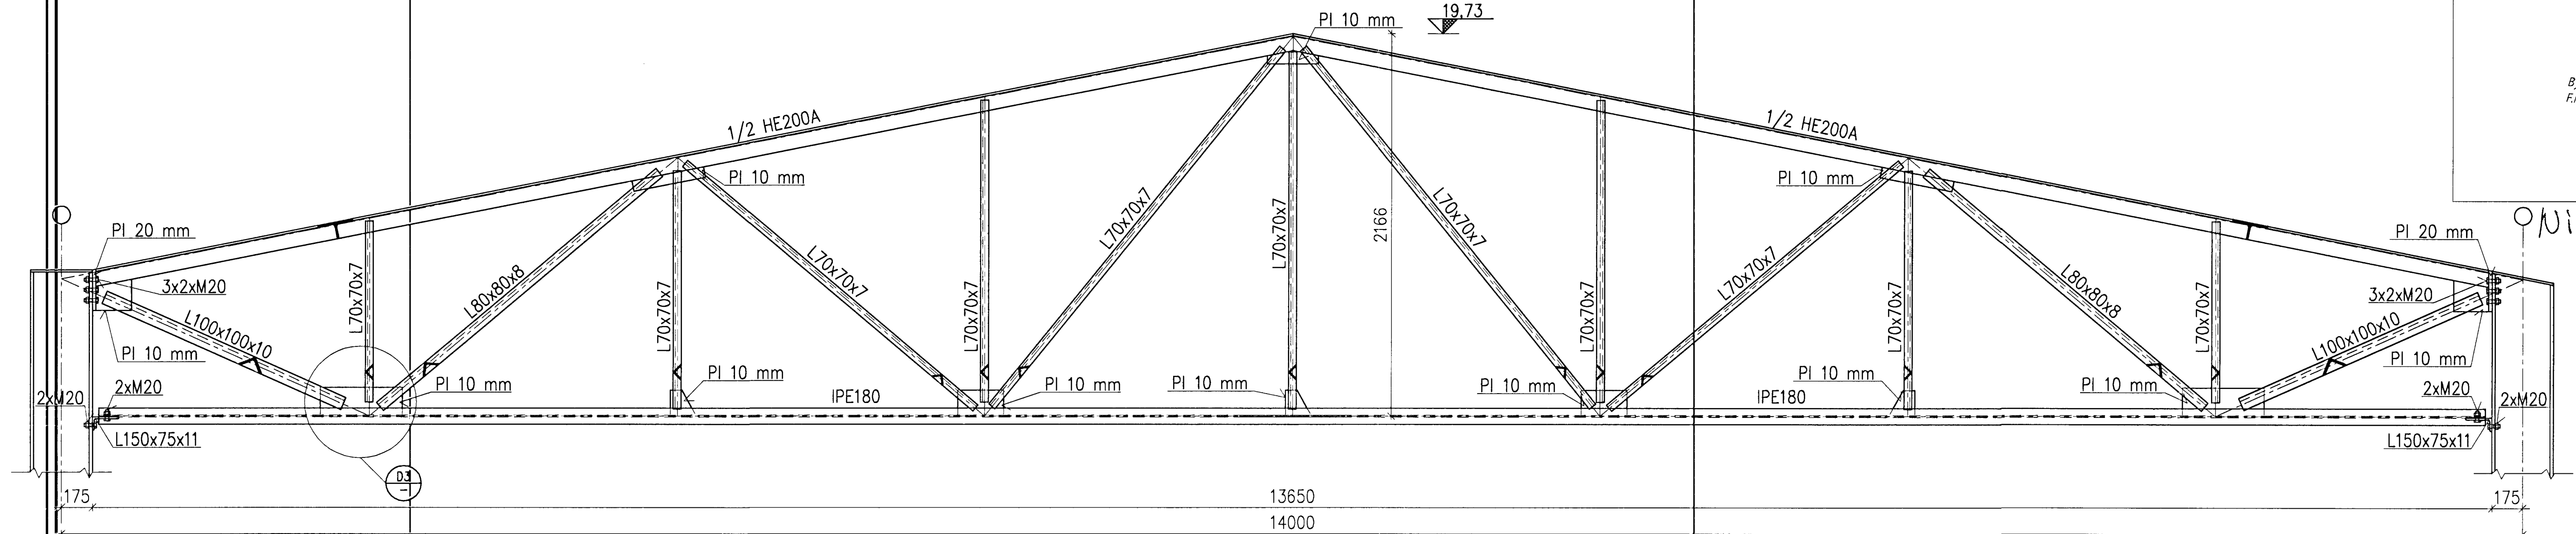


STRENGTHENING OF EXISTING ROOF BEAMS (RB) IN LINE K

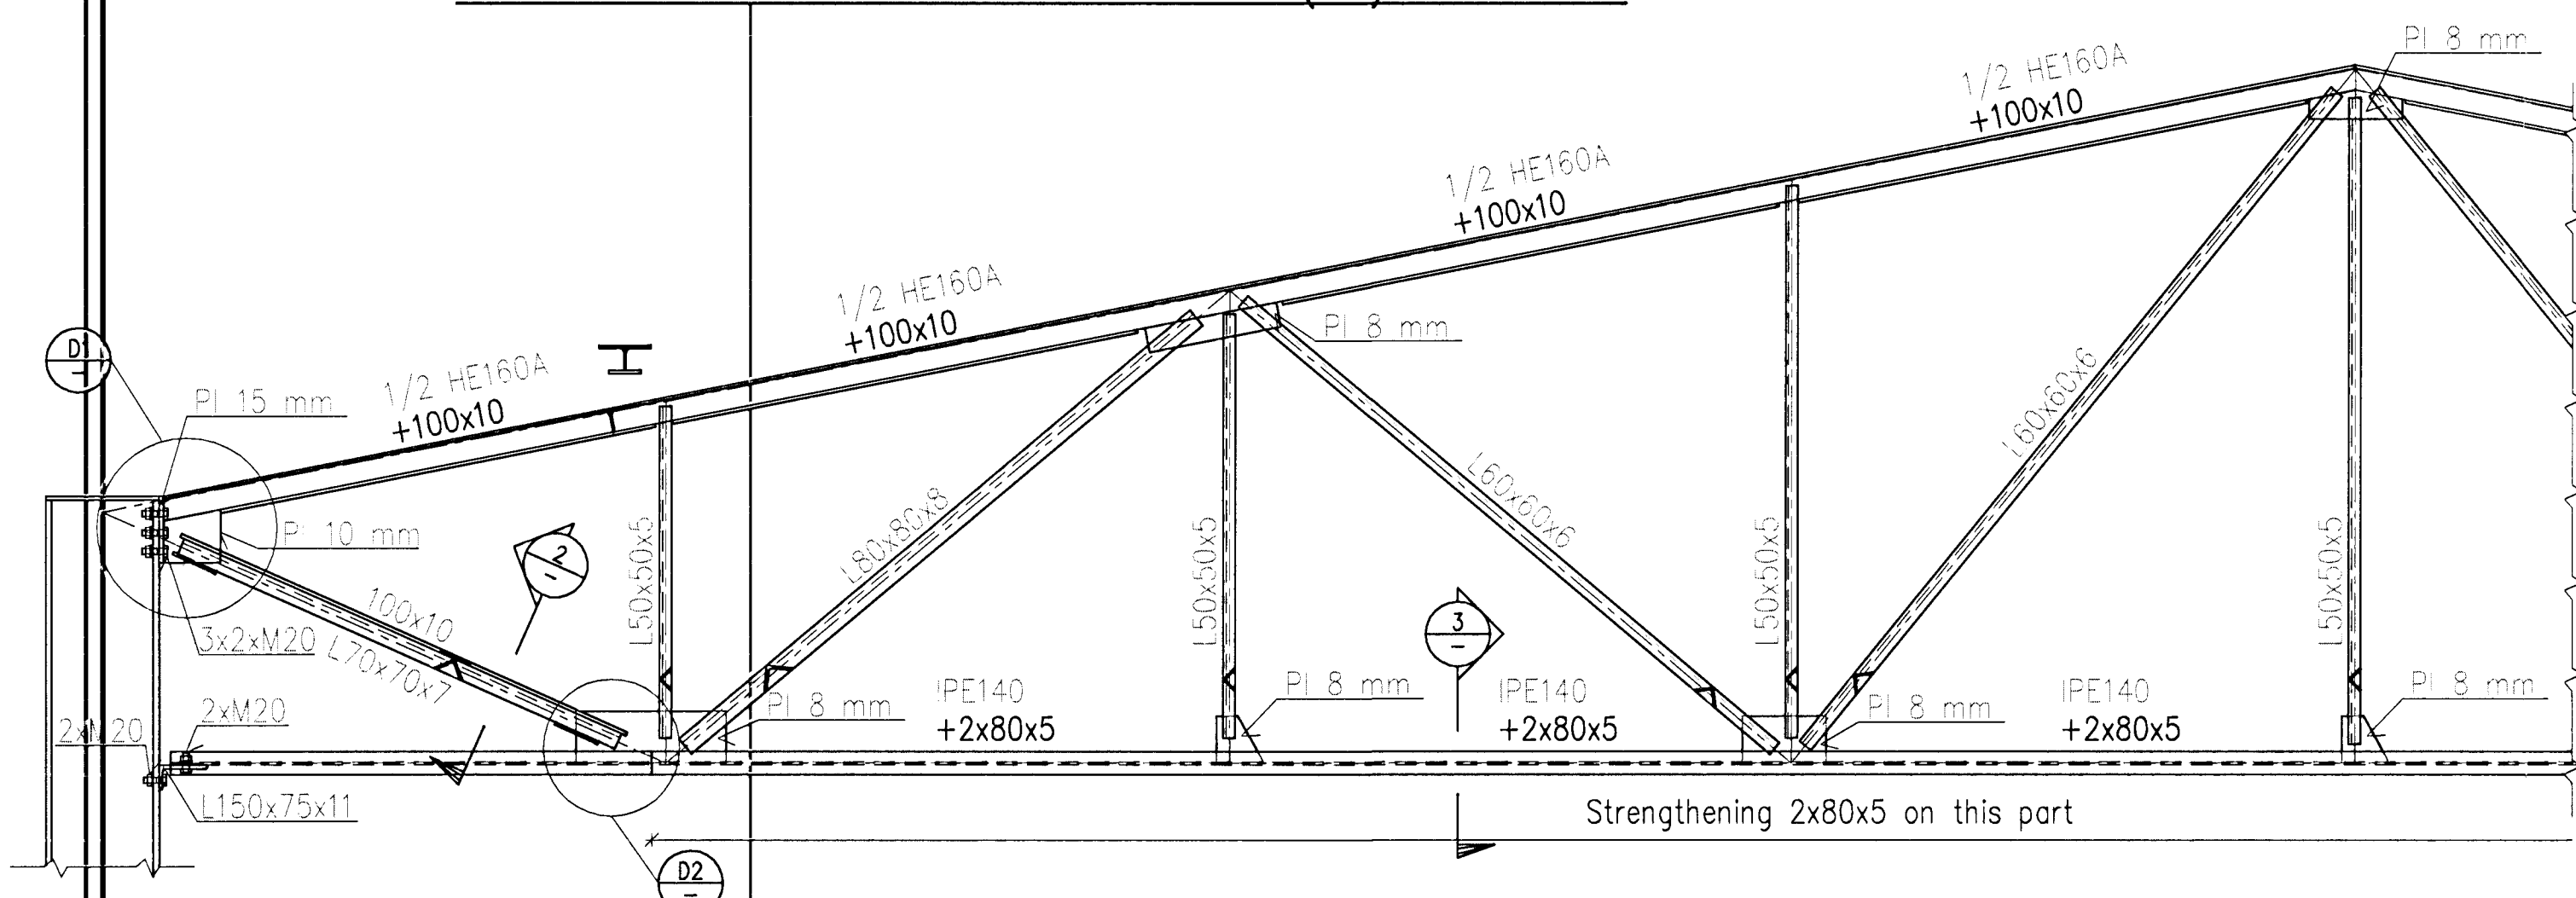


Same strengthening on the other half of the beam and other beams in line K



CONNECTIONS FOR DIAGONALS, 1:2

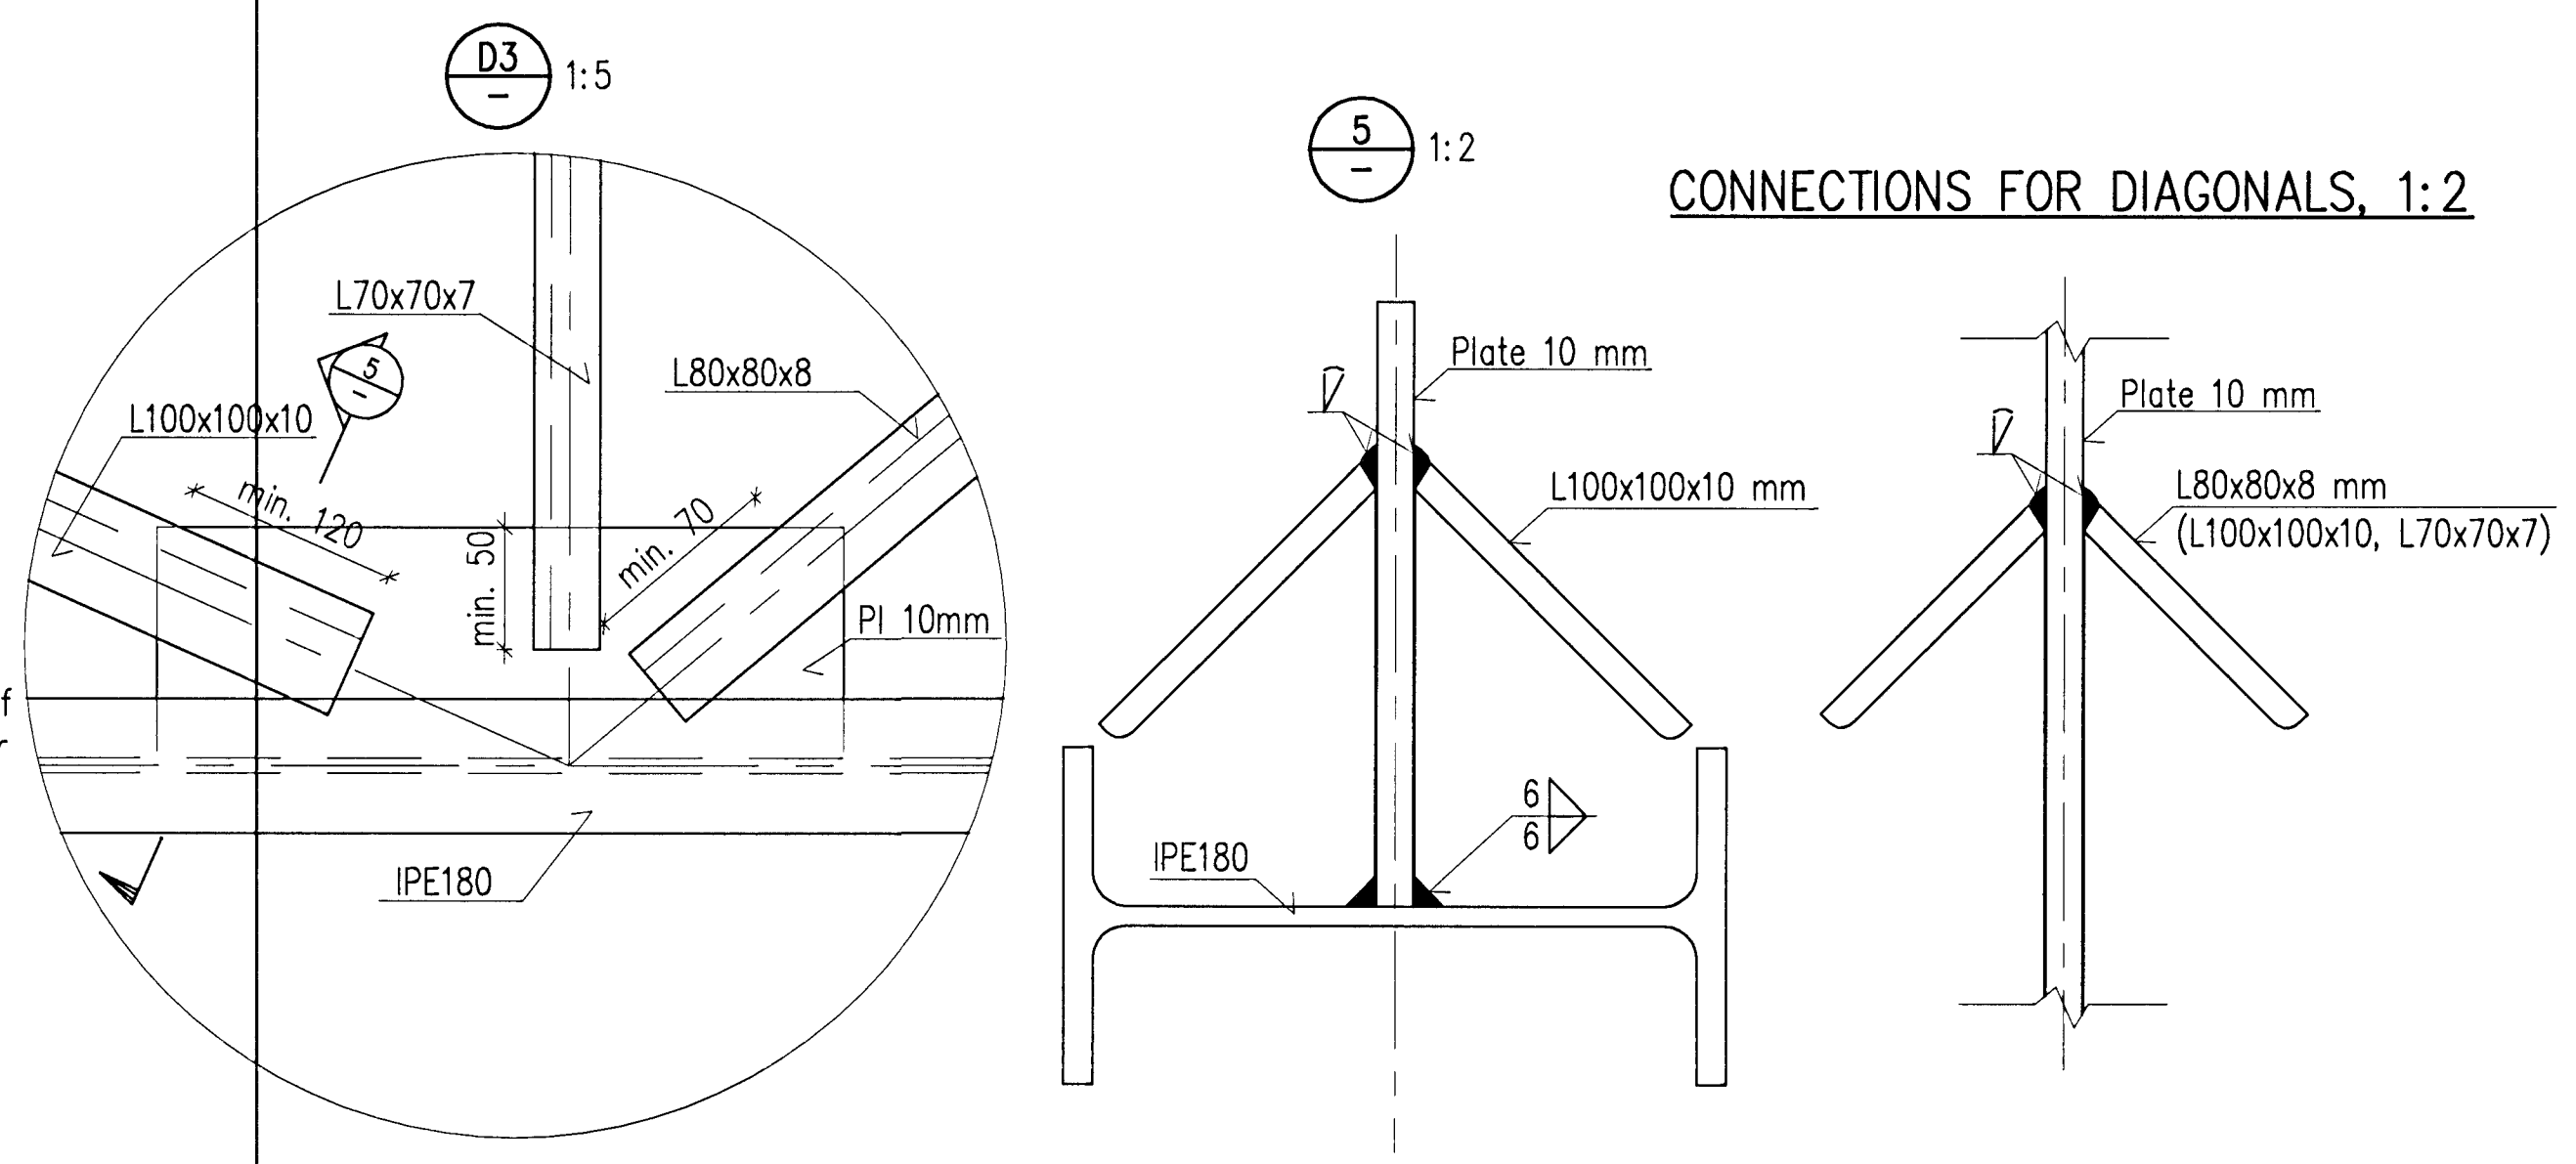

STRENGTHENING OF DIAGONAL, 1:2

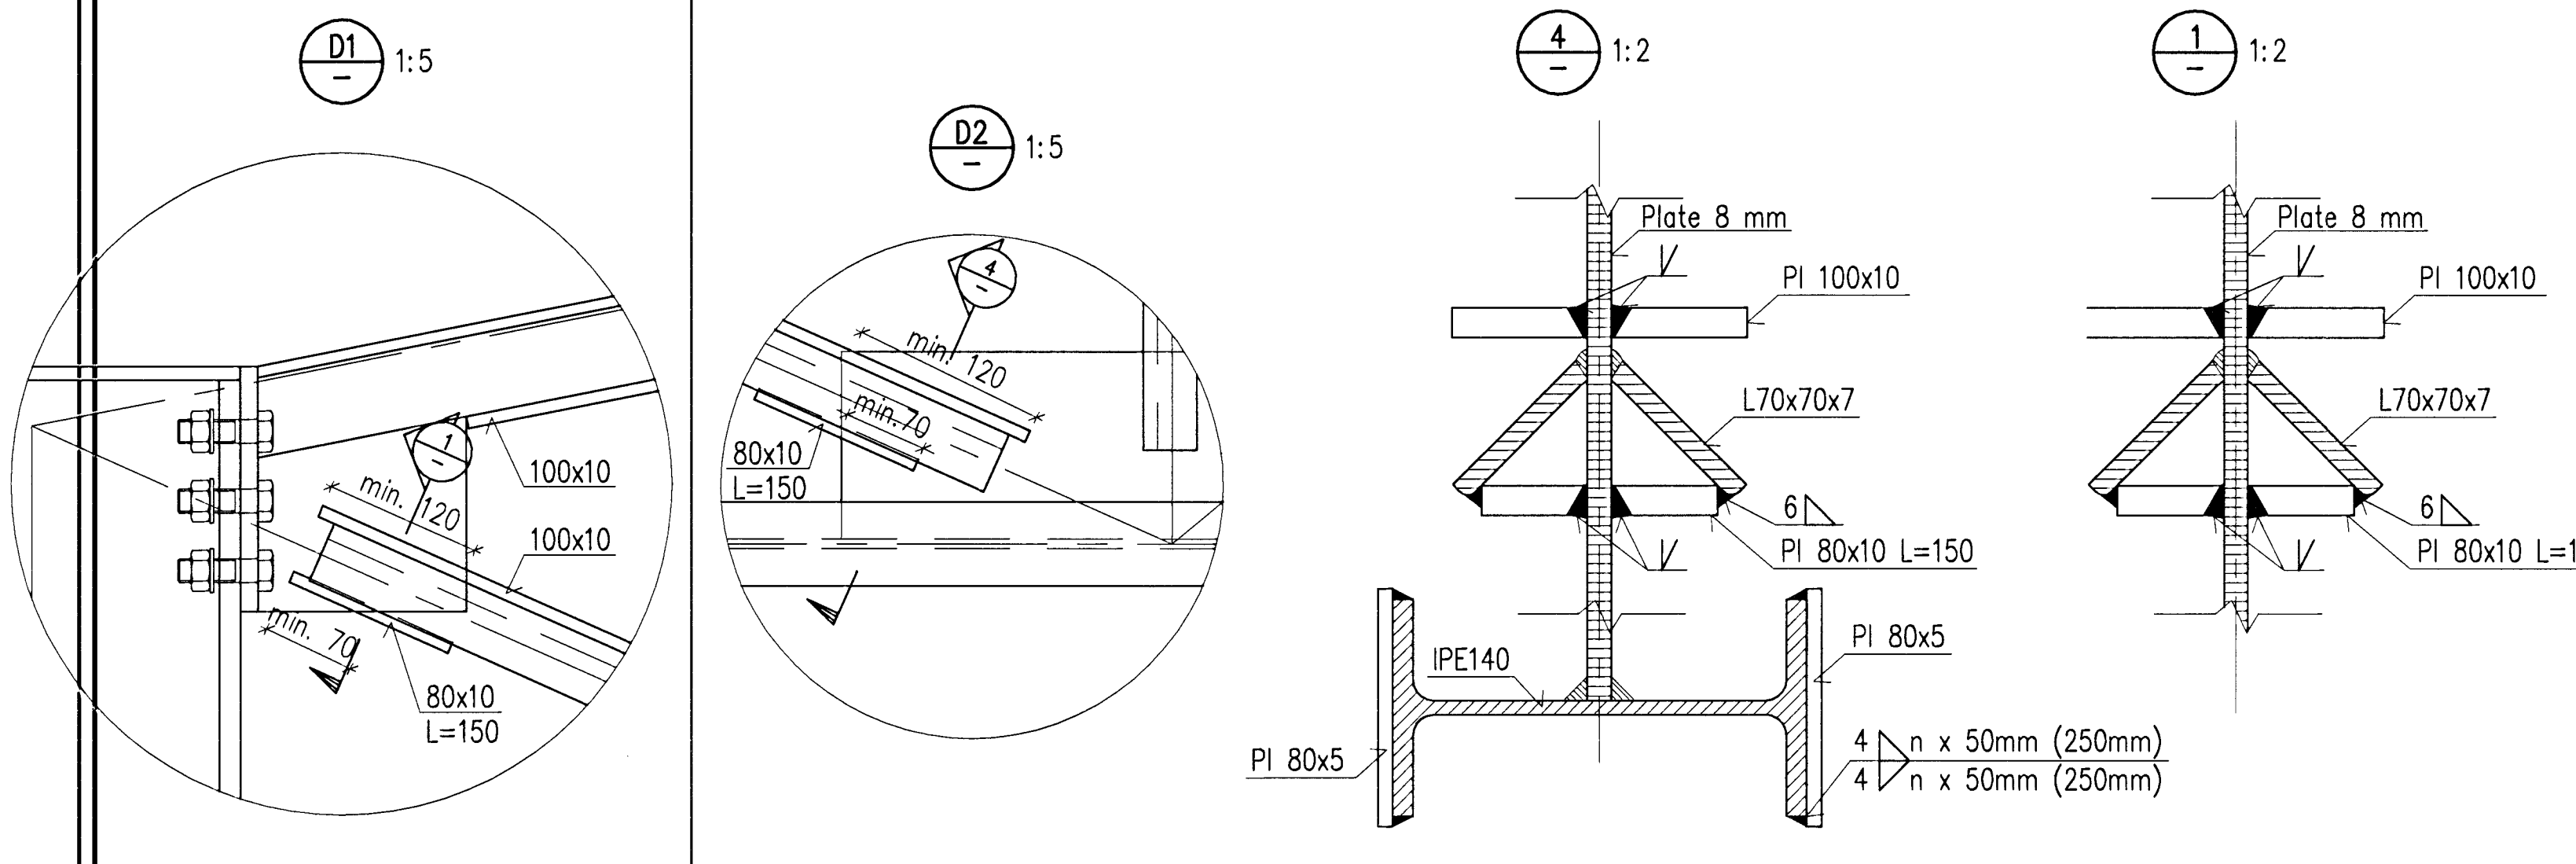

GRIDERS IN LINE L

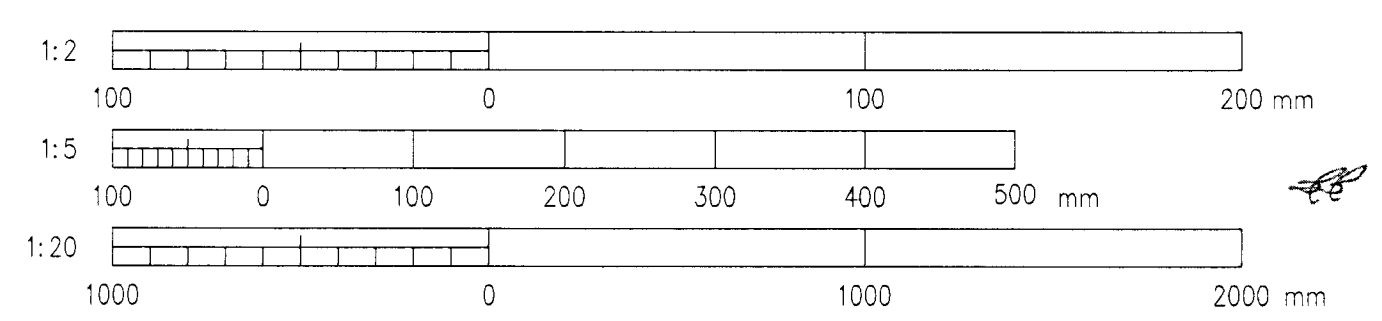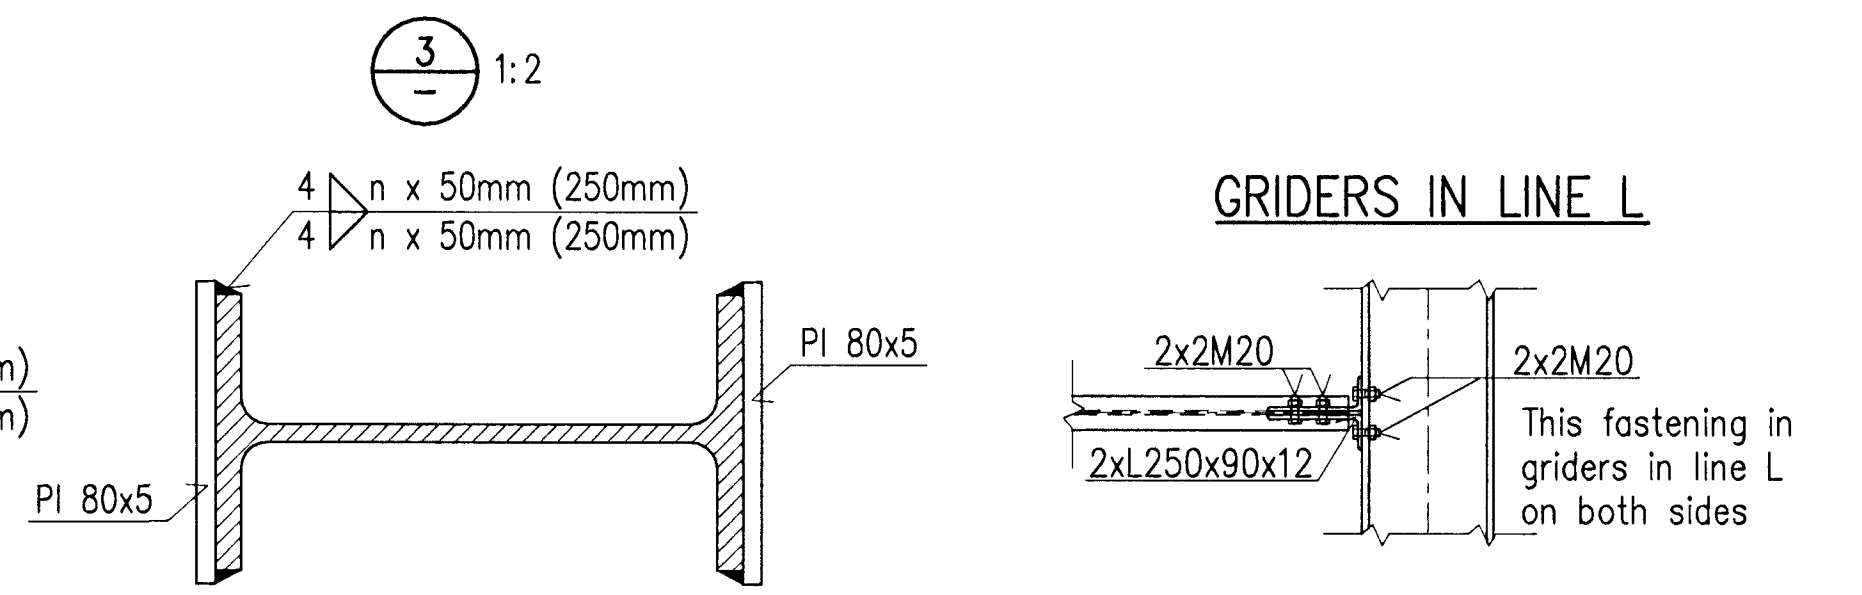

Skýringar Legend:										This drawing is the property of Rio Tinto Alcan Iceland Ltd. and handed out for personal use only. It may neither be copied nor made available to others without permission of Rio Tinto Alcan Iceland Ltd. The receiver is liable for any misuse. Scale: 1:2/5/20 Dimensions without tolerances according to ISO 2768-1 medium.		Dagsetning / Date 2008.10.01	IPU 410 - SUBSTATION 220 kV SWITCHYARD BLD. ROOF BEAMS	Flokkur nr.: 4011	Bláð nr.: 01188	Nesta bl.: 01188
	13	Record Drawing	2012.06.11	HS	NI	KS	KS									
	Útg. nr.	Lýsing	Dagsetning	Hor./Tav. Des./Dwg	Yfir. Old	Notk. hafi. Suppl. Ref	Notk. hafi. ISAL Ref									