COLUMNS, 1:20

C1, 8 pcs.

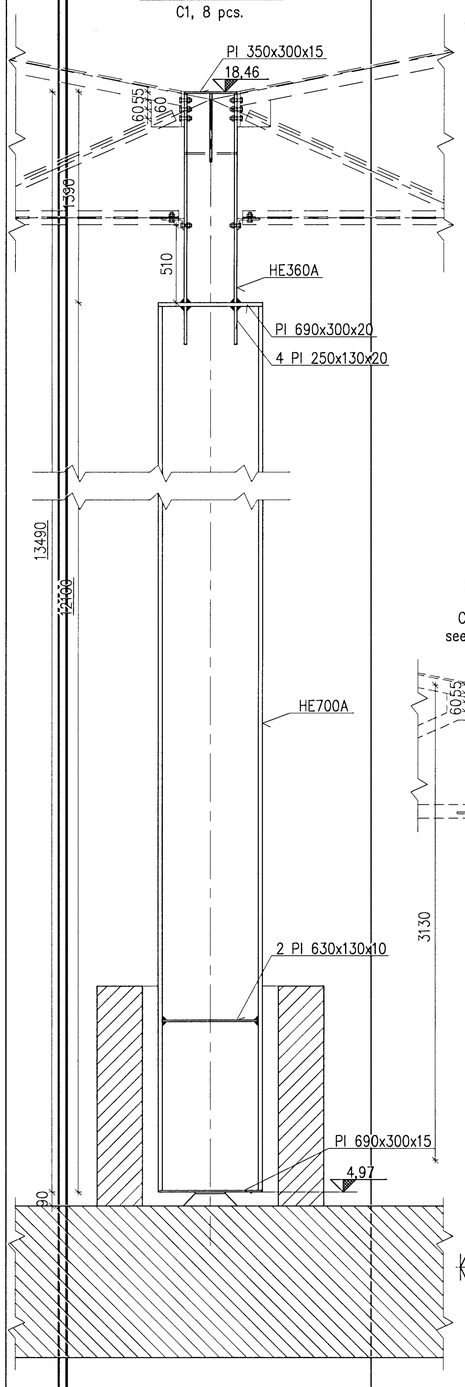

a / – 1:10

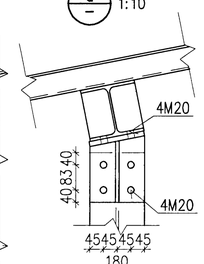

b / – 1:10

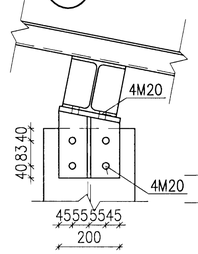

1 / 063 1:20

C6, 2 pcs
see drw. 061

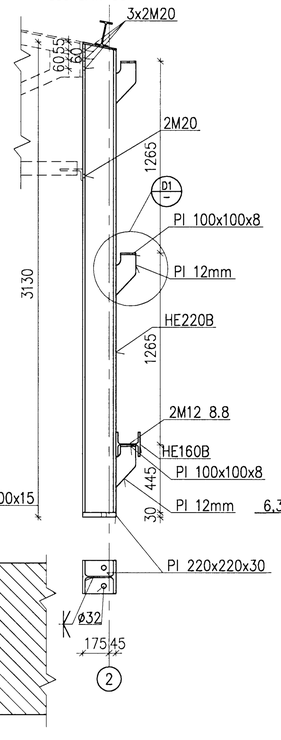

2 / 063 1:20

C4, 8 pcs
see drw. 061

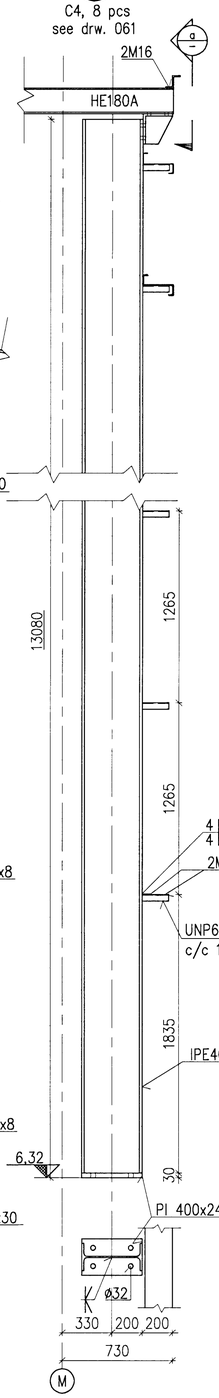

2a / 063 1:20

C4a, 2 pcs
see drw. 061

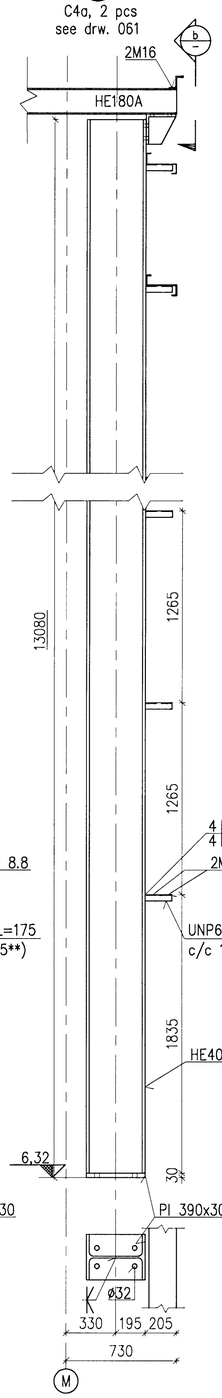

3 / 063 1:20

C5, 5 pcs
see drw. 061

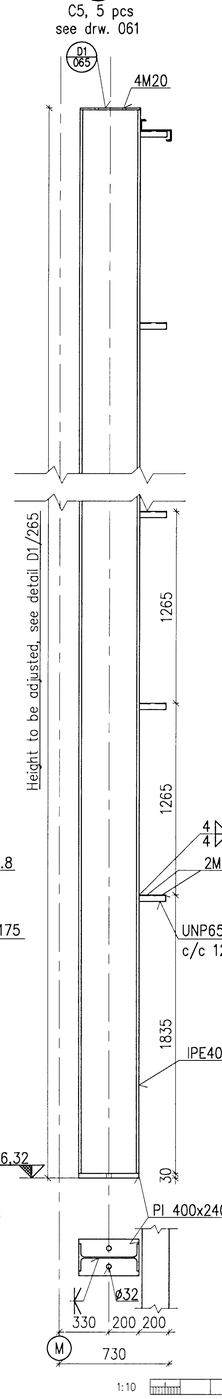

3a / 063 1:20

C5a, 1 pcs
see drw. 061

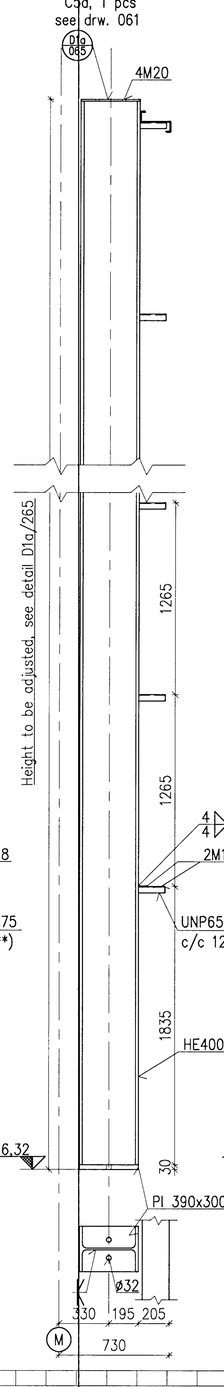

5 / 064 1:20

C2, 11 pcs
see drw. 061

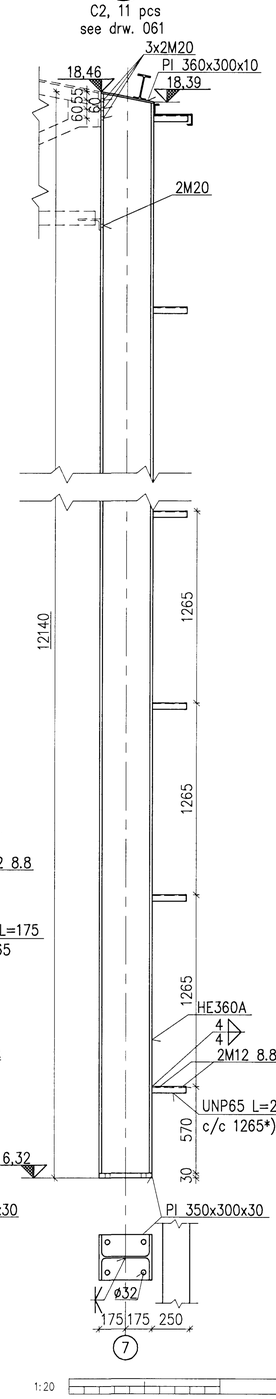

6 / 064 1:20

C3, 1 pcs
see drw. 061

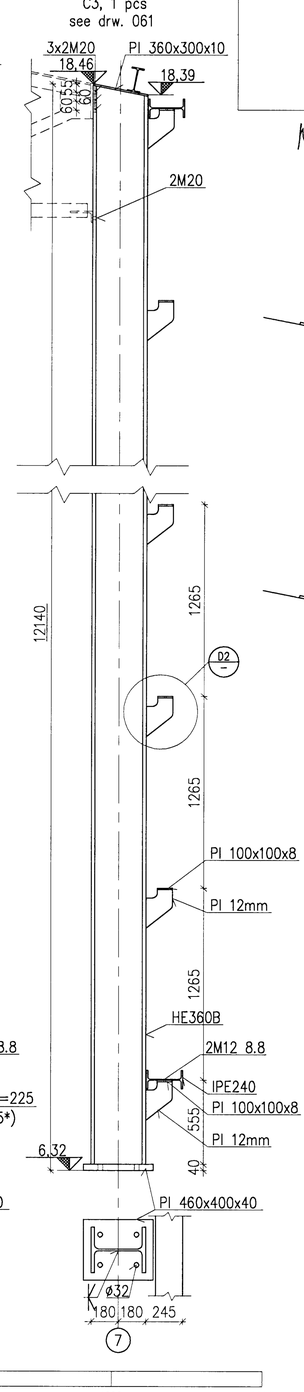

Sampykkt þann
01 OCT 2012
Byggingafulltrúinn í Hafnarfirði
F.h. Sigurður Steinar Jónsson

Nicli Indriðason
Kt. 181144-3949 NI

4 / 064 1:10

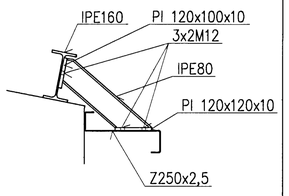

7 / 064 1:10

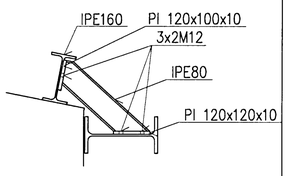

D1 / – 1:10

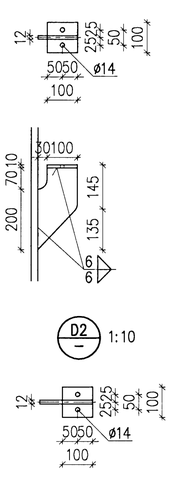

D2 / – 1:10

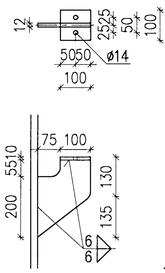

1:10 100 0 200 400 600 800 1000 mm

1:20 1000 0 1000 2000 mm

Skýringar
Legend:

***) COLUMNS C2, COMMENTS**

Column in K7 is with fastenings on both sides, one as shown for C2 the other as shown for C3, see drawing 068.

Column in M7 is with fastenings as shown for C3.

****) COLUMNS C4, COMMENTS**

2 columns in wall A are with fastenings as other columns in wall A.

*****) COLUMNS C5, COMMENTS**

Column in A7 is with fastening as other columns in wall A.
Column top in M7 is fastened to purlin same way as C4.

C:\IDP\01 IDP\400 – Reduction\410 Substation\Drawings\Civil\IDP-410-ZA-015-066.dwg

Útg.nr Rev no	Lýsing Description	Dagsetning Date	Han/Tkn Des/Drw	Yfirf Chkd	Notk.heim Suppl Ref	Notk.heim ISAL Ref
13	Record Drawing	2012.06.11	HS	NI		

This drawing is the property of Rio Tinto Alcan Iceland Ltd. and handed out for personal use only. It may neither be copied nor made available to others without permission of Rio Tinto Alcan Iceland Ltd. The receiver is liable for any misuse.

Stærð/Format: A1 Mkv./Scale: 1:10, 1:20

Dimensions without tolerances according to ISO 2768-1 medium.

HRV & HATCH JOINT VENTURE ISAL PRODUCTION UPGRADE

Dagsetning / Date	2008.10.01
Hannað / Designed	HS/LDB
Teikn / Drawn	HS/LDB
Verktaki / Supplier	HRV
Teikn.nr.verktaka / Supplier drw.no.	IDP-410-ZA-015-066
Samþ.Akt / Approved	NI
Yfirf / Chkd	NI
Hluti af: / Part of:	

IPU 410 – SUBSTATION
220 kV SWITCHYARD BLD.
COLUMNS

Teg.teikningar / Dwg. type: STRUCTURAL STRUCTURAL STEEL

Rio Tinto Alcan — ISAL Alcan Iceland Ltd Straumsvík IS-222 Hafnarfjordur Iceland

ISAL Yfirfarið og skráð, dags / ISAL Checked, date

ISAL Samþykkt, dags / ISAL Approved, date

Flokkur nr.:	Blað nr.:	Næsta blnr.:
Kostn.nr.-Ccno. / BGn.nr.-Eq.no		
4011	01188	
AKS		
UB01		
Teikn.nr. ISAL /Drw.no. of ISAL		Breyt./Rev.
251337		A