
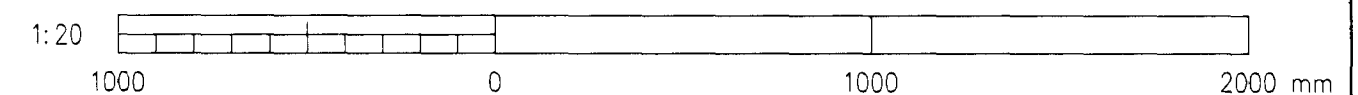


Samþykkt þann
 01 OCT 2012
 Byggingafráttirinn / Högskólinn
 F.n. Sigurður Steinar Jónsson

Níels Indriðason
 Kt. 181144-3949

A SECTION, 1:20
 046

B SECTION, 1:20
 046

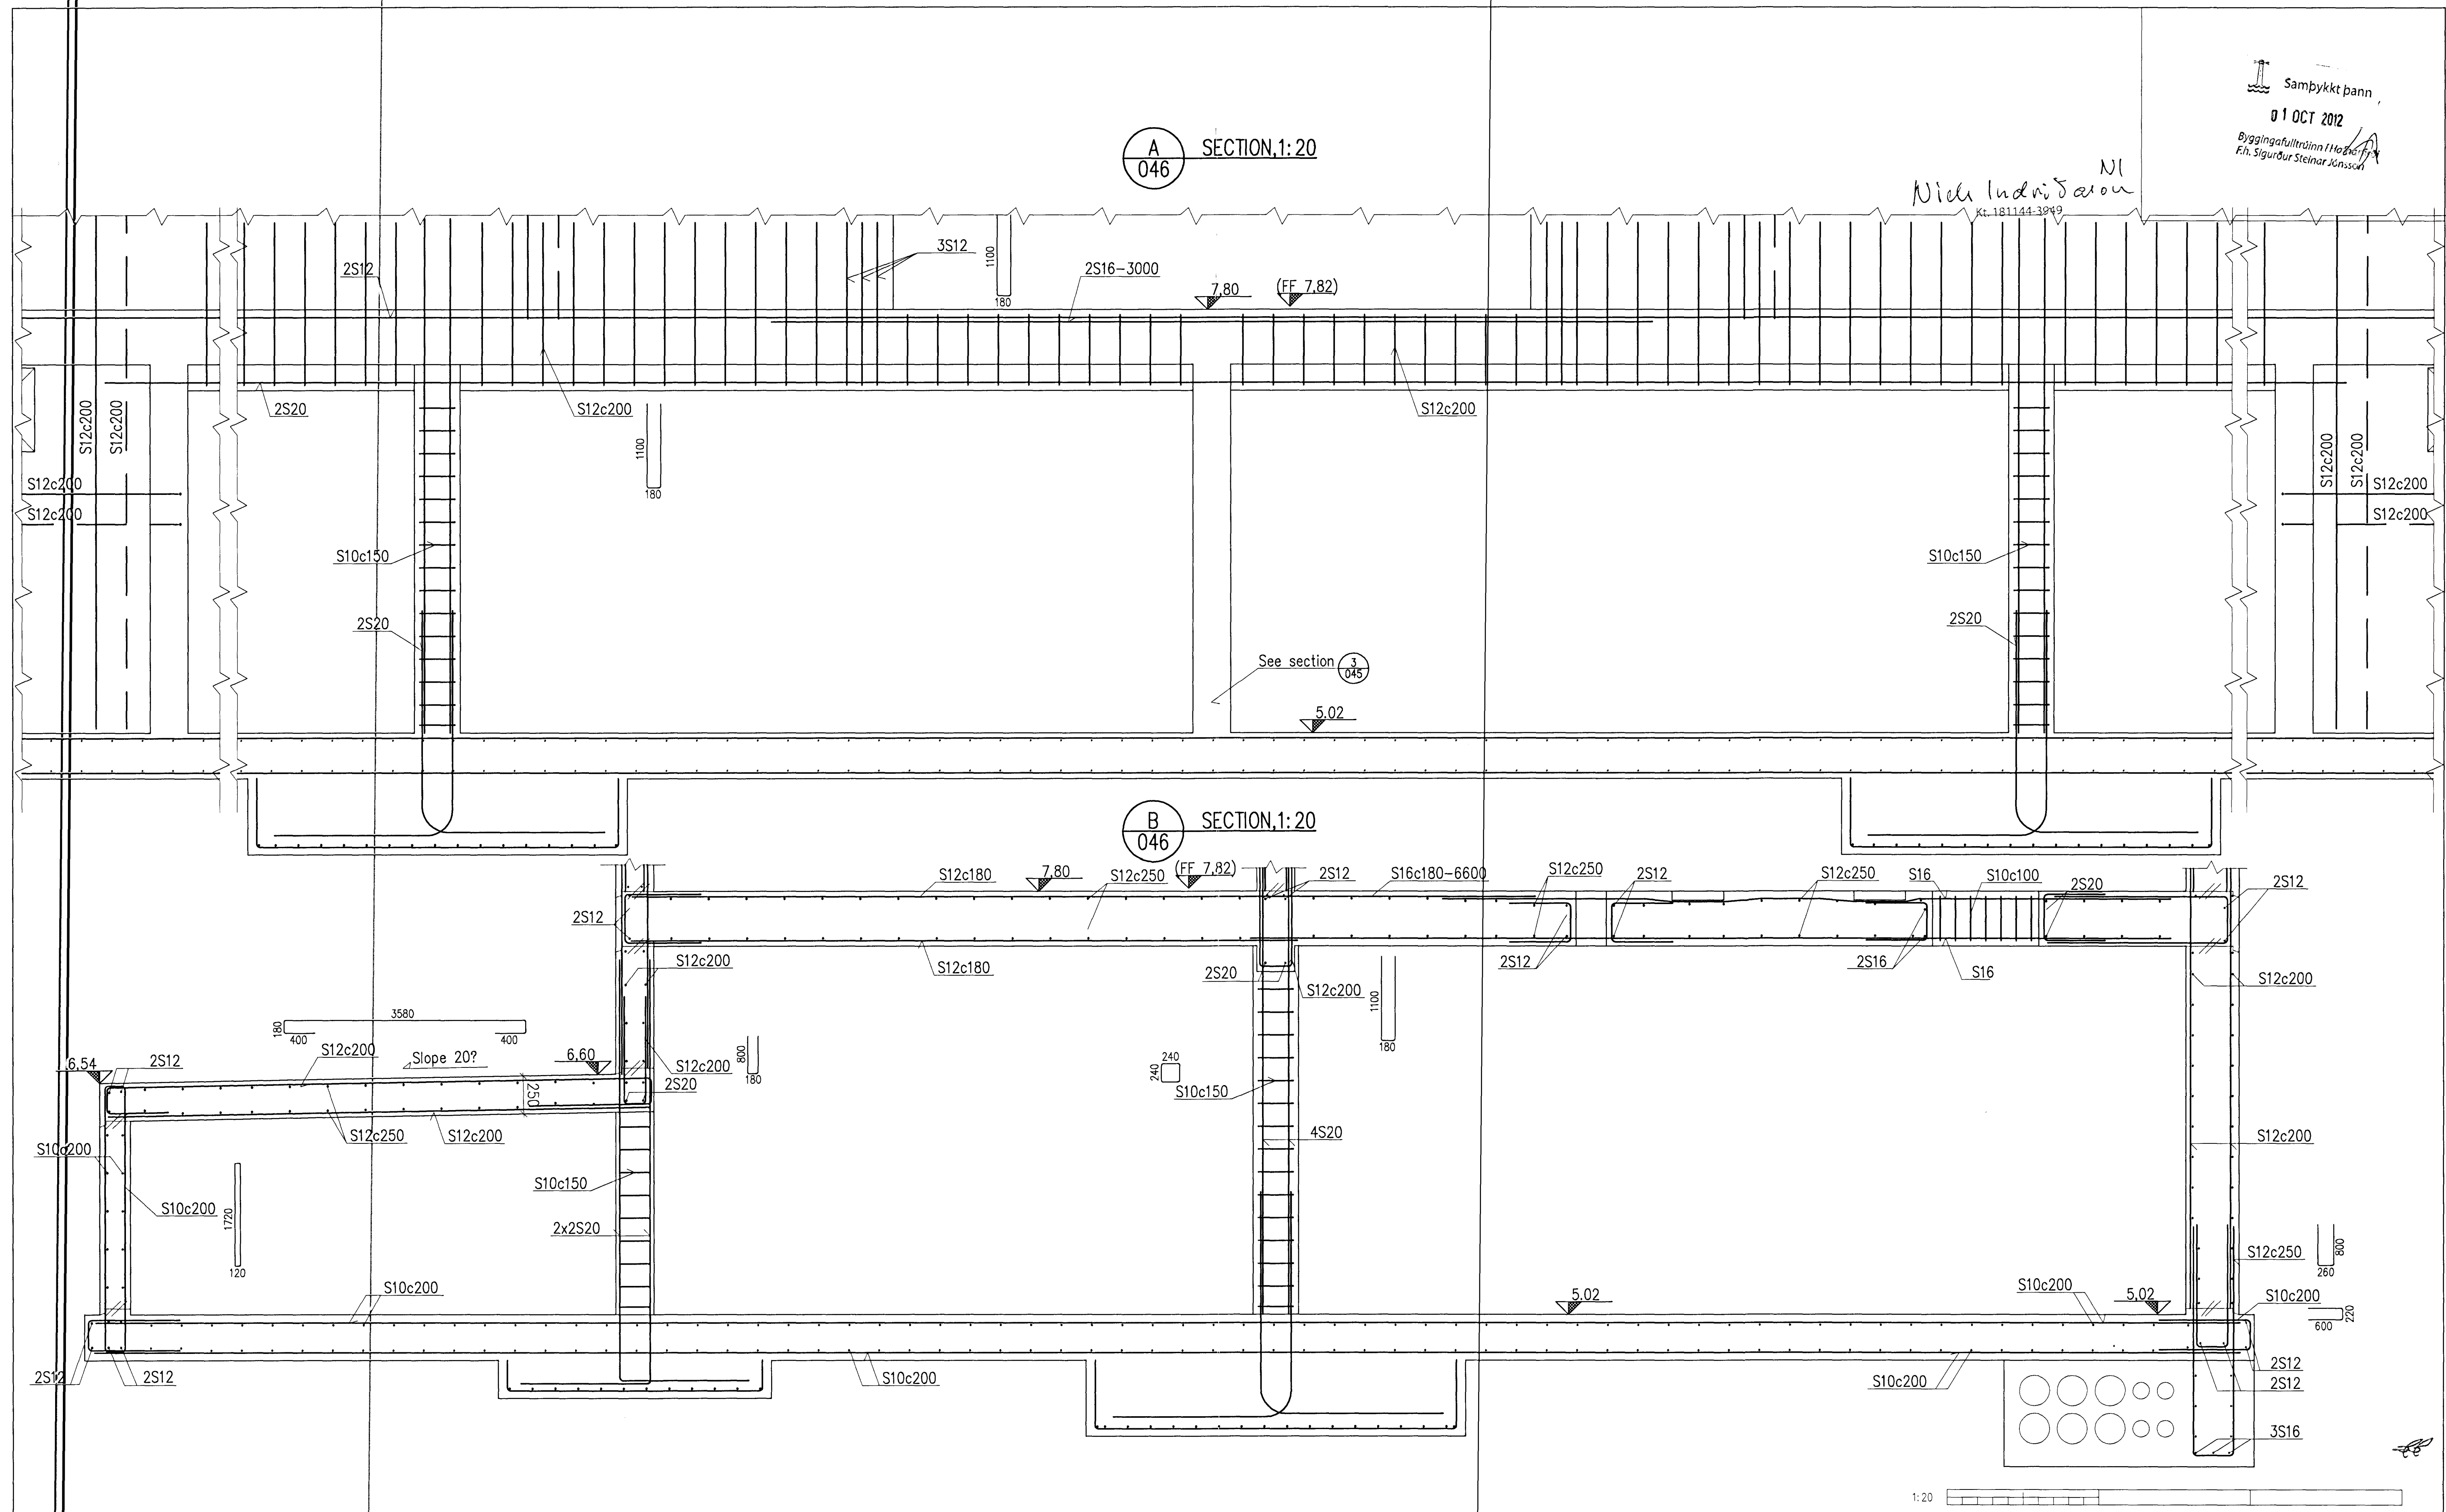

Skýringar:
 Legend

15	Record Drawing	Lýsing	2012.06.11	HS	NI	AS	MS
Fig. nr.	Rev. no.	Description	Dagsetning / Date	Hor./Tm. / Des./Dra	Yst. / Old	Notk. heim. / Suppl. Ref.	Notk. heim. / ISAL Ref.

This drawing is the property of Rio Tinto Alcan Iceland Ltd. and handed out for personal use only. It may neither be copied nor made available to others without permission of Rio Tinto Alcan Iceland Ltd. The receiver is liable for any misuse.	
Stærð: A1	Mkv.: 1:20
Förmiðg.: 1	Skala:
Dimensions without tolerances according to ISO 2768-1 medium.	

This drawing is the property of Rio Tinto Alcan Iceland Ltd. and handed out for personal use only. It may neither be copied nor made available to others without permission of Rio Tinto Alcan Iceland Ltd. The receiver is liable for any misuse.	
Dagsetning / Date	2008.10.01
Riðnað / Designed	HS
Tekni / Drawn	ÁFV
Tvektali / Supplier	HRV
Tekni nr. vorklaka / Supplier's drw. no.	IDP-410-CA-015-049
Samþykkt / Approved	Yst / Chkd
Hluti af / Part of:	NI

IPU 410 - SUBSTATION 60 kV SWITCHGEAR BLD. SECTIONS A AND B		Flokkur nr.:	Bláð nr.:	Næsta bl. nr.:
REINFORCEMENT		Kostn. nr. - Ccna. / Bón. nr. - Egn.	4011	01188
Rio Tinto Alcan		AKS	UB01	ISAL
ISAL Yfirráð og séráð. dags. / ISAL Checked, date		ISAL Tekni nr. / Drw. no. of ISAL	251226	Breyt./Rev. A