
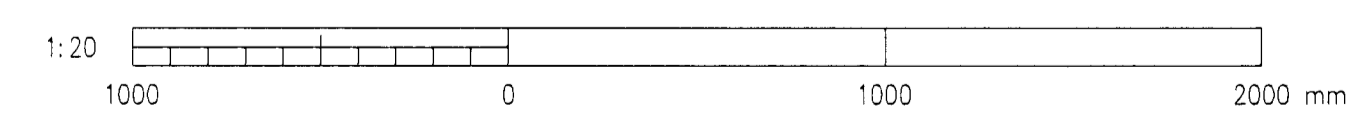
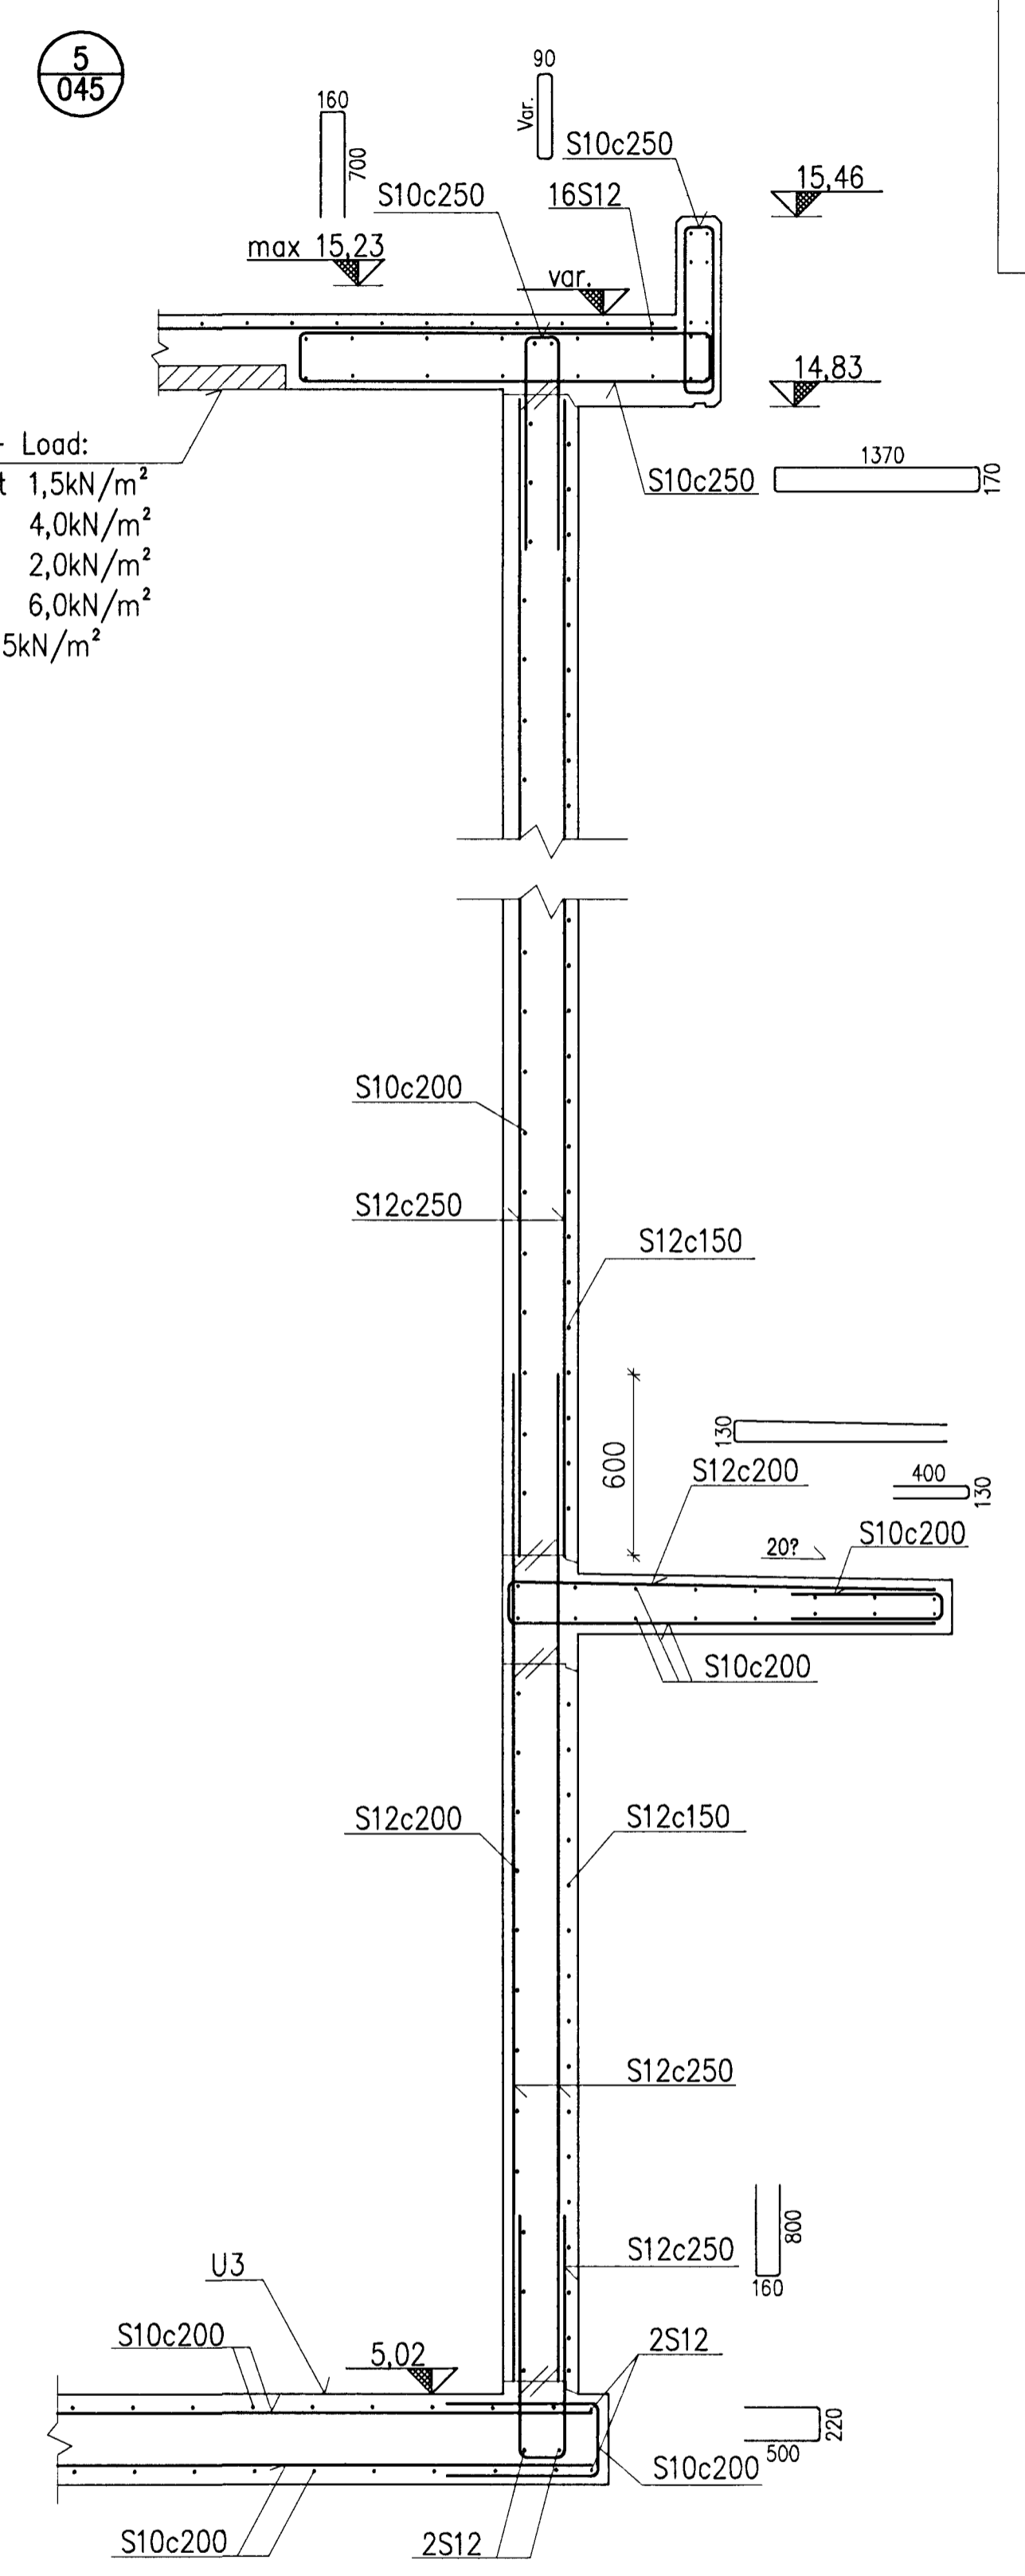
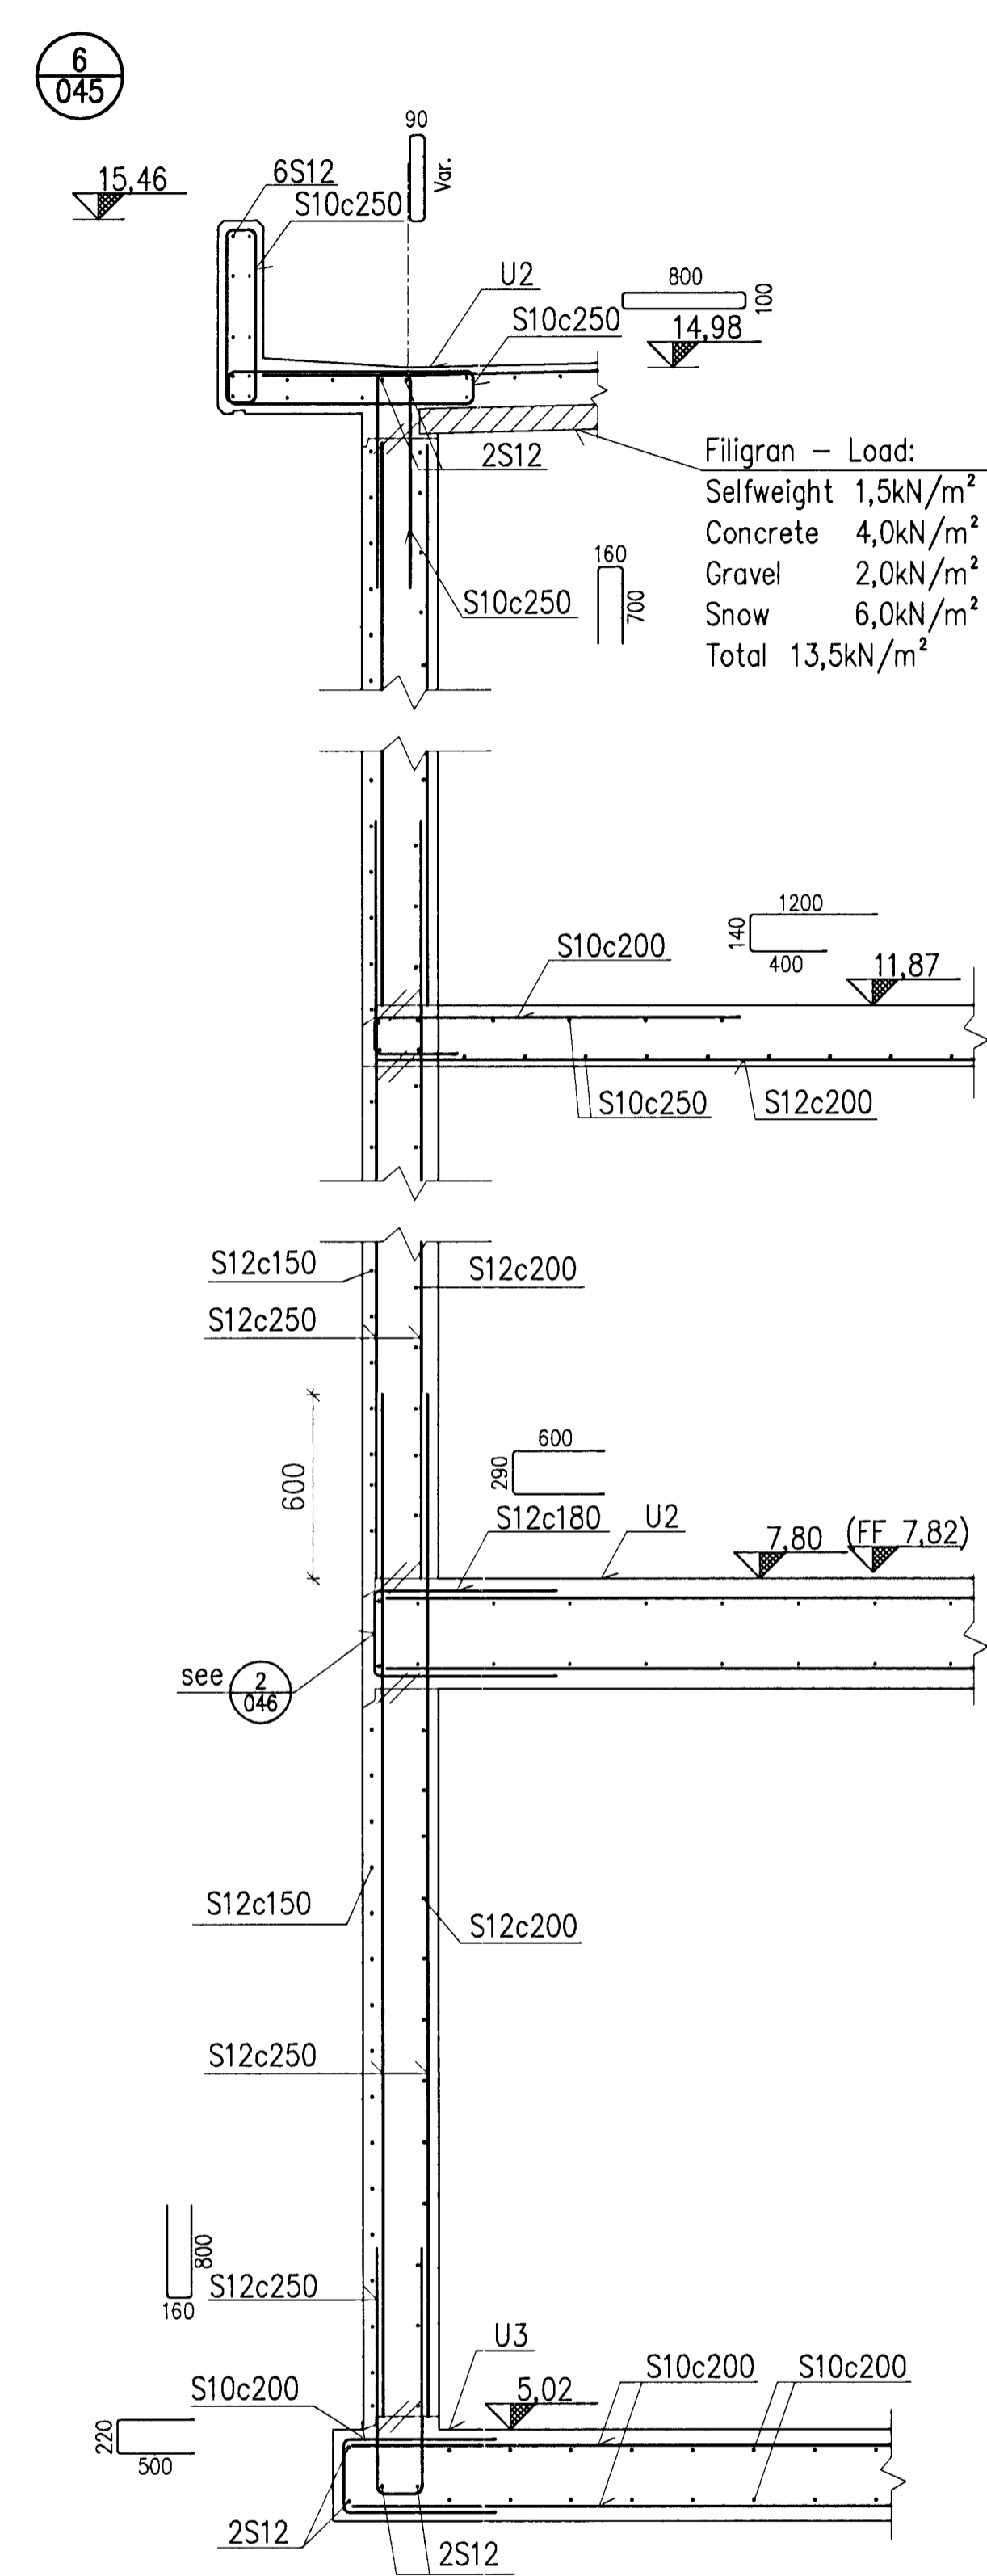


Nick Indriðason
 Kt. 181144-3949
 NI

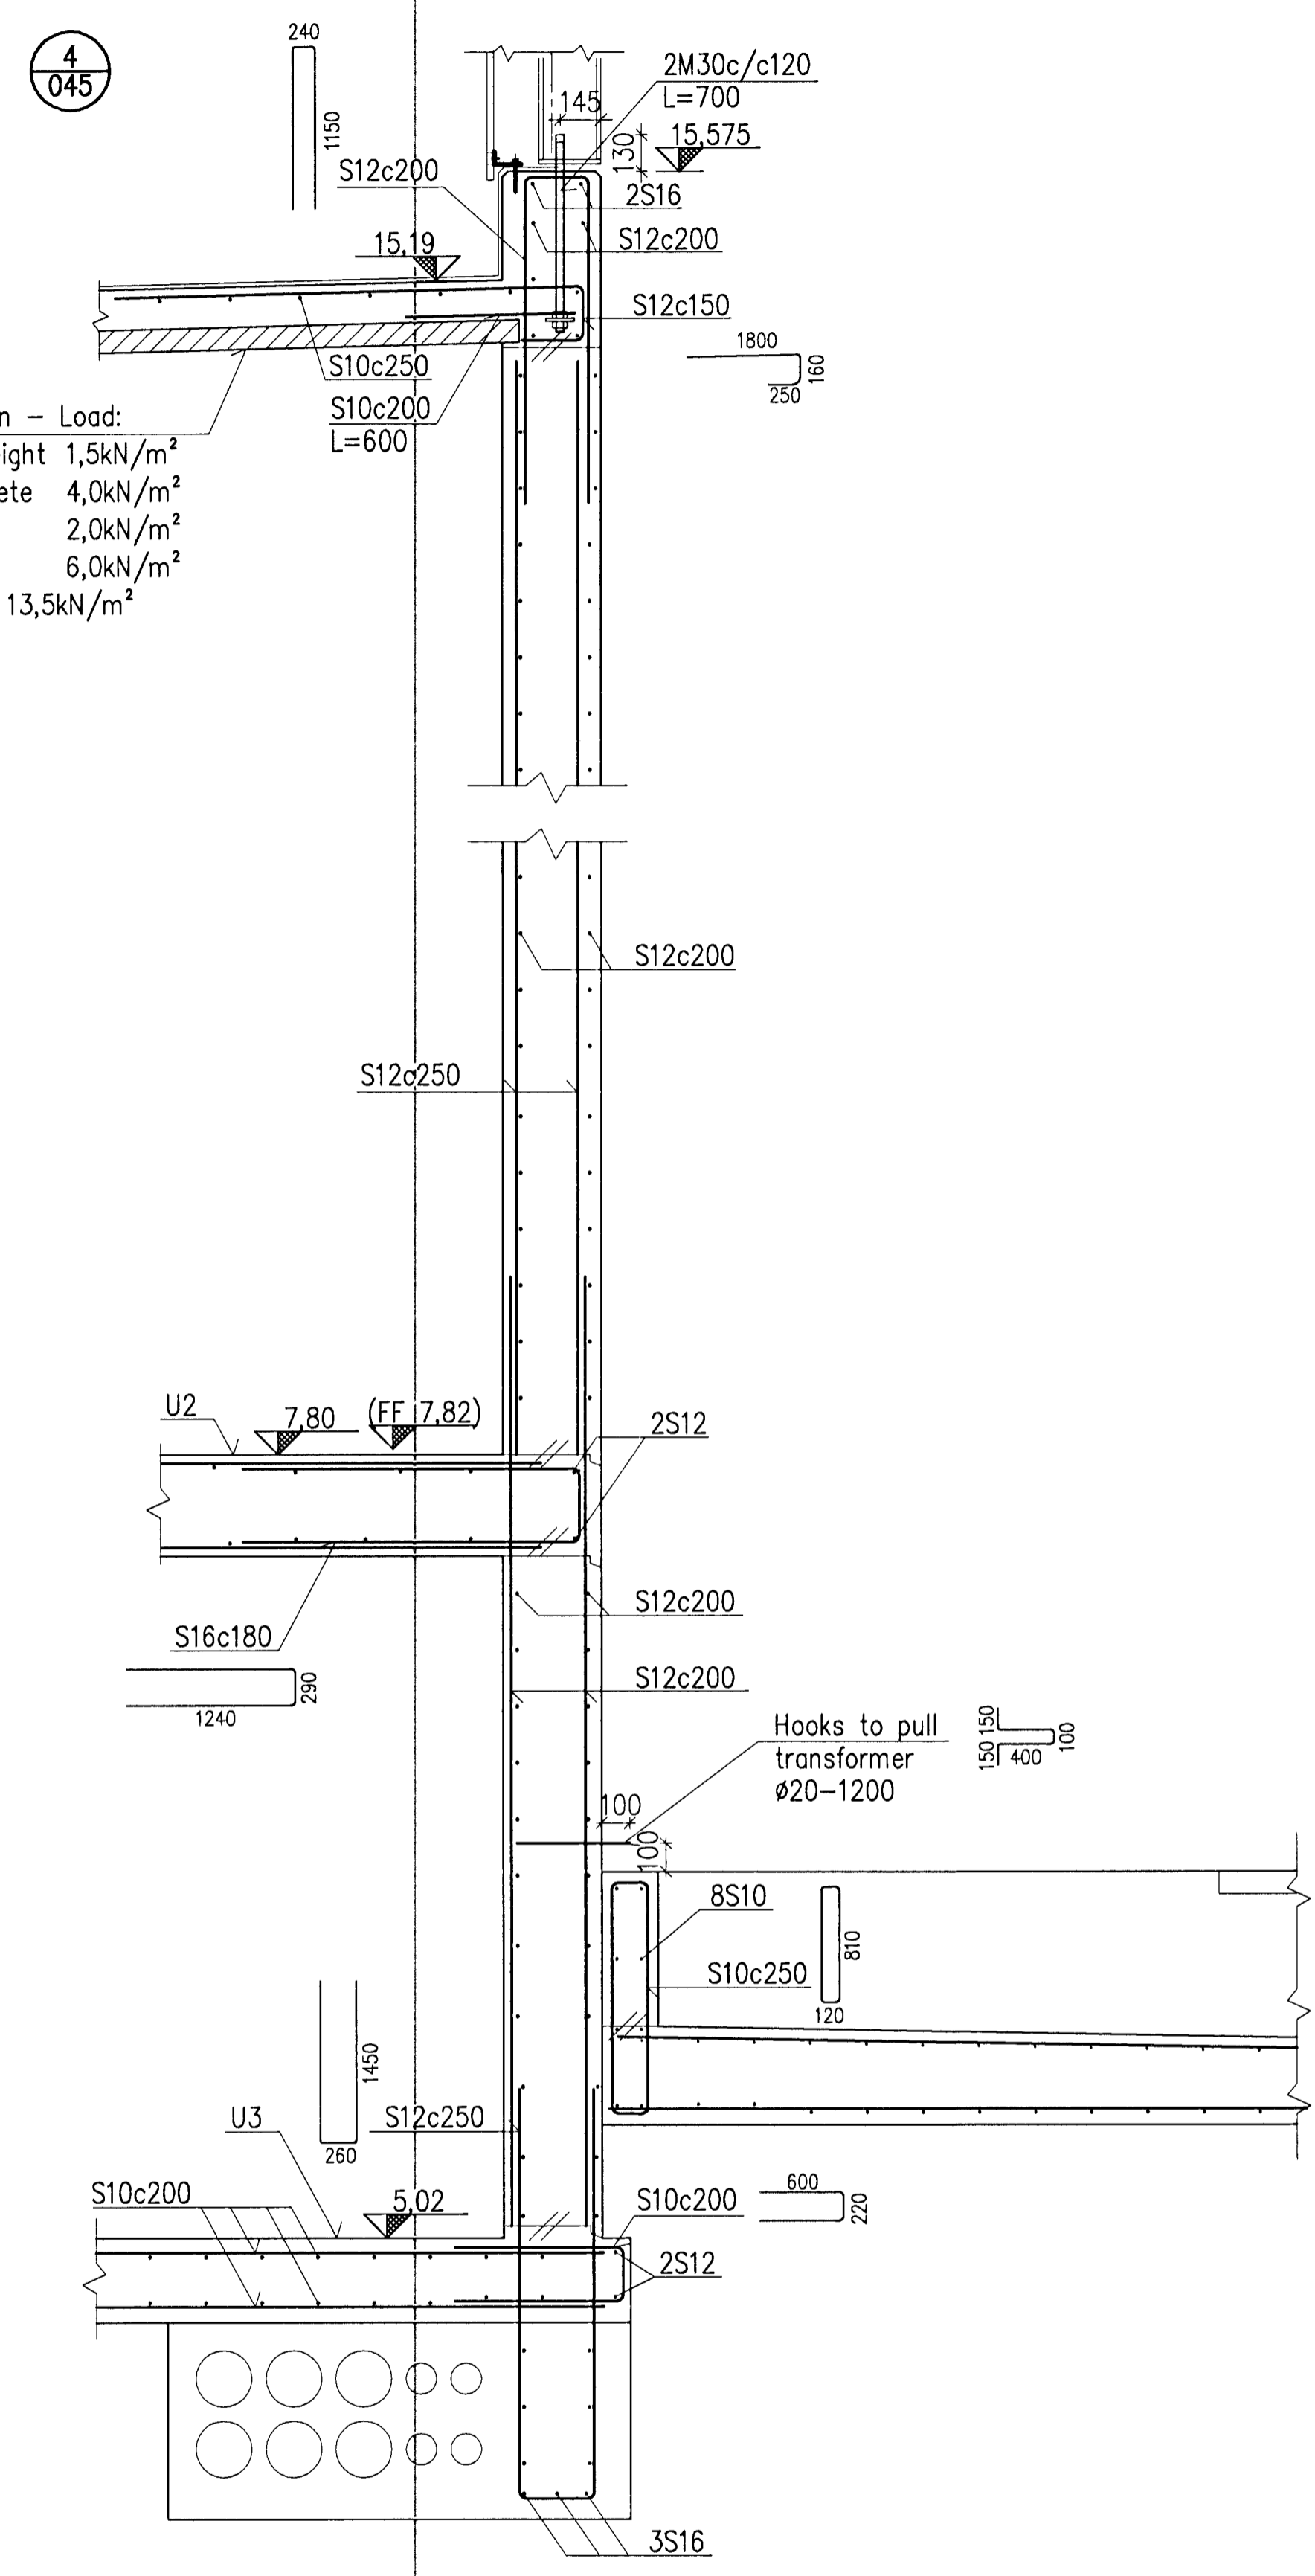

Skýringar:
 Legend:

15	Record Drawing	2012.06.11	HS	NI	AKJ	AKS
Útg nr	Lýsing	Dagsetning	Han/Ún	Yfirt	Notk heim	Notk heim
Rev no	Description	Date	Des/Drw	Old	Suppl Rel	ISAL Rel

This drawing is the property of Rio Tinto Alcan Iceland Ltd. and handed out for personal use only. It may neither be copied nor made available to others without permission of Rio Tinto Alcan Iceland Ltd. The receiver is liable for any misuse.						
Format:	A1	Mkv:	1:20	Dimensions without tolerances according to ISO 2768-1 medium.		
Scale:	1:20					

Dagsetning / Date		2008.10.01	
Hannað / Designed	Teikn / Drawn	AFV	
Verktaki / Supplier	HRV	HRV	
Tækn.nr.verktaka / Supplier drwn.no.		IDP-410-CA-015-048	
Samm.Ákt / Approved	Yfirt / Chkd	NI	
Hluti af: / Part of:			

IPU 410 - SUBSTATION 60kV SWITCHGEAR BLD. WALLS, SECTION			Flokkur nr.: / Blað nr.:	Næsta blinn.:
			Kostn.nr.-Cno. / Búnr.-Eq.no	4011 01188
Tag.tekningar / Dwg type:			REINFORCEMENT	
ISAL			Tækn.nr. ISAL / Drwn.no. of ISAL	Breyt./Rev.:
Rio Tinto Alcan			251225	A
ISAL Yfirlit og skráð, dags / ISAL Checked, date				
ISAL Sambýkt, dags / ISAL Approval, date				