Samþykkt þann
01 OCT 2012
Byggingafulltrúinn í Hafnarfirði
F.h. Sigurður Steinar Jónsson

Kt. 181144-3949

PLAN VIEW

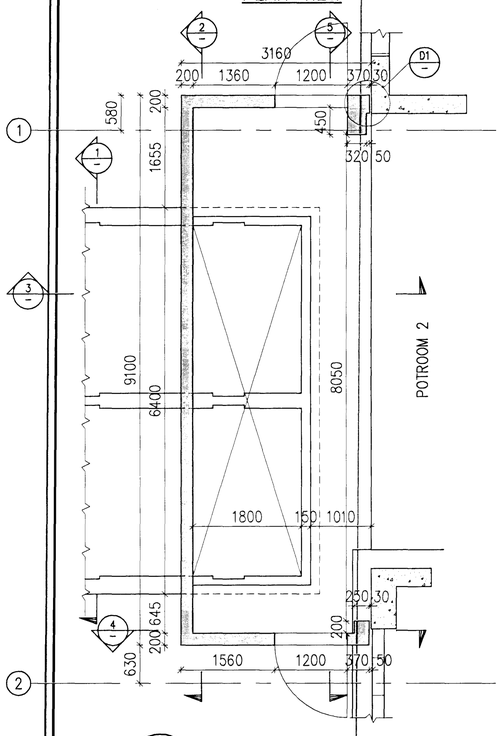

1 SECTION

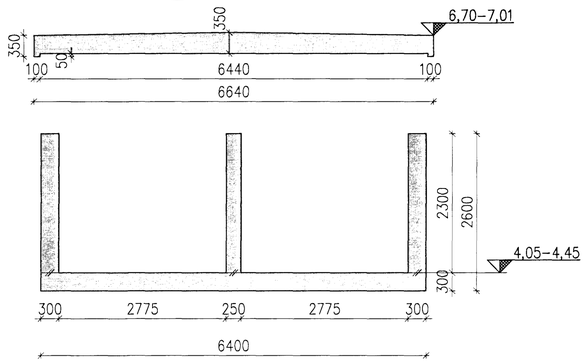

2 SECTION

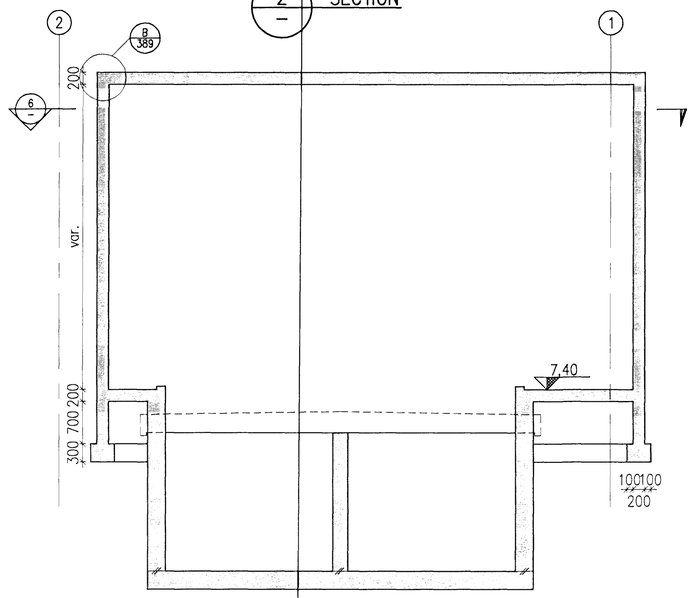

D1 1:10

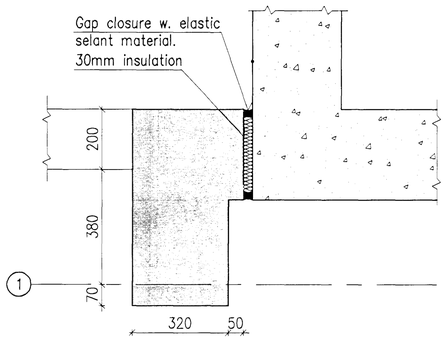

7 1:10

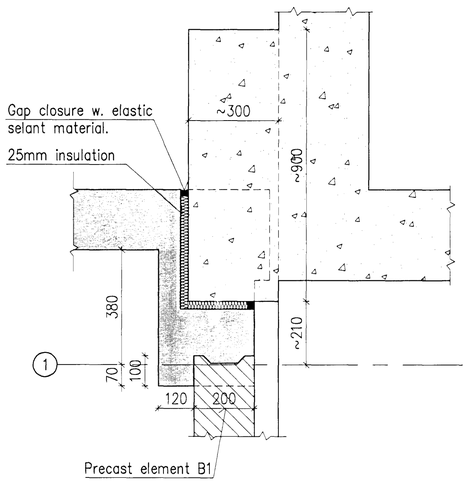

3 SECTION

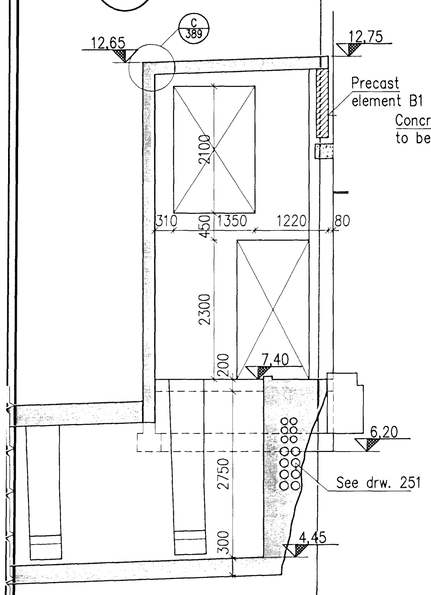

4 SECTION

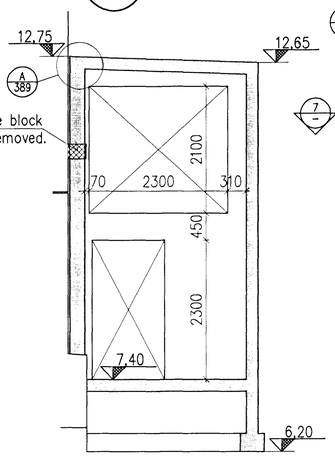

5 SECTION

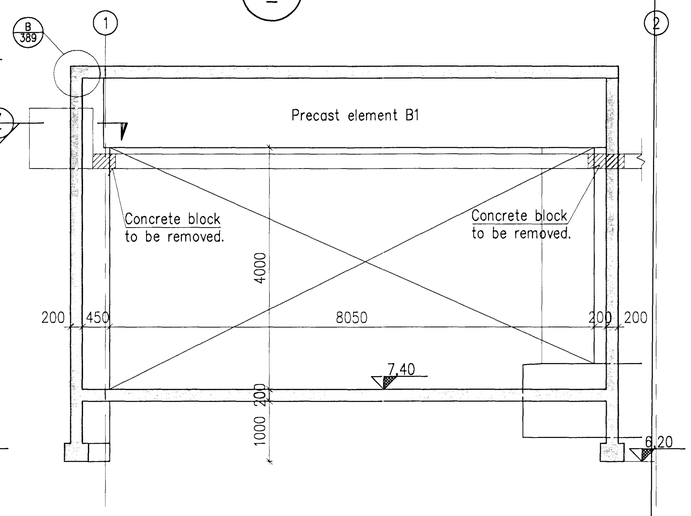

6 SECTION

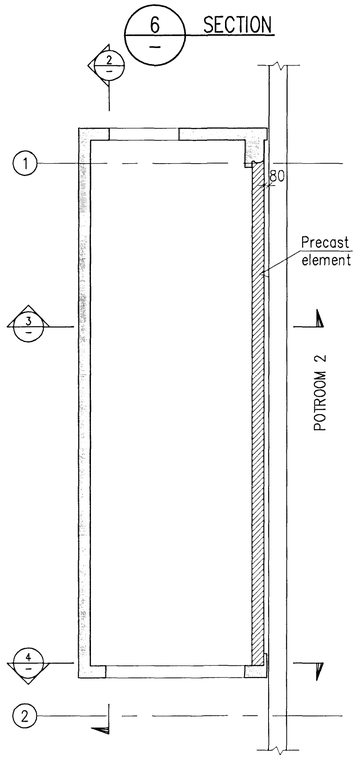

1:10
500 0 500mm
1:50
2500 0 2500mm

Skýringar
Legend:

Concrete: C30/37: XF3-32

Precast elements are shown on drw. IDP-410-CA-015-388

C:\IDP\01 IDP\400 – Reduction\410 Substation\Drawings\Civil\IDP-410-CA-015-371.Dwg

Útg.nr Rev.no	Lýsing Description	Dagsetning Date	Han/Tkn Des/Drw	Yfirf Chd	Nótk.heim Suppl Rel	Nótk.heim ISAL Rel
13	Record drawing	2012.09.12	HS	NI	ÁG	KSS

This drawing is the property of Rio Tinto Alcan Iceland Ltd. and handed out for personal use only. It may neither be copied nor made available to others without permission of Rio Tinto Alcan Iceland Ltd. The receiver is liable for any misuse.

Stærð: A1 Format: Mkv.: Scale: 1:10/1:50
Dimensions without tolerances according to ISO 2768-1 medium.

HRV & HATCH JOINT VENTURE
ISAL PRODUCTION UPGRADE

Dagsetning / Date	2011.02.21
Hannað / Designed	HS
Teikn / Drawn	LDB
Verktaki / Supplier	HRV
Teikn.nr.verktaka / Supplier drw.no.	IDP-410-CA-015-371
Samþykkt / Approved	NI
Yfirf / Chkd	NI
Hluti af: / Part of:	

IPU 410 – RECTIFIER BUILDINGS
INTAKE BUILDING PL 2
PLAN VIEW AND SECTIONS

Teg.teikningar / Dwg. type:	FORM WORK

Flokkur nr.:	Blað nr.:	Næsta bl.nr.:

Kostn.nr.-Cono. / Bún.nr.-Eq.no	
4011	13982

AKS
UB12

Teikn.nr. ISAL /Drw.no. of ISAL	Breyt./Rev.
251300	A

Rio Tinto Alcan
ISAL Álverið í Straumsvík IS-222 Hafnarfjörður Iceland

ISAL Yfirfarið og skráð, dags / ISAL Checked, date

ISAL Samþykkt, dags / ISAL Approval, date