Samþykkt þann
01 OCT 2012
Byggingafulltrúinn í Hafnarfirði
F.h. Sigurður Steinar Jónsson

Nicki Indriðason
Kt. 181144-3949
NI

1/324 SECTION

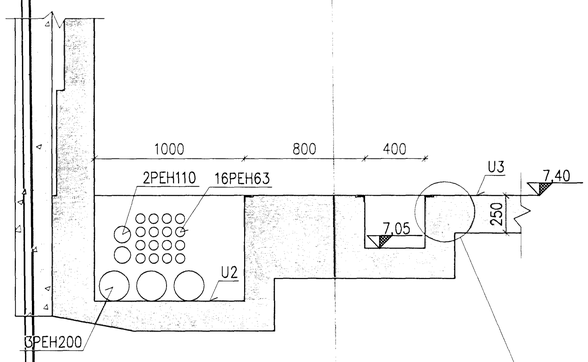

2/324 SECTION

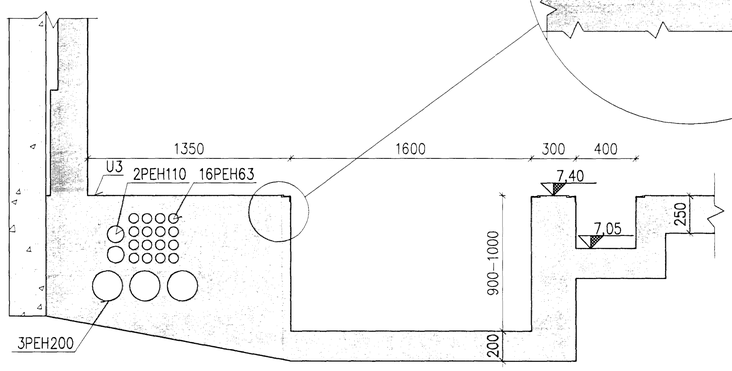

1:5

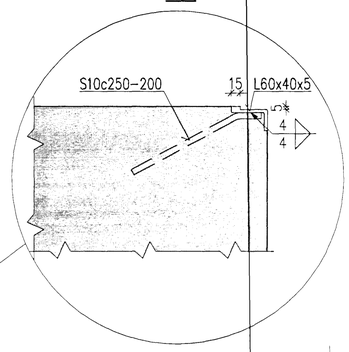

3/324 SECTION

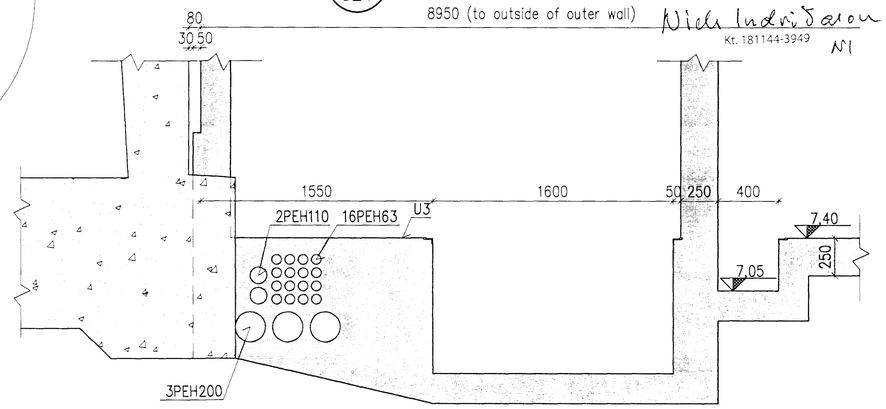

4/324 SECTION

1:5

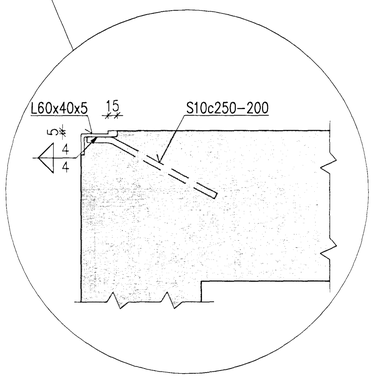

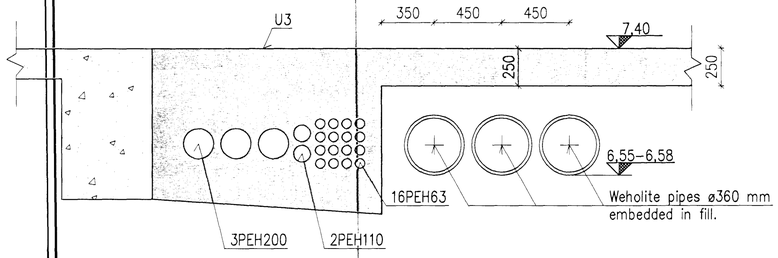

5/324 SECTION

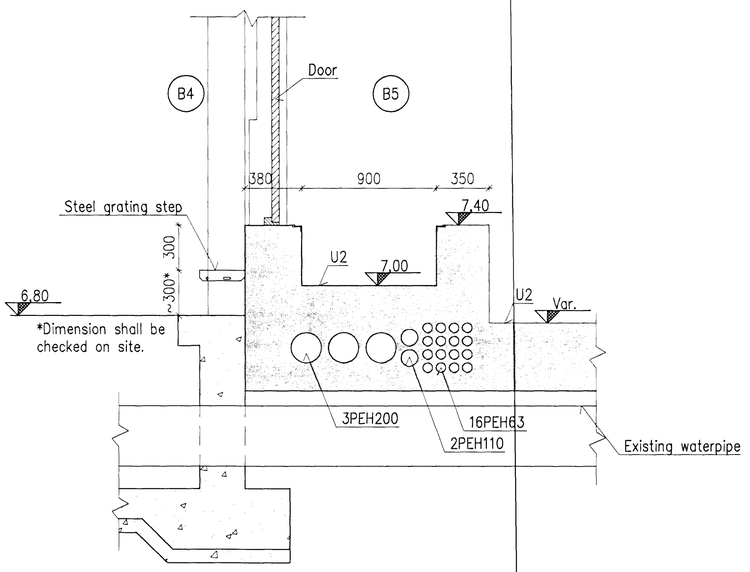

6/324 SECTION

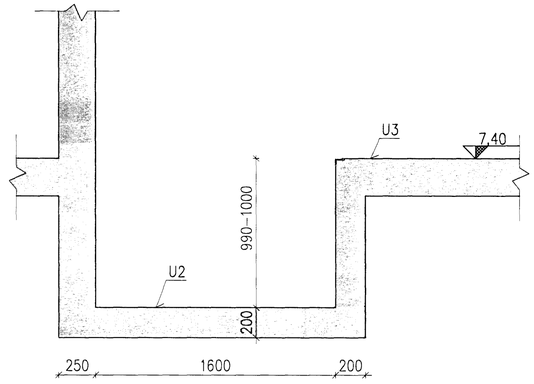

1:5
100 0 100 200 300 400 500 mm

1:20
1000 0 1000 2000 mm

Skýringar
Legend:

C:\IDP\01 IDP\400 – Reduction\410 Substation\Drawings\Civil\IDP-410-CA-015-329.dwg

Útg nr Rev no	Lýsing Description	Dagsetning Date	Hön/Tkn Des/Drw	Yfirf Chkd	Notk heim Suppl Rel	Notk heim ÍSAL Rel
3	Record drawing	2012.09.12	HS	NI		

This drawing is the property of Rio Tinto Alcan Iceland Ltd. and handed out for personal use only. It may neither be copied nor made available to others without permission of Rio Tinto Alcan Iceland Ltd. The receiver is liable for any misuse.

Stærð / Format: A1 Mkv. / Scale: 1:5, 1:20
Dimensions without tolerances according to ISO 2768-1 medium.

HRV HATCH JOINT VENTURE
ÍSAL PRODUCTION UPGRADE

Dagsetning / Date	2011.03.07
Hannað / Designed	HS
Teikn / Drawn	LDB
Verktaki / Supplier	HRV
Teikn.nr.verktaka / Supplier drw.no.	IDP-410-CA-015-329
Samþykkt / Approved	NI
Yfirf / Chkd	NI
Hluti af: / Part of:	

IPU410–RECTIFIER BUILDINGS
B5/S2
SECTIONS 1–6

Flokkur nr.:	Blað nr.:	Næsta blnr.:
Kostn.nr.–Cono. / Bún.nr.–Eq.no	4011	13982
Teg.teikningar / Dwg. type:	FORM WORK	AKS UB12

RioTintoAlcan — ÍSAL, Alcan Iceland Ltd, Straumsvík, IS-222 Hafnarfjordur, Iceland

Teikn.nr. ÍSAL /Drw.no. of ÍSAL	Breyt./Rev.
251283	A

ÍSAL Yfirfarið og skráð, dags / ÍSAL Checked, date
ÍSAL Samþykkt, dags / ÍSAL Approval, date