


STEYPA C25/30-19-S2-Ae

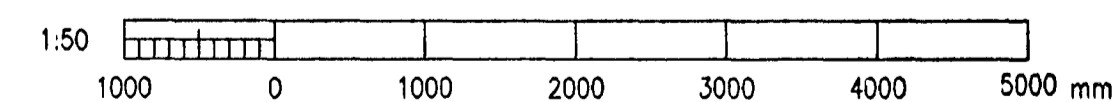

Skýringar:
Explanations:

J:\[99-1xx\]99110\jordsk\Annex\ANN-28104-107.DWG

Breyt. Rev.	Breyting Revision	Dags. Date	Samb. Approved	Notk. heim. Released
B	REYNDARTEIKNING	16.09.2003	SE	SVS
A	MERKINGAR OFL.	31.05.2002	SE	SVS

This drawing is the property of the Alcan Iceland Ltd. and handed out for personal use only. It may neither be copied nor made available to others without permission of the Alcan Iceland Ltd. The receiver is liable for any misuse.

Fjöldi stykja / Number of pieces	Hútur / Object	Atriði / Item	Efni / Material	Þyngd / Weight	Ístærð / Total length	Athugasemdir / Remarks
IV III II I	Steypskáli. Mhl. 12					
	Annex, styrking, stækkun					
	Grunnm. meðan við hæð 6,85, hl. 2/3					
	VST					
	ALCAN PRIMARY METAL EUROPE					
	ISAL					
	IS-222 Hafnarforður					

VST Verkfæratölu Sigurðar Þorodssonar hf.

Tilteikningar nr. ISAL Ref. drawing no. of ISAL

Samsetningartekningar nr. ISAL Assembly drawing no. of ISAL

Teknað / Drawn

Yfirfarið / Checked

Staðfesting / Approved

Útgefið / Released

Skilríki / Scale

1:50

6010 1227

99.110-28.105

166756 B

03.09.2001 SVS