


Samþykkt þann
02. Okt. 2003
Byggingafrúnn í Hafnarfirði
F.h. Sigurbjartur Halldórsson

Samþykkt þann
02. Okt. 2003
Byggingafrúnn í Hafnarfirði
F.h. Sigurbjartur Halldórsson

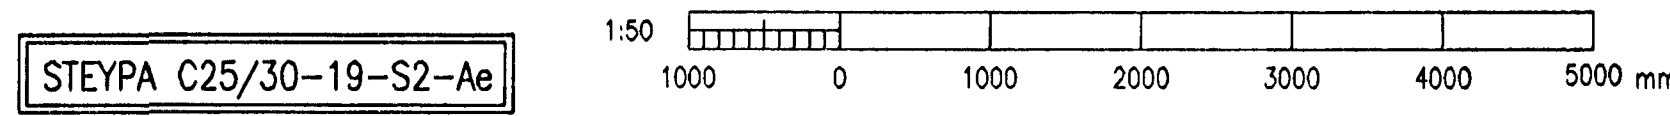

STEYPA C25/30-19-S2-Ae

Skýringar:
Explanations:

J:\99-1xx\99110\Jardsk\Annex\ANN-28104-107.DWG

B	REYNDARTEKNING	16.09.2003	SE	SVS	
A	MERKINGAR OFL	31.05.2002	SE	SVS	
Breyt. Rev.	Breyting / Revision	Dagur / Date	Samb. / Approved	Nafn heimt. / Released	
Tilteikningar nr. ISAL / Refdrawing no. of ISAL		Samsetningartekningar nr. ISAL / Assembly drawing no. of ISAL			

This drawing is the property of the Alcan Iceland Ltd. and handed out for personal use only. It may neither be copied nor made available to others without permission of the Alcan Iceland Ltd. The receiver is liable for any misuse.

Fjöldi stykkja / Number of pieces	Hljur / Object	Alnúmer / Item	Efni / Material	sg.stk / Weight	totalt / held / (kg) byggt	Athugasemdir / Remarks
IV III II I	Steypuskáli. Mhl. 12 Annex, styrking, stækkun Grunn. neðan við hæð 6,85, hl. 1/3					
Stærð / Format: A1 Mæ. / Scale: 1:50 Kostnaður / Cost: 6010 Skýringar / Explanations: 1227 AKS no.						
Tilteikning / Supplier: VST		Mikill / Checked: NI		Tilteikning / Date: 28.05.2001		Tekjur / Drawn: SVS
ALCAN PRIMARY METAL EUROPE		ISAL		IS-222 Hafnarfjörður		166755
Tilteikning / Drawn: SVS		Yfirfarið og skráð / Checked and released: GUR		Dagur / Date: 03.09.2001		166755

