


SKÝRINGAR:

- Skástrikaðar undirstöður skulu standa á hreinsuðum klappargrunni. Samþykkt þann 02.08.2003
- 3.35_BK Töknar hæð á neðri brún Byggingafultrúinn í Hafnarhöfði F.h. Sigurbjartur Halldórsson

Undirstöður: Sjá snið á teikn. 121, 126 og 128

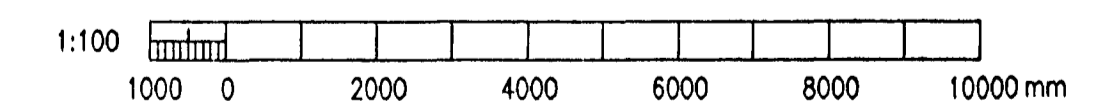

Skýringar:
Explanations:

J:\99-1xx\99110\Jardsk\Annex\ANN-28102-103.DWG

VST Verktæmistofa
Sigurður Thordósson hf.
Kirkjublaugavörðungur 108, Reykjavík, Sími 588 5000 Fax 588 5010

Breyt. / Rev.	Breyting / Revision	Dagur / Date	Samþ. / Approved	Notk. heimil. / Released
B	REYNDARTEIKNING	16.09.2003	SE	SvS
A	MERKINGAR OG FL.	31.05.2002	SE	SvS

This drawing is the property of the Alcan Iceland Ltd. and handed out for personal use only. It may neither be copied nor made available to others without permission of the Alcan Iceland Ltd. The receiver is liable for any misuse.

Fjöldi stykja / Number of pieces	Hlutur / Object	Alnám / Item	Efni / Material	Þyngd / Weight (kg)	Ístætt heild / Total weight	Alhugusemdir / Remarks
IV III II I	Steypuskáli. Mhl.12					
	Annex, styrking, stækun Jarðvinna, grunnmynd, hæðir					
	VST					
	ALCAN PRIMARY METAL EUROPE					
	ISAL					
	IS-222 Hafnarfordur					