Format A1 (841x594 mm) is 20 mm outside of this frame

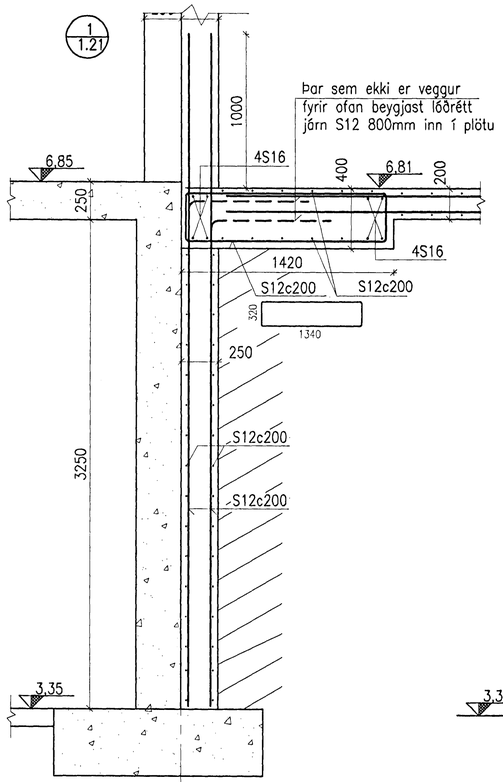

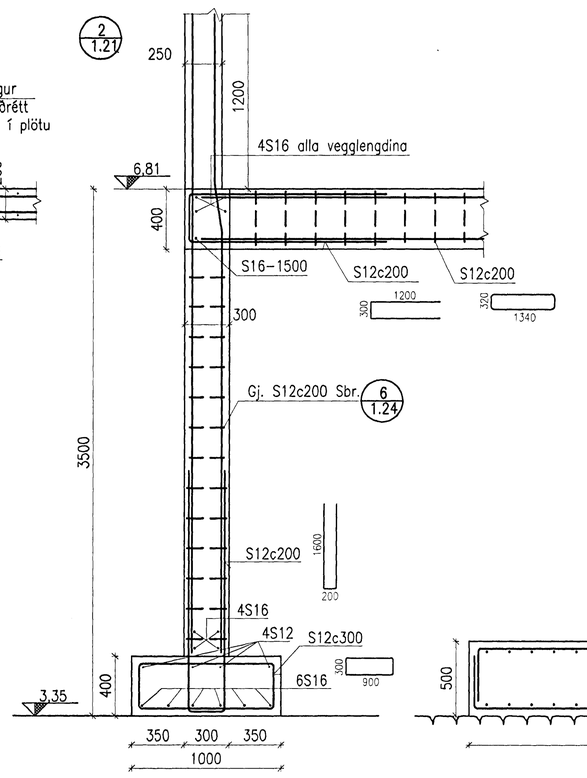

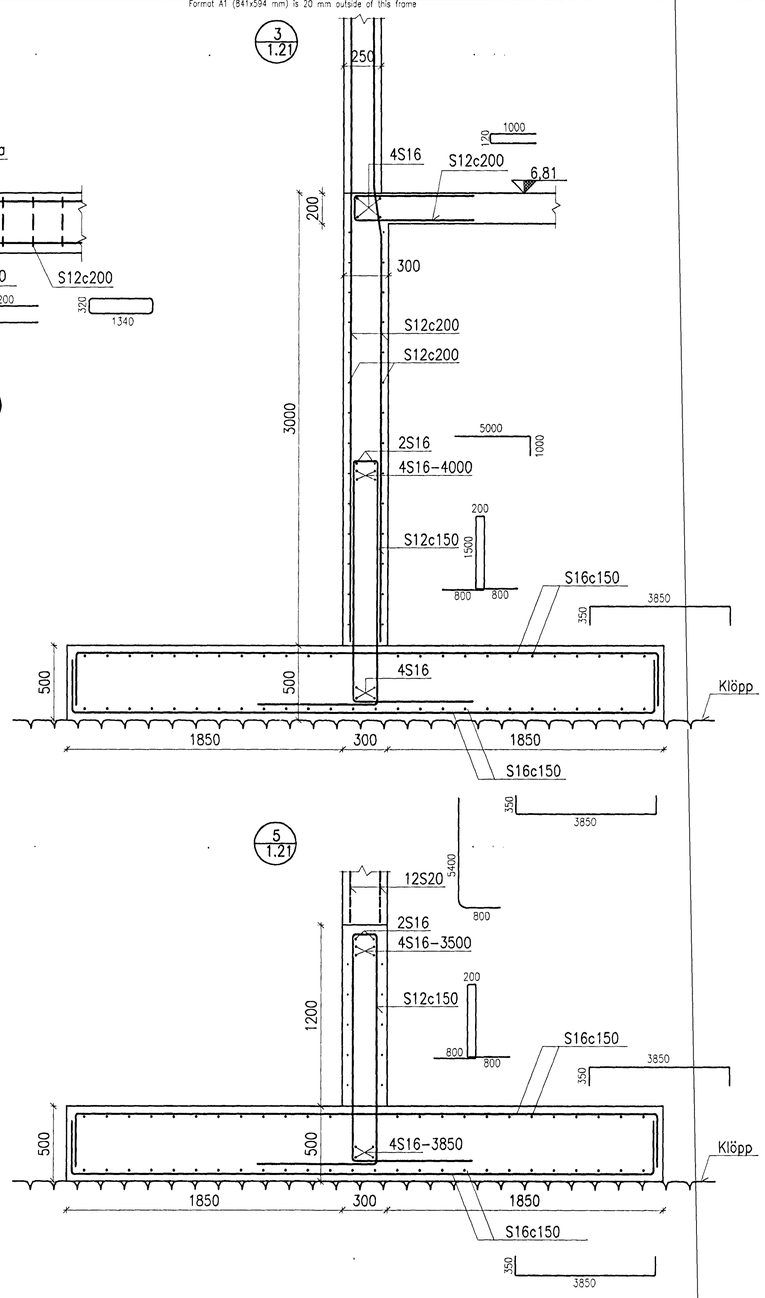

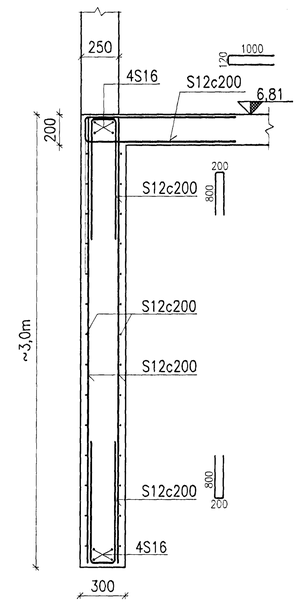

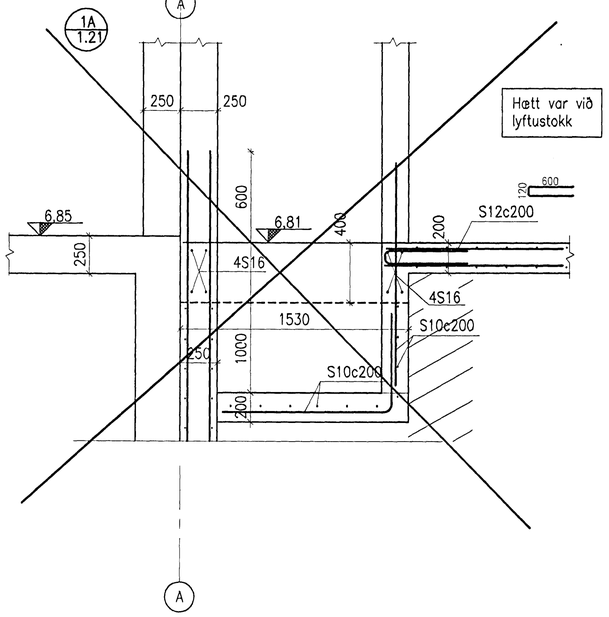

Sampykkt þann
02 OKT. 2003
Byggingafulltrúinn í Hafnarfirði
Eh. Sigurbjartur Halldórsson

1:20
1000 0 1000 2000 mm

Skýringar:
Explanations:

J:\[99-1xx]\99110\Jardsk\Annex\ANN-28122-124.DWG

Breyt. Rev.	Breyting Revision	Dags. Date	Samb. Approved	Notk. heimil Released
B	REYNDARTEIKNING	16.09.2003	SE	SvS
A	MERKINGAR OFL.	31.05.2002	SE	SVS

Tilv.teikningar nr. ÍSAL
Ref.drawing no. of ÍSAL

Samsetn.teikningar nr. ÍSAL
Assembly drawing no. of ÍSAL

VST Verkfræðistofa Sigurðar Thoroddsen hf.
Ármúla 4, 108 Reykjavík Sími 569 3000 Fax 569 3010

This drawing is the property of the Alcan Iceland Ltd. and handed out for personal use only. It may neither be copied nor made available to others without permission of the Alcan Iceland Ltd. The receiver is liable for any misuse.

Fjöldi stykkja Number of pieces: IV III II I

Hlutur Object	Atriði Item	Efni Material	eq.stk Weight	totalt heild (kg) þyngd	Athugasemdir Remarks

Steypuskáli. Mhl. 12

Annex, styrking, stækkun

Úbyggingar, veggir, lóðrétt snið

Verktaki / Supplier: VST

Stærð Format A1 | Mkv. Scale 1:20

Kostn.nr.-tákn.nr / CCno.-Eq.no. 6010 1227

AKS no.

Teikn.nr. verktaka / Drw.no. of suppl. | Breyt./Rev. 99.110-28.123

Teiknað Drawn	SE/SAA 28.05.2001	Yfirfarið Checked	NI 28.05.2001	Sampykkt Approved

ALCAN PRIMARY METAL EUROPE
ÍSAL
Alcan Iceland Ltd
Straumsvík
IS-222 Hafnarfjordur

Drw.no. of ÍSAL / Teikn.nr. ÍSAL: 166773 | Breyt./Rev.: B

Teiknað Drawn		Yfirfarið og skráð Checked and filed	03.09.2001 GUR	Notkun heimiluð Released	03.09.2001 SvS