

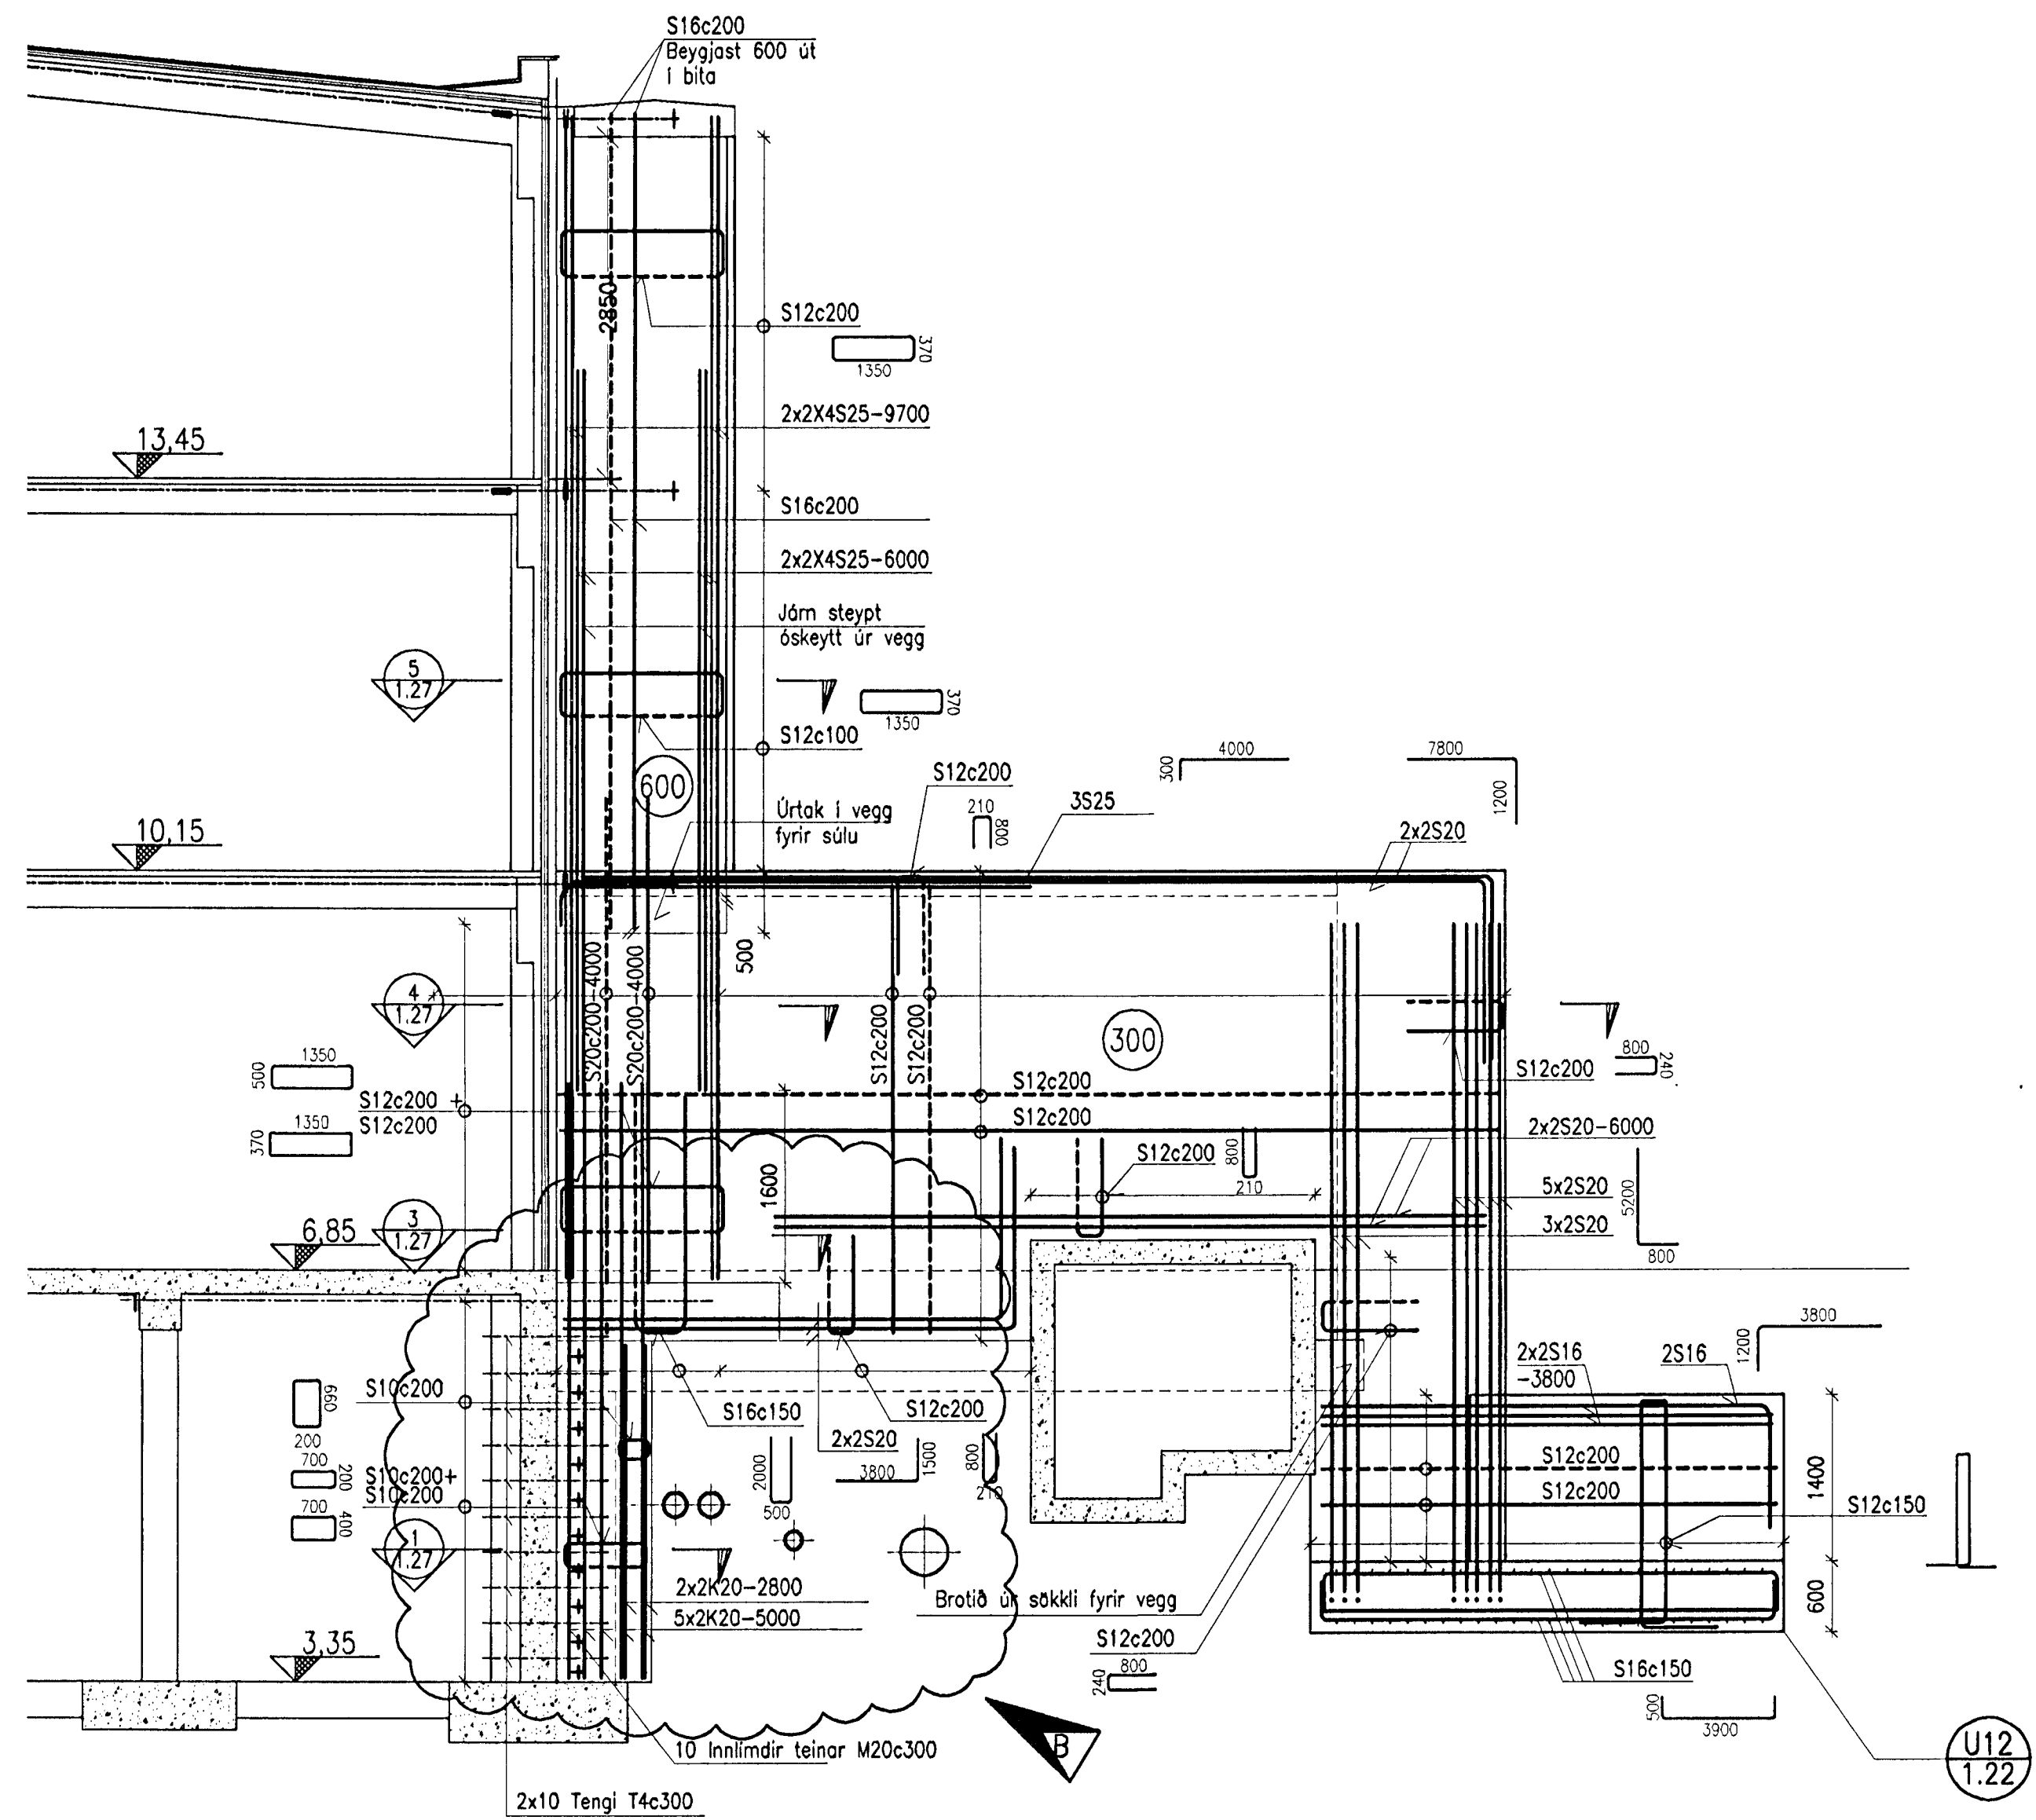


C
1.05 1.09 OG 1.13

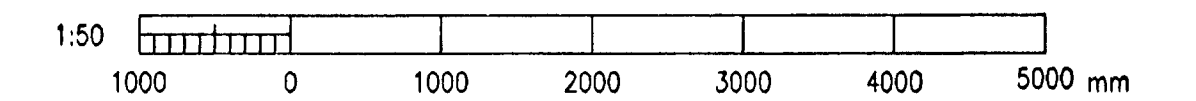

D
1.05 1.09 OG 1.13

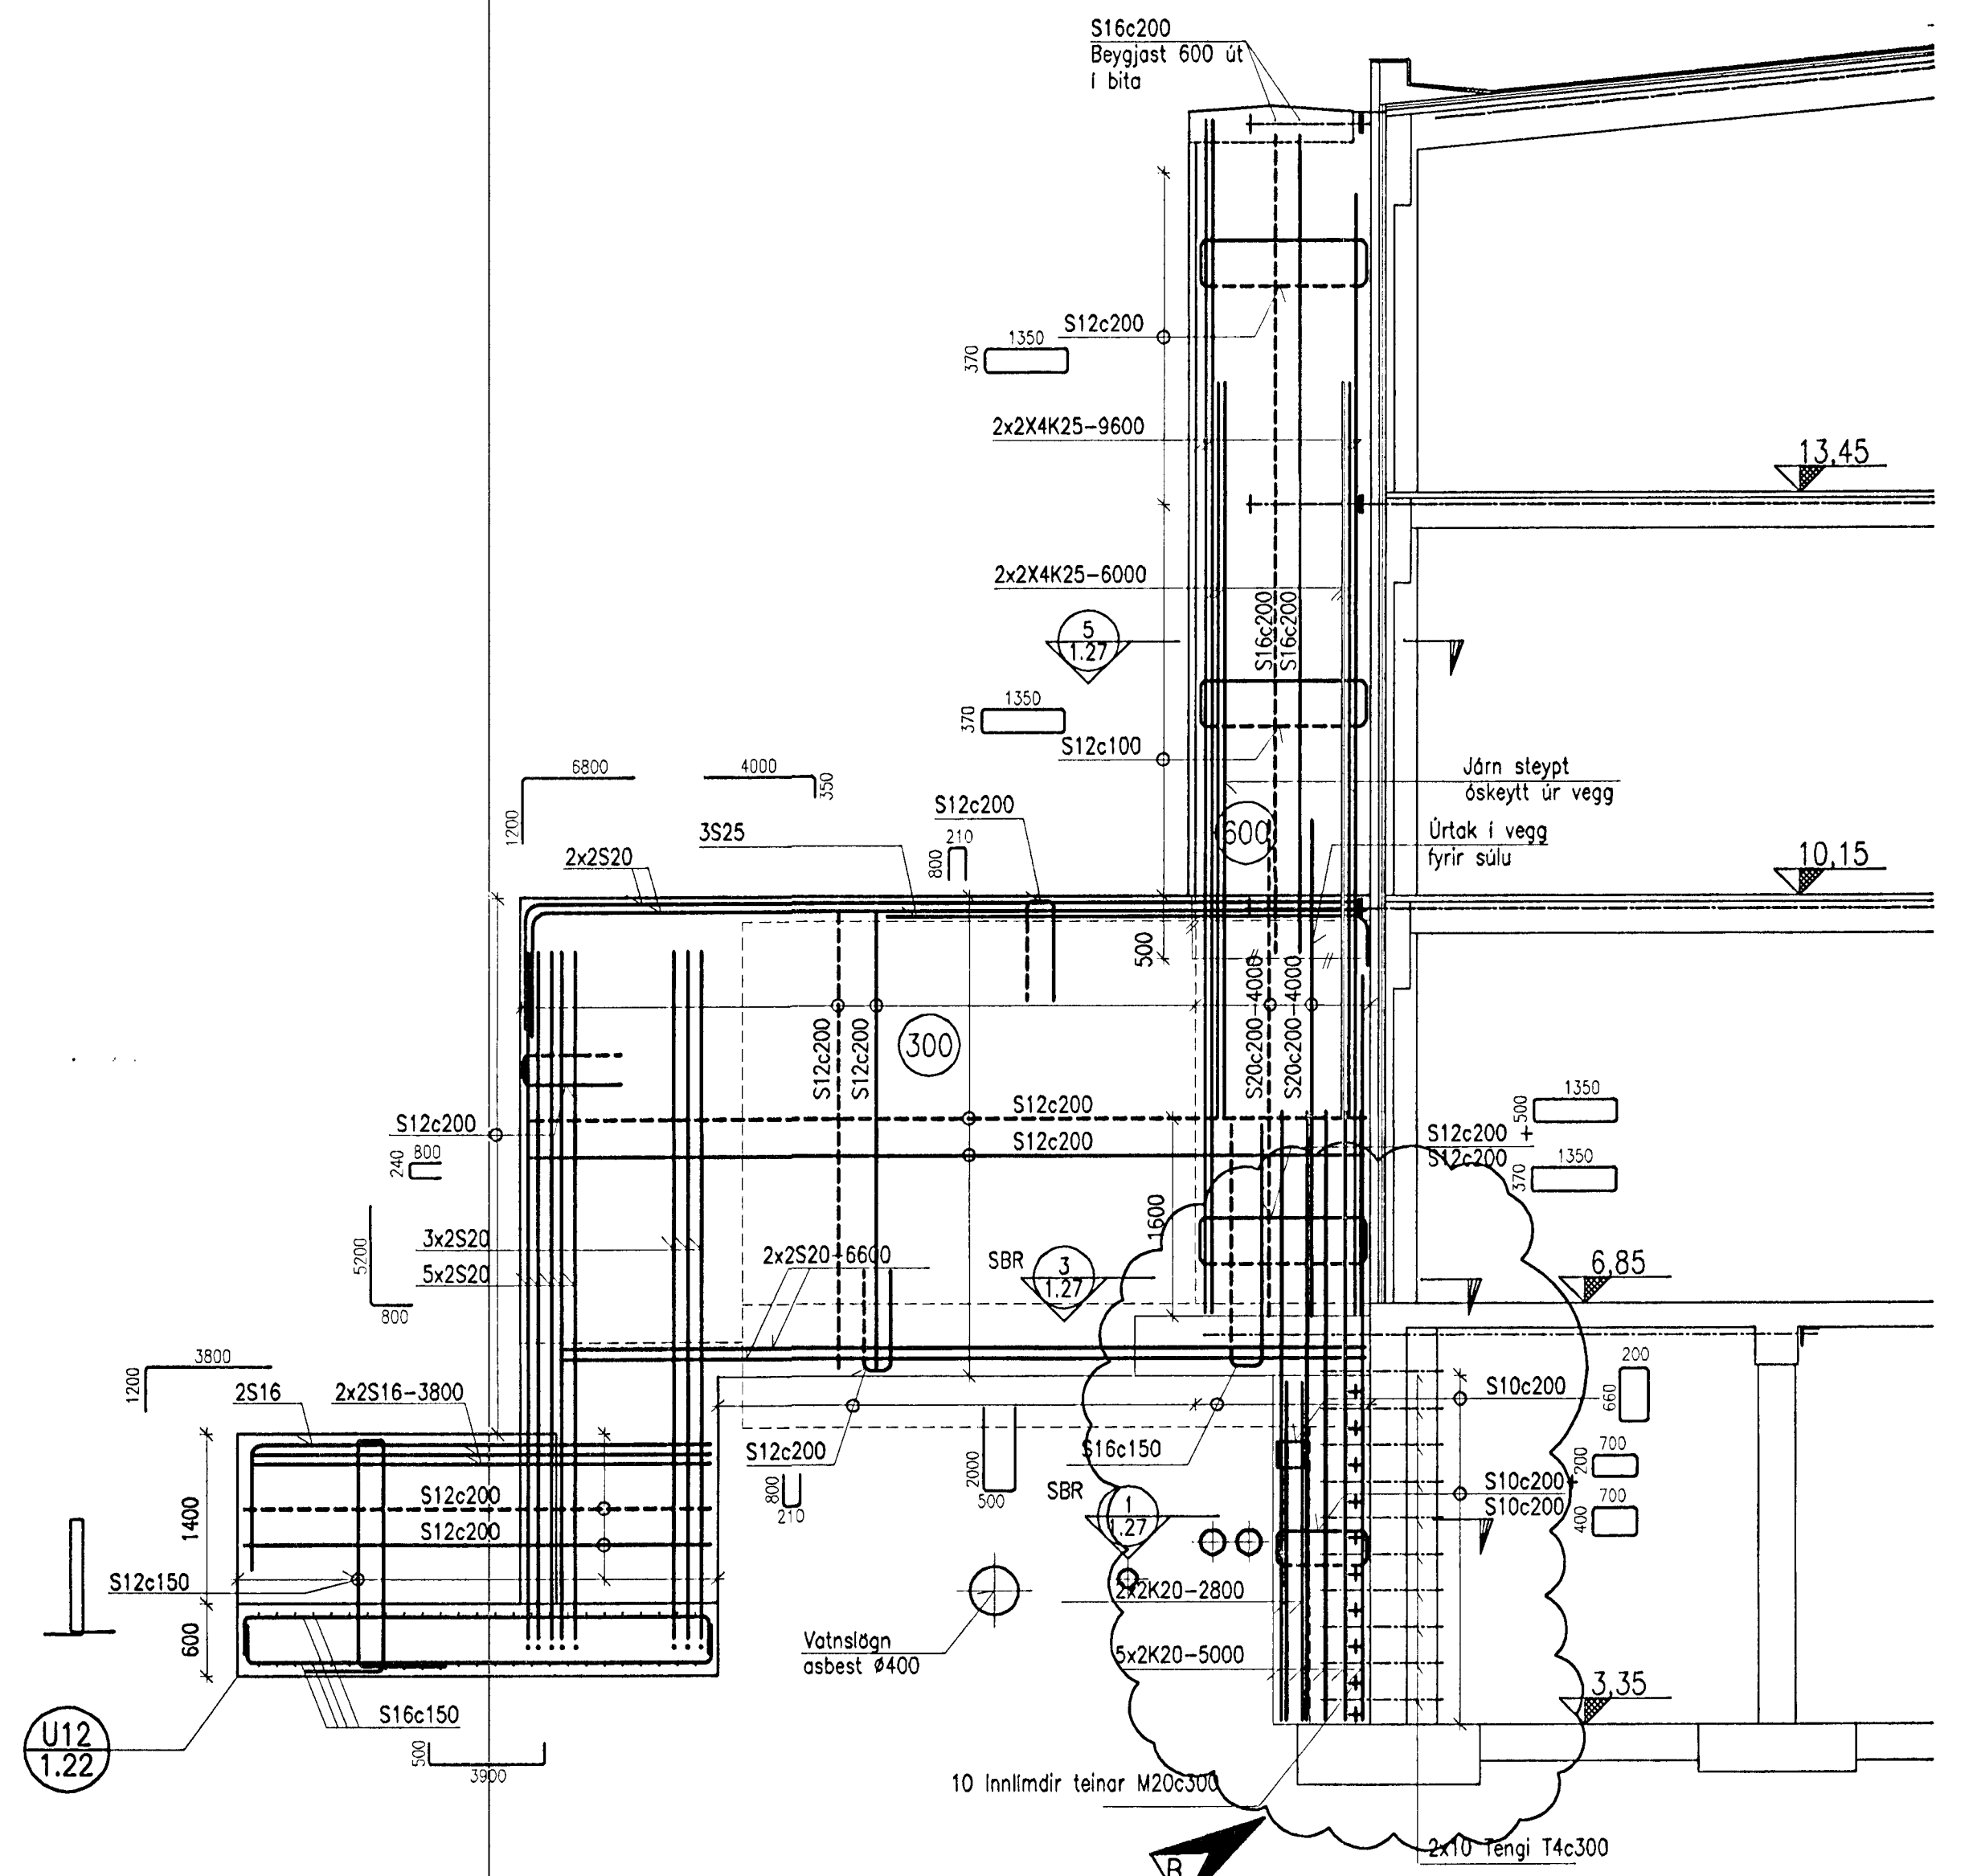

Sampykkt þann
2. OKT. 2002
Byggingafrulltrúinn í Hafnarfordur
Fh. Sigurbjartur Halldórsson

Skýringar:
Explanations:

J:\99-1xx\99110\Jardski\Annex\ANN-28126-127.DWG

This drawing is the property of the Alcan Iceland Ltd. and handed out for personal use only. It may neither be copied nor made available to others without permission of the Alcan Iceland Ltd. The receiver is liable for any misuse.

Blátt Number of pieces	Hlutur Object	Altri Item	Efni Material	Eq.stk Weight	Ítalaf. Total	Althugsamerki Remarks
IV	Steypskúli. Mhl. 12 Annex, styrking, stækkun Styrktarveggir við þaðhús, ósýnd				1:50	Scale 6010 1227 AKS no.
	Teiknað / Drawn	SE/SA	VST	28.05.2001	28.05.2001	Teiknað / Drawn 99.110-28.126 B
	Prófað / Checked	SE/SA	VST	28.05.2001	28.05.2001	Prófað / Checked 99.110-28.126 B
	Alcan Primary Metal Europe ISAL Alcan Iceland Ltd		IS-222 Hafnarfordur			Alcan Primary Metal Europe ISAL Alcan Iceland Ltd
	166776					166776 B
	03.09.2001					03.09.2001

VST Verkfræðistofa
Sigurðar Thoroddsen hf.

Tvítekningar nr. ISAL
Ref. drawing no. of ISAL

Samsætningartekningar nr. ISAL
Assembly drawing no. of ISAL

03.09.2001